


Block 1

State of Wisconsin)
County of Walworth)

I, Lloyd L. Jensen do hereby certify that
I have surveyed the property hereon described
according to the official records, and that
the plat hereon is a correct representation
of the lot lines and principal lines of the
buildings thereon.

Aug, 1957

Lloyd L. Jensen
Surveyor

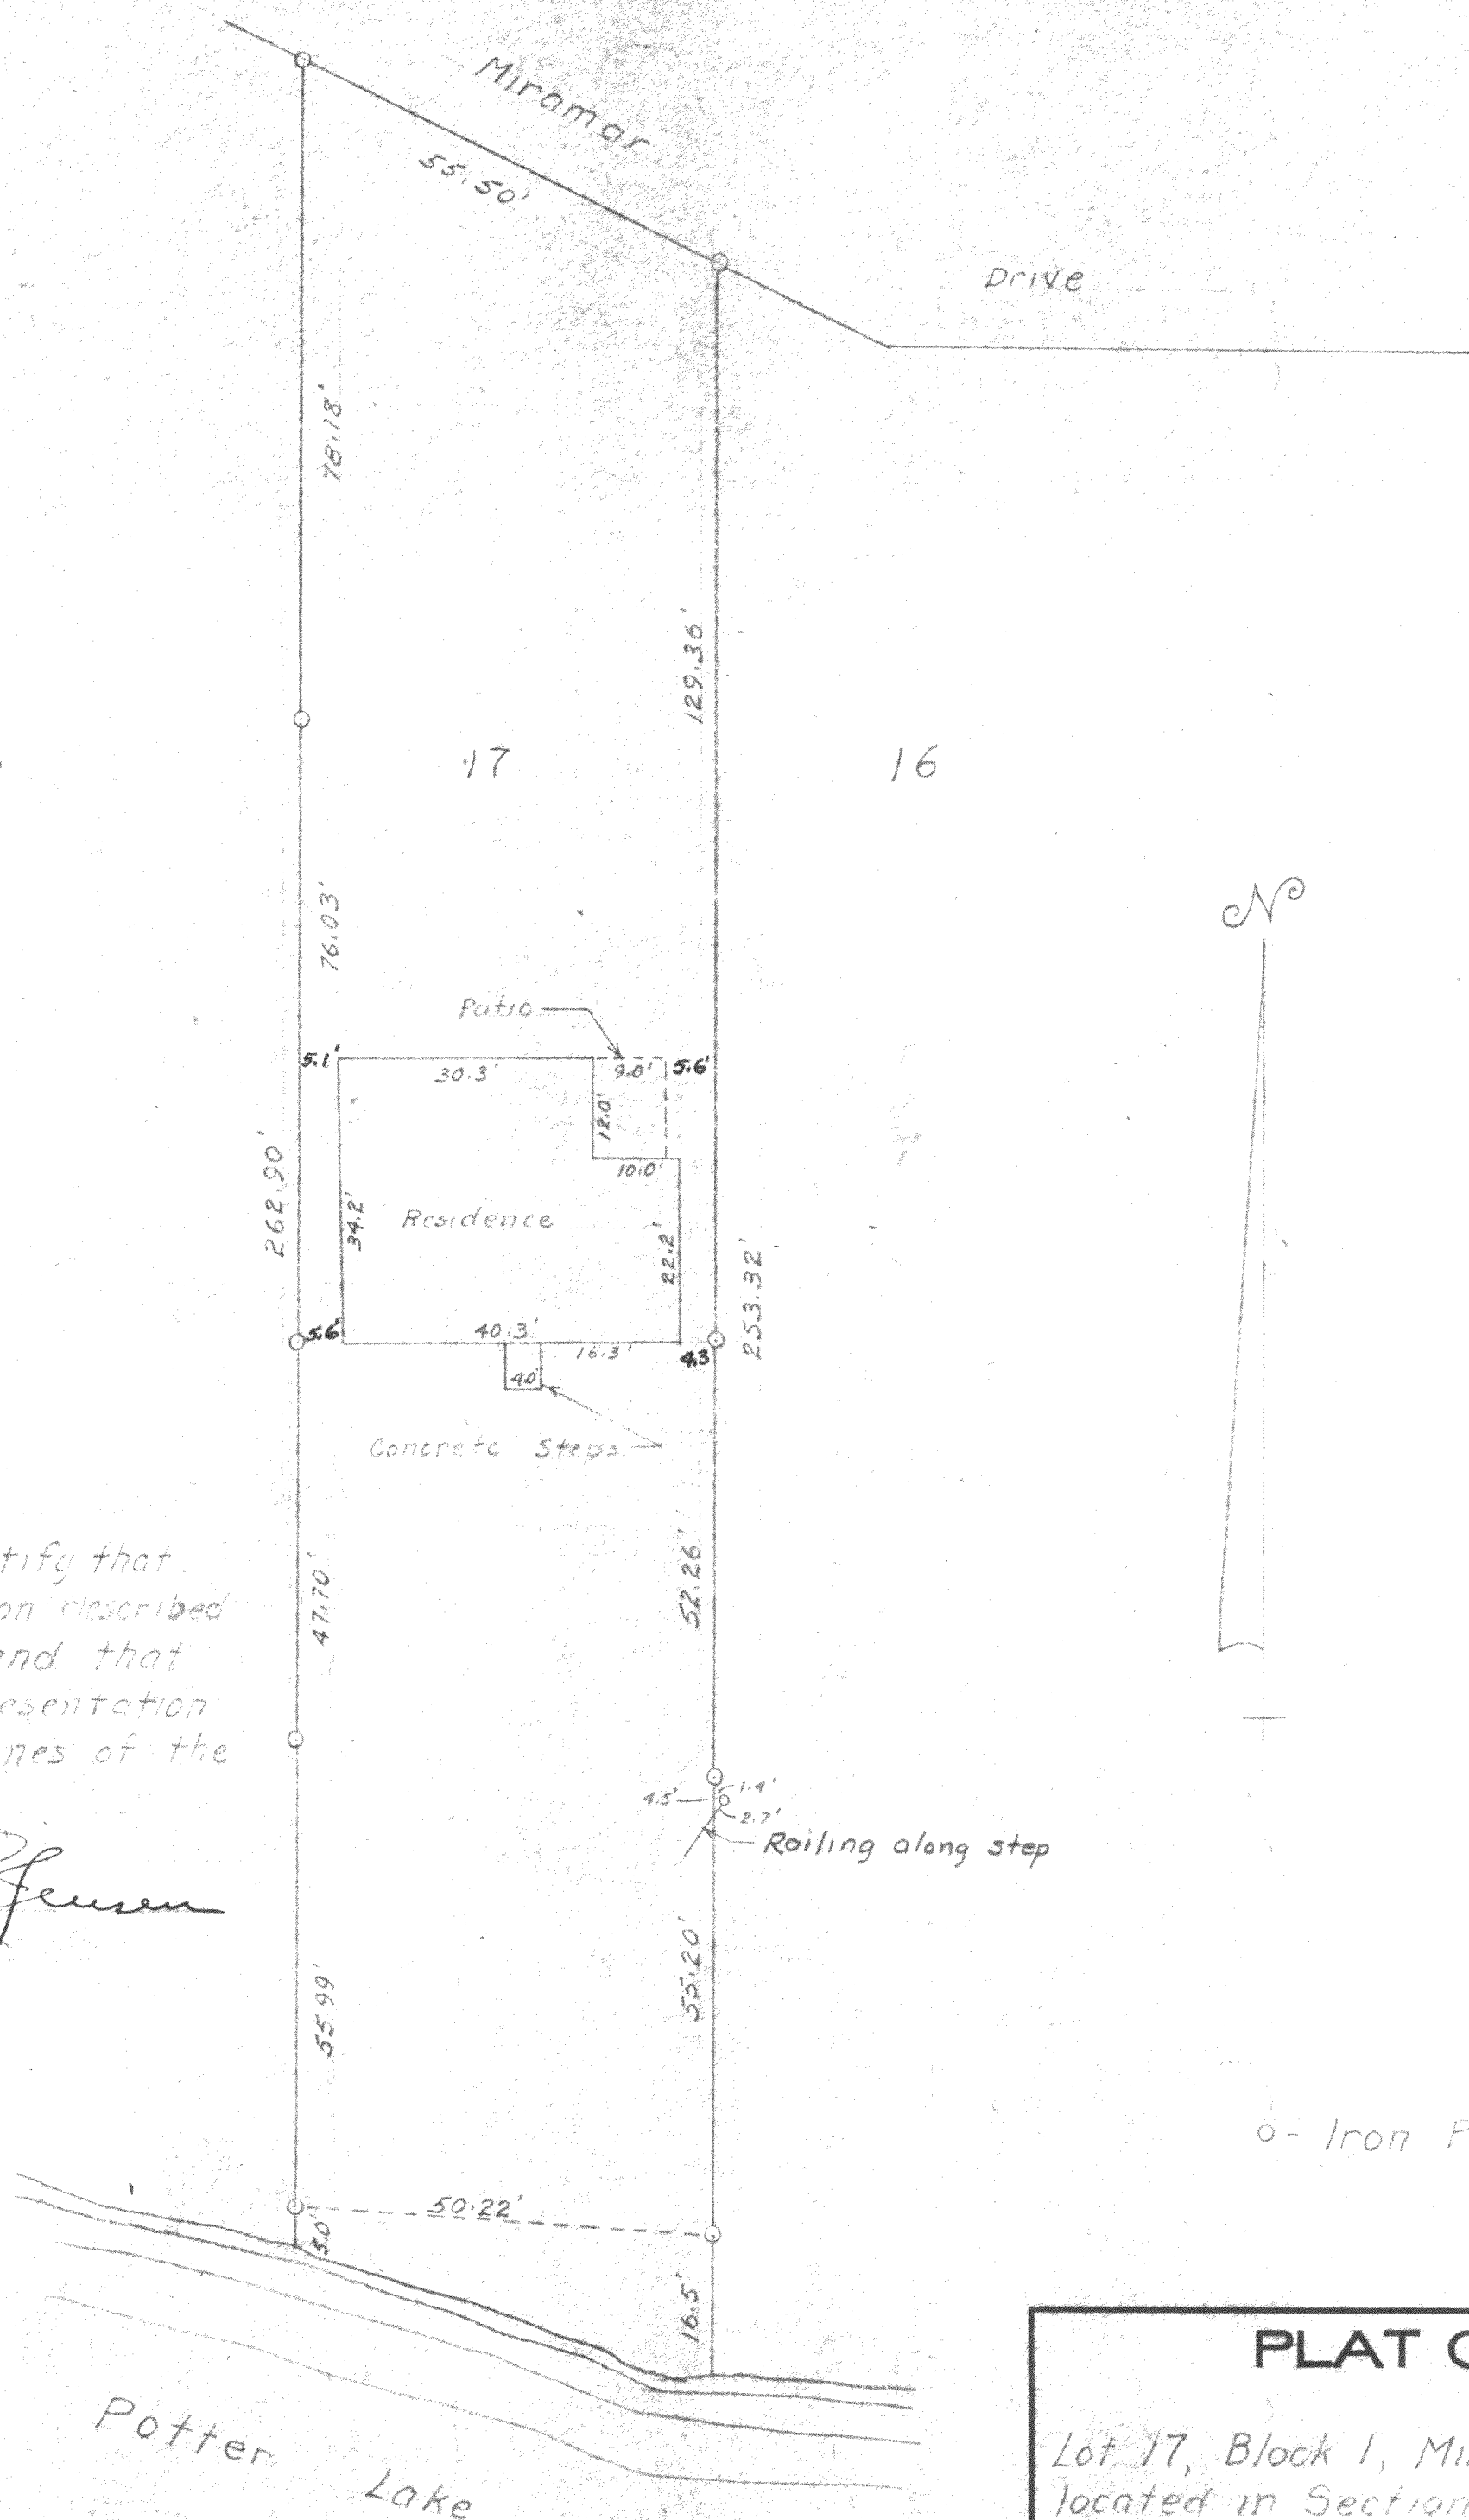

PLAT OF SURVEY OF

Lot 17, Block 1, Miramar Subdivision,
located in Section 10, T4N, R18E,
Walworth County, Wisconsin

Lloyd L. Jensen
SURVEYOR

SCALE 1" = 20'

DATE Aug 1957