


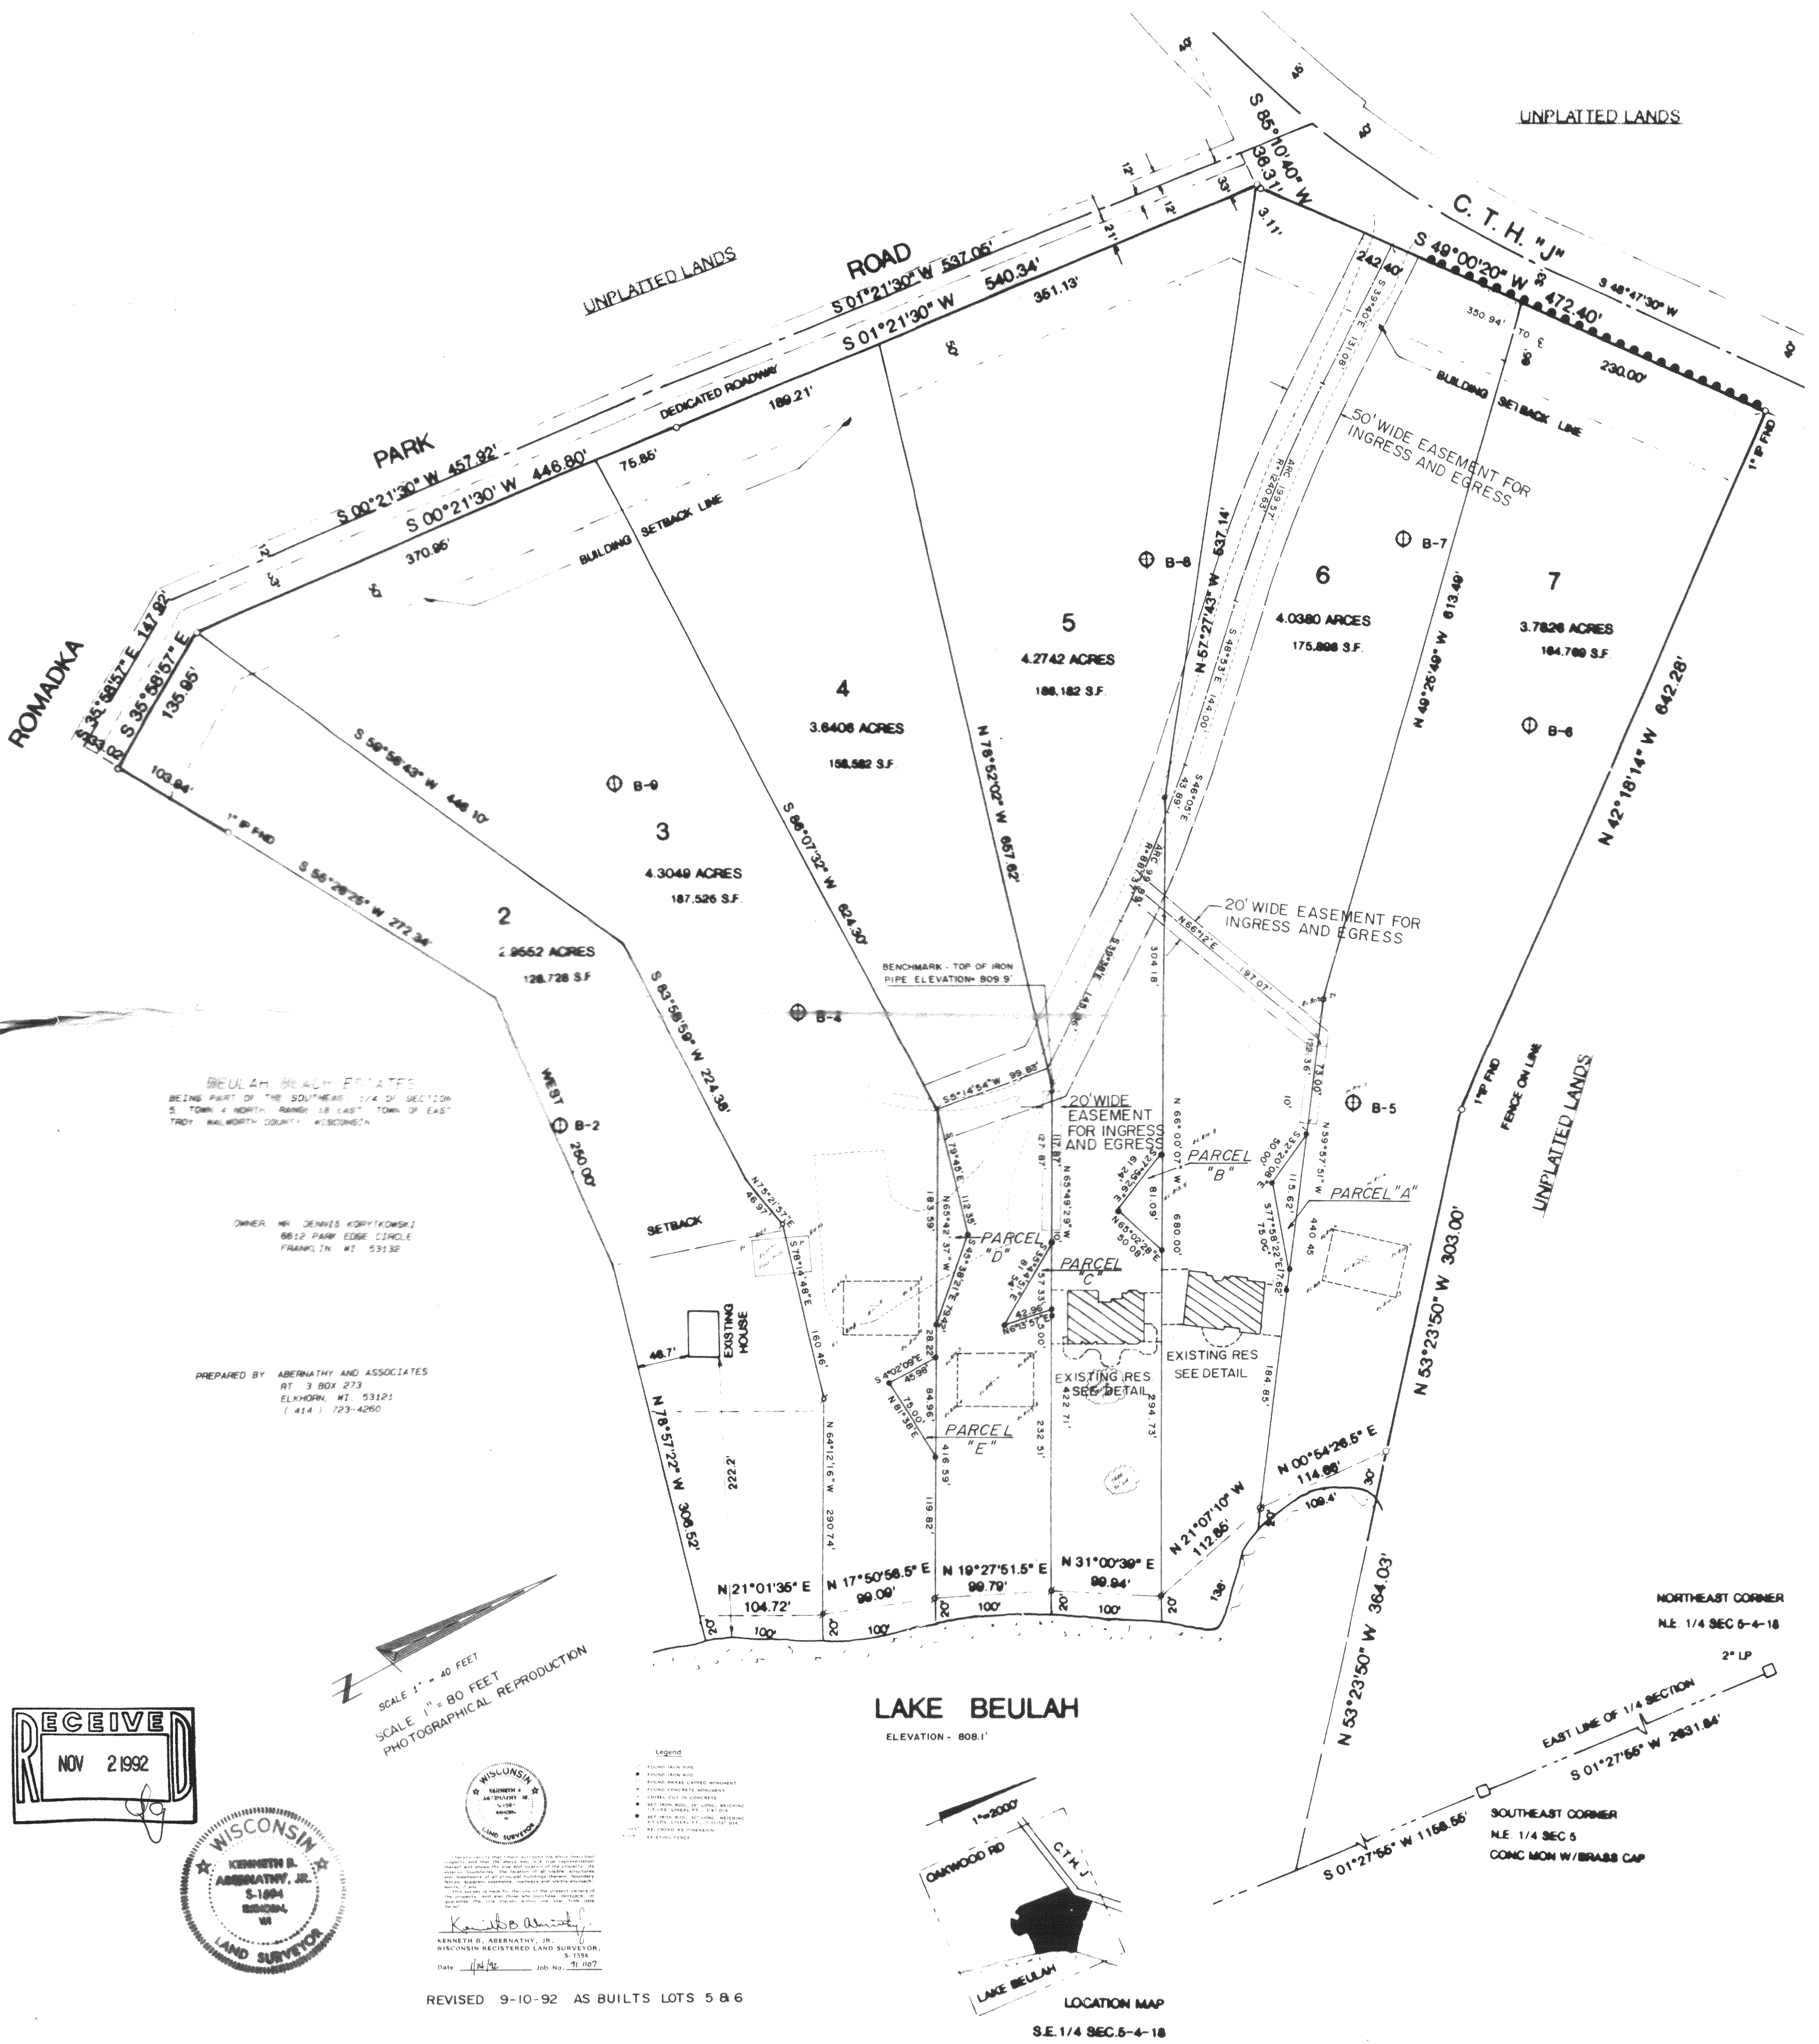

755-2
755-2
