

PLAT OF SURVEY

PART OF LOT 5 EXCEPTION
VOL. 579 P. 281

LOT 5 AND A PORTION OF LOT 4 OF
BEULAH BEACH ESTATES, A SUBDIVISION
LOCATED IN THE SOUTHEAST 1/4 OF
SECTION 5, TOWN 4 NORTH, RANGE 18
EAST, WALWORTH COUNTY, WISCONSIN AS
RECORDED IN CABINET B SLIDE 109 OF
WALWORTH COUNTY PLATS.

OWNER: JAIME NAVARRO
9119 N. WHITE OAK LANE
APT. 212
BAYSIDE, WI. 53217

ORDERED BY: LAYTON STATE BANK
3810 S. 97th ST.
MILWAUKEE, WI. 53229

LOT 6


RESIDENCE
DETAIL

DECK

LOT 5

Legend


- FOUND IRON PIPE
- FOUND IRON ROD
- FOUND BRASS CAPPED MONUMENT
- FOUND CONCRETE MONUMENT
- CHISEL CUT IN CONCRETE
- SET IRON ROD, 24" LONG, WEIGHING
1.5 LBS./LINEAL FT., 3/4" DIA.
- SET IRON ROD, 30" LONG, WEIGHING
4.5 LBS./LINEAL FT., 1-11/16" DIA.
- (xx) RECORDED AS DIMENSION
- X-X- EXISTING FENCE

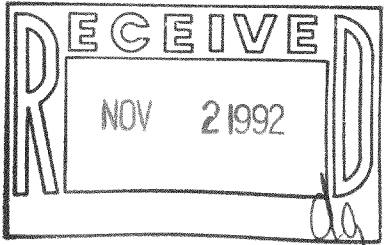

SCALE: 1" = 10 FEET

"I hereby certify that I have surveyed the above described
property and that the above map is a true representation
thereof and shows the size and location of the property, its
exterior boundaries, the location of all visible structures and
dimensions of all principal buildings thereon, boundary
fences, apparent easements, roadways and visible encroach-
ments, if any."
"This survey is made for the use of the present owners of
the property, and also those who purchase, mortgage, or
guarantee the title thereto within one year from date
hereof."

Kenneth B. Abernathy Jr.
KENNETH B. ABERNATHY, JR.
WISCONSIN REGISTERED LAND SURVEYOR,
S-1594
Date: 9/10/92 Job No. 91.1107
92.806

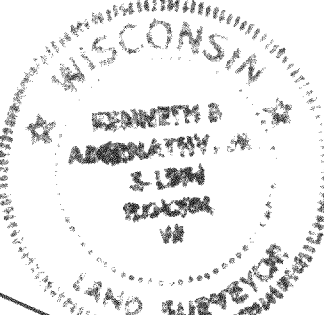

LOT 4

SHEET 2 OF 2 SHEETS