


PLAT OF SURVEY

LOT 36 BLOCK NO. 1
WILMERS GROVE BEACH SUBDIVISION
LOCATED IN THE EAST 1/2 OF
SEC. 18, T. 1 N., R. 18 E.,
WALWORTH COUNTY, WISCONSIN

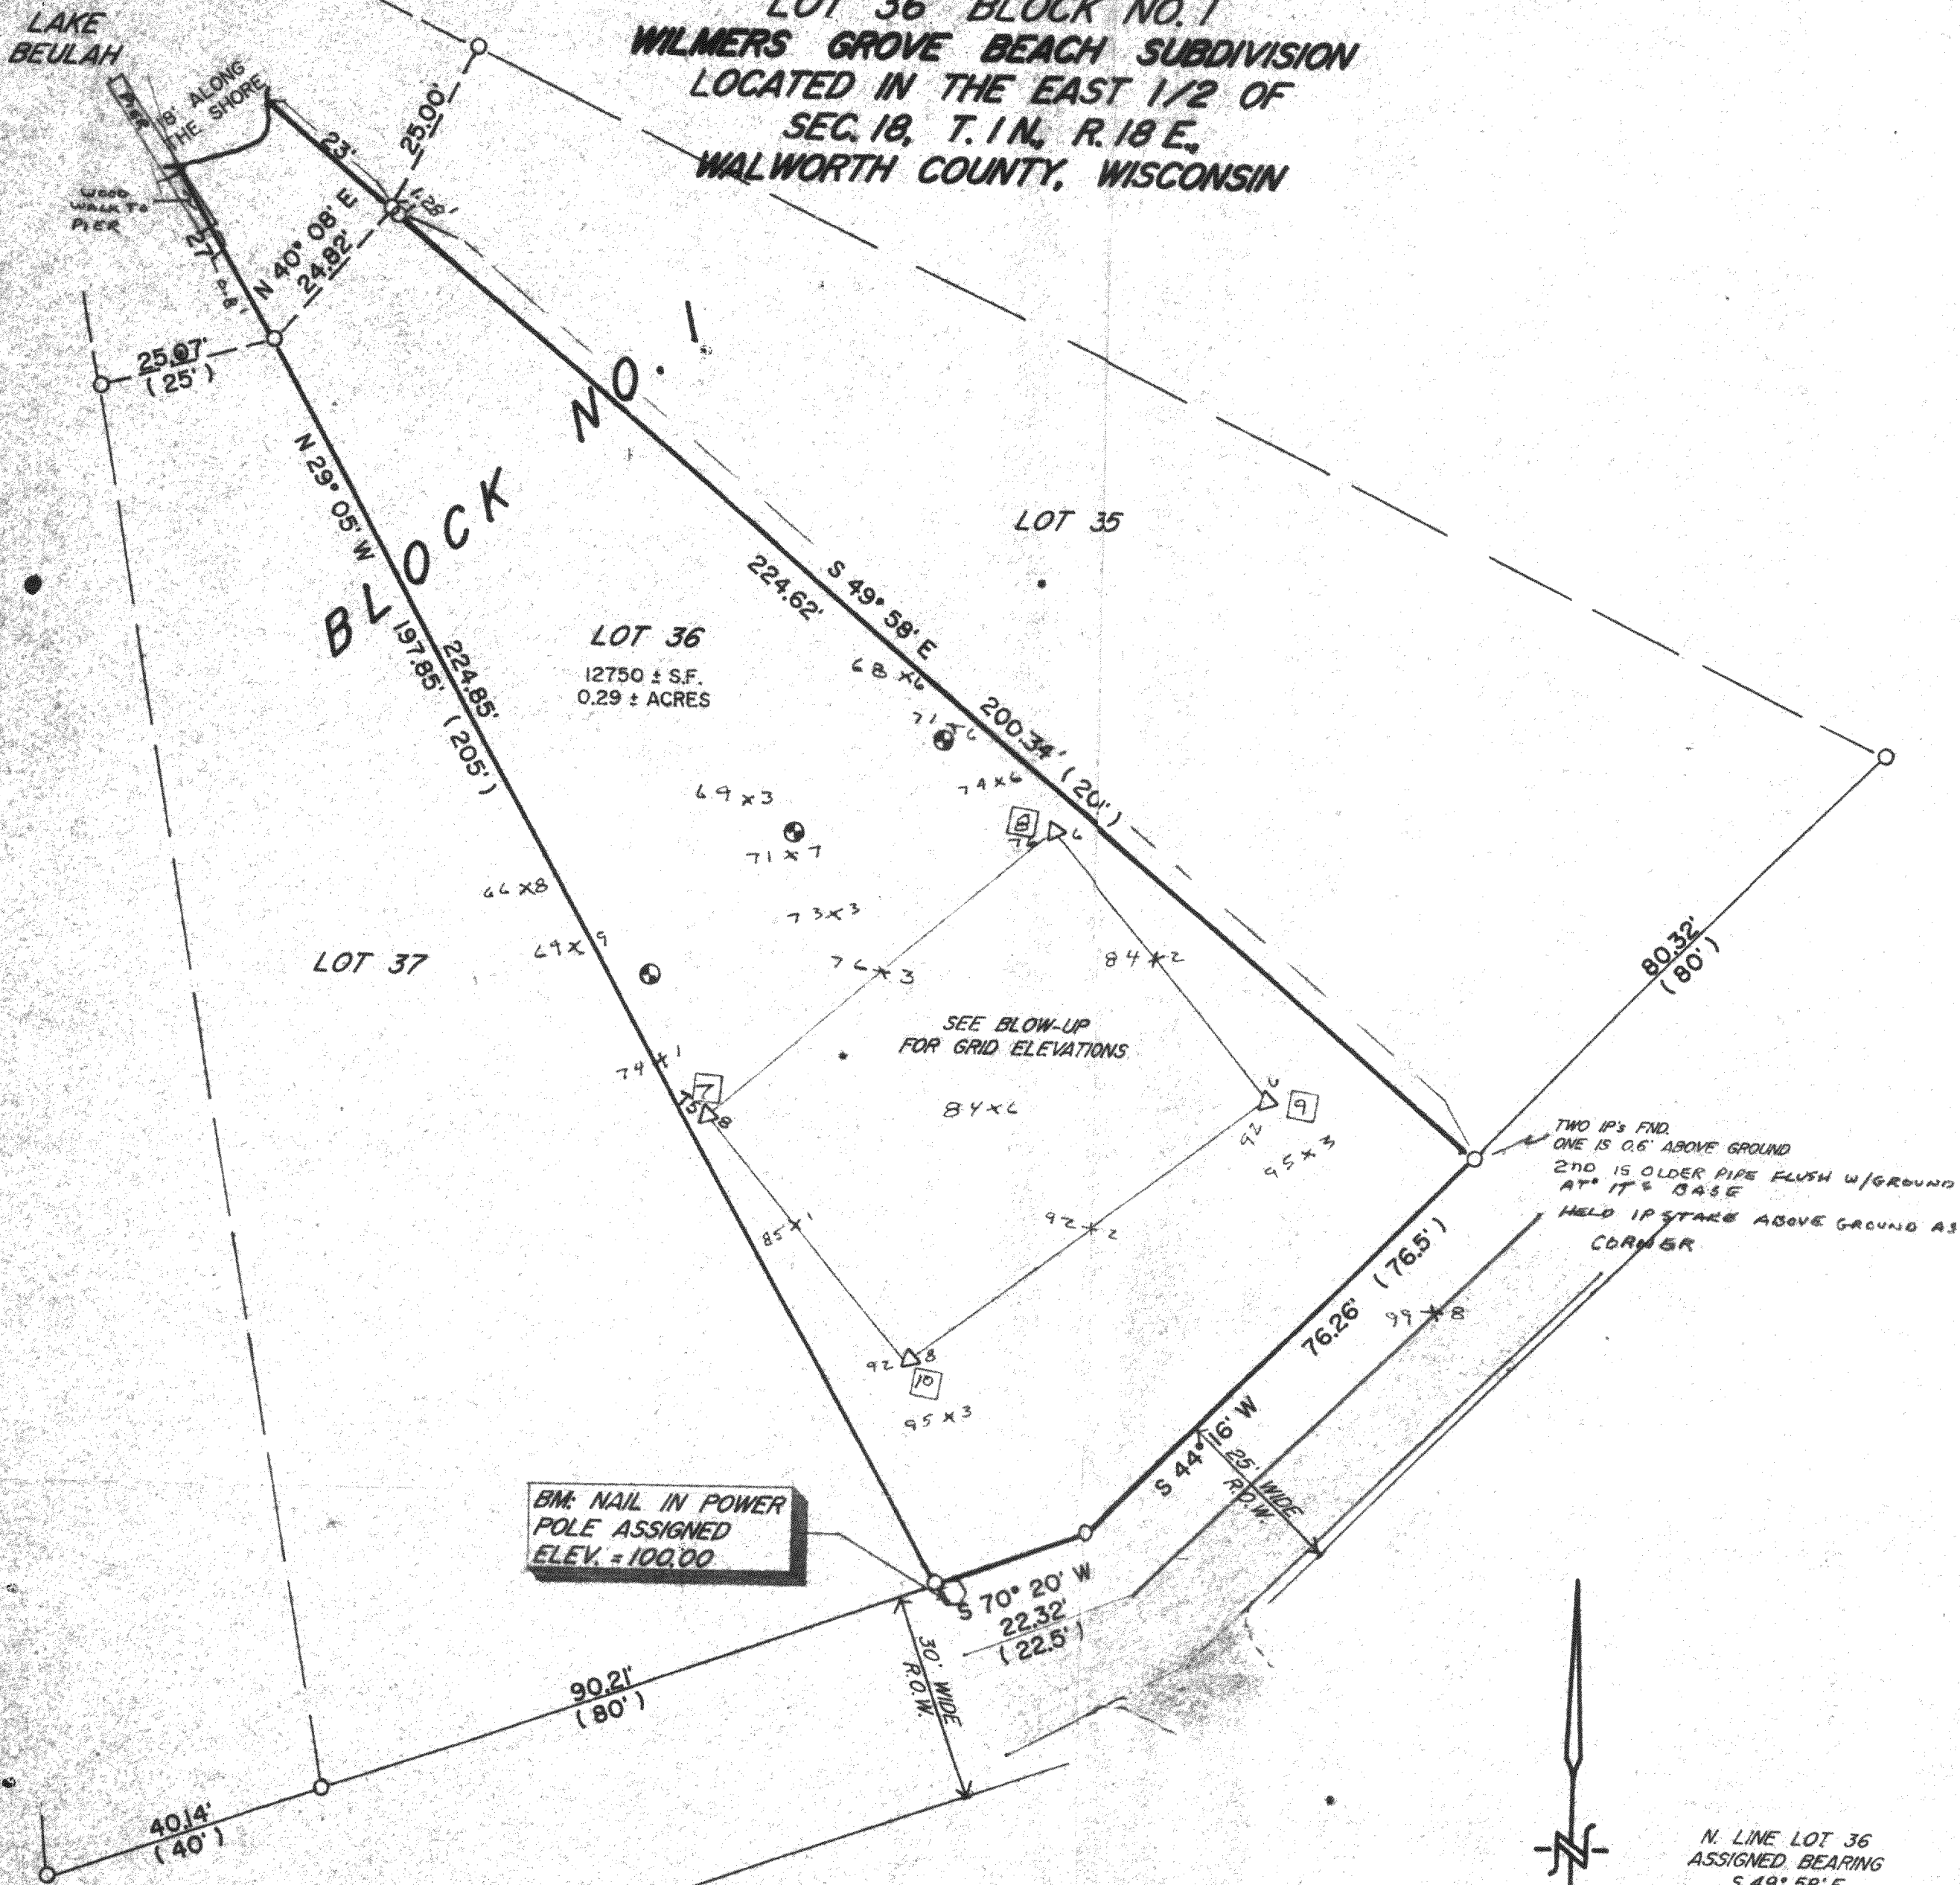

PLAT OF SURVEY
LOT 36 BLOCK NO. 1
WILMERS GROVE BEACH SUBDIVISION
LOCATED IN THE EAST 1/2 OF
SEC. 18, T. 1 N., R. 18 E.,
WALWORTH COUNTY, WISCONSIN


FOR: RON BURKE
5736 ALVIN HOWELL ROAD
BURLINGTON, WI 53105

FARRIS, HANSEN & ASSOCIATES, INC.
Engineering, Architecture, Surveying
7 Ridgway Court P.O. Box 437
ELKHORN, WISCONSIN 53121
Office: (414) 723-2098
Fax: (414) 723-5886


REVISIONS

NOTE: COPIES OF THIS MAP TO WHICH THE FOLLOWING CERTIFICATE WILL APPLY ARE BLUE LINE PRINTS SHOWN SURVEYOR'S ORIGINAL SEAL AND SIGNATURE IN BLACK INK. COPIES BY ANY OTHER MEANS MAY HAVE ALTERATIONS WHICH DO NOT REPRESENT THE SURVEYOR'S WORK PRODUCT.

I HEREBY CERTIFY THAT THE ABOVE DESCRIBED PROPERTY HAS BEEN SURVEYED UNDER MY DIRECTION AND THAT THE ABOVE MAP IS A TRUE REPRESENTATION THEREOF AND SHOWS THE SIZE AND LOCATION OF THE PROPERTY AND ITS EXTERIOR BOUNDARIES. THIS SURVEY IS MADE FOR THE USE OF THE PRESENT OWNERS OF THE PROPERTY, AND ALSO THOSE WHO PURCHASE, MORTGAGE, OR GUARANTEE THE TITLE THERETO ANY YEAR FROM THE DATE HEREOF.

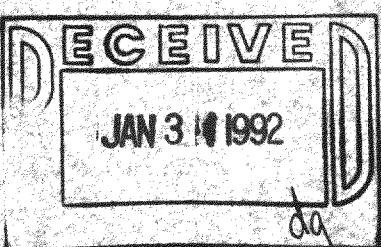

DATED: 11/20/91 Peter S. Gordon

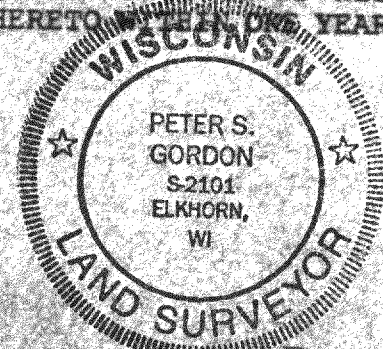

PROJECT NO
3592
DATE
01/06/92
SHEET NO.
1 of 1

WORK ORDERED BY: RON BURKE

PWW-26B2