


THE SOUTH 1/2 OF LOT 1, LOTS 2 & 3
McGREGOR HIGHLANDS SUBDIVISION

S 00° 00' 45" E 189.68'
(SOUTH 188.56')

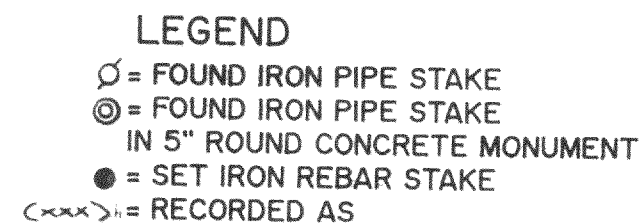

PLAT OF SURVEY
THE S. 1/2 OF LOT 1, AND LOTS 2 & 3
MCGREGOR HIGHLANDS SUBDIVISION
TOWN OF EAST TROY
WALWORTH COUNTY, WISCONSIN

FARRIS, HANSEN & ASSOCIATES, INC.
Engineering, Architecture, Surveying
7 Ridgway Court P.O. Box 437
ELKHORN, WISCONSIN 53121
Office: (414) 723-2098
Fax: (414) 723-5886

REVISIONS

PROJECT NO	
3753	
DATE	
11/25/1992	
SHEET	NO.
1 OF 1	

WORK ORDERED BY: DUANE SCHNEIDER

PMGH - 1A
PMGH - 2
PMGH - 3

418-881