


PLAT OF SURVEY
-OF-

LOT 26, BLOCK 1, MIRAMAR SUBDIVISION, a subdivision located in Sections 10 and 11, Township 4 North, Range 18 East in the Town of East Troy, Walworth County, Wisconsin.

Survey For: Tom & Darcy Dinauer
Survey Location: W1007 Miramar Drive

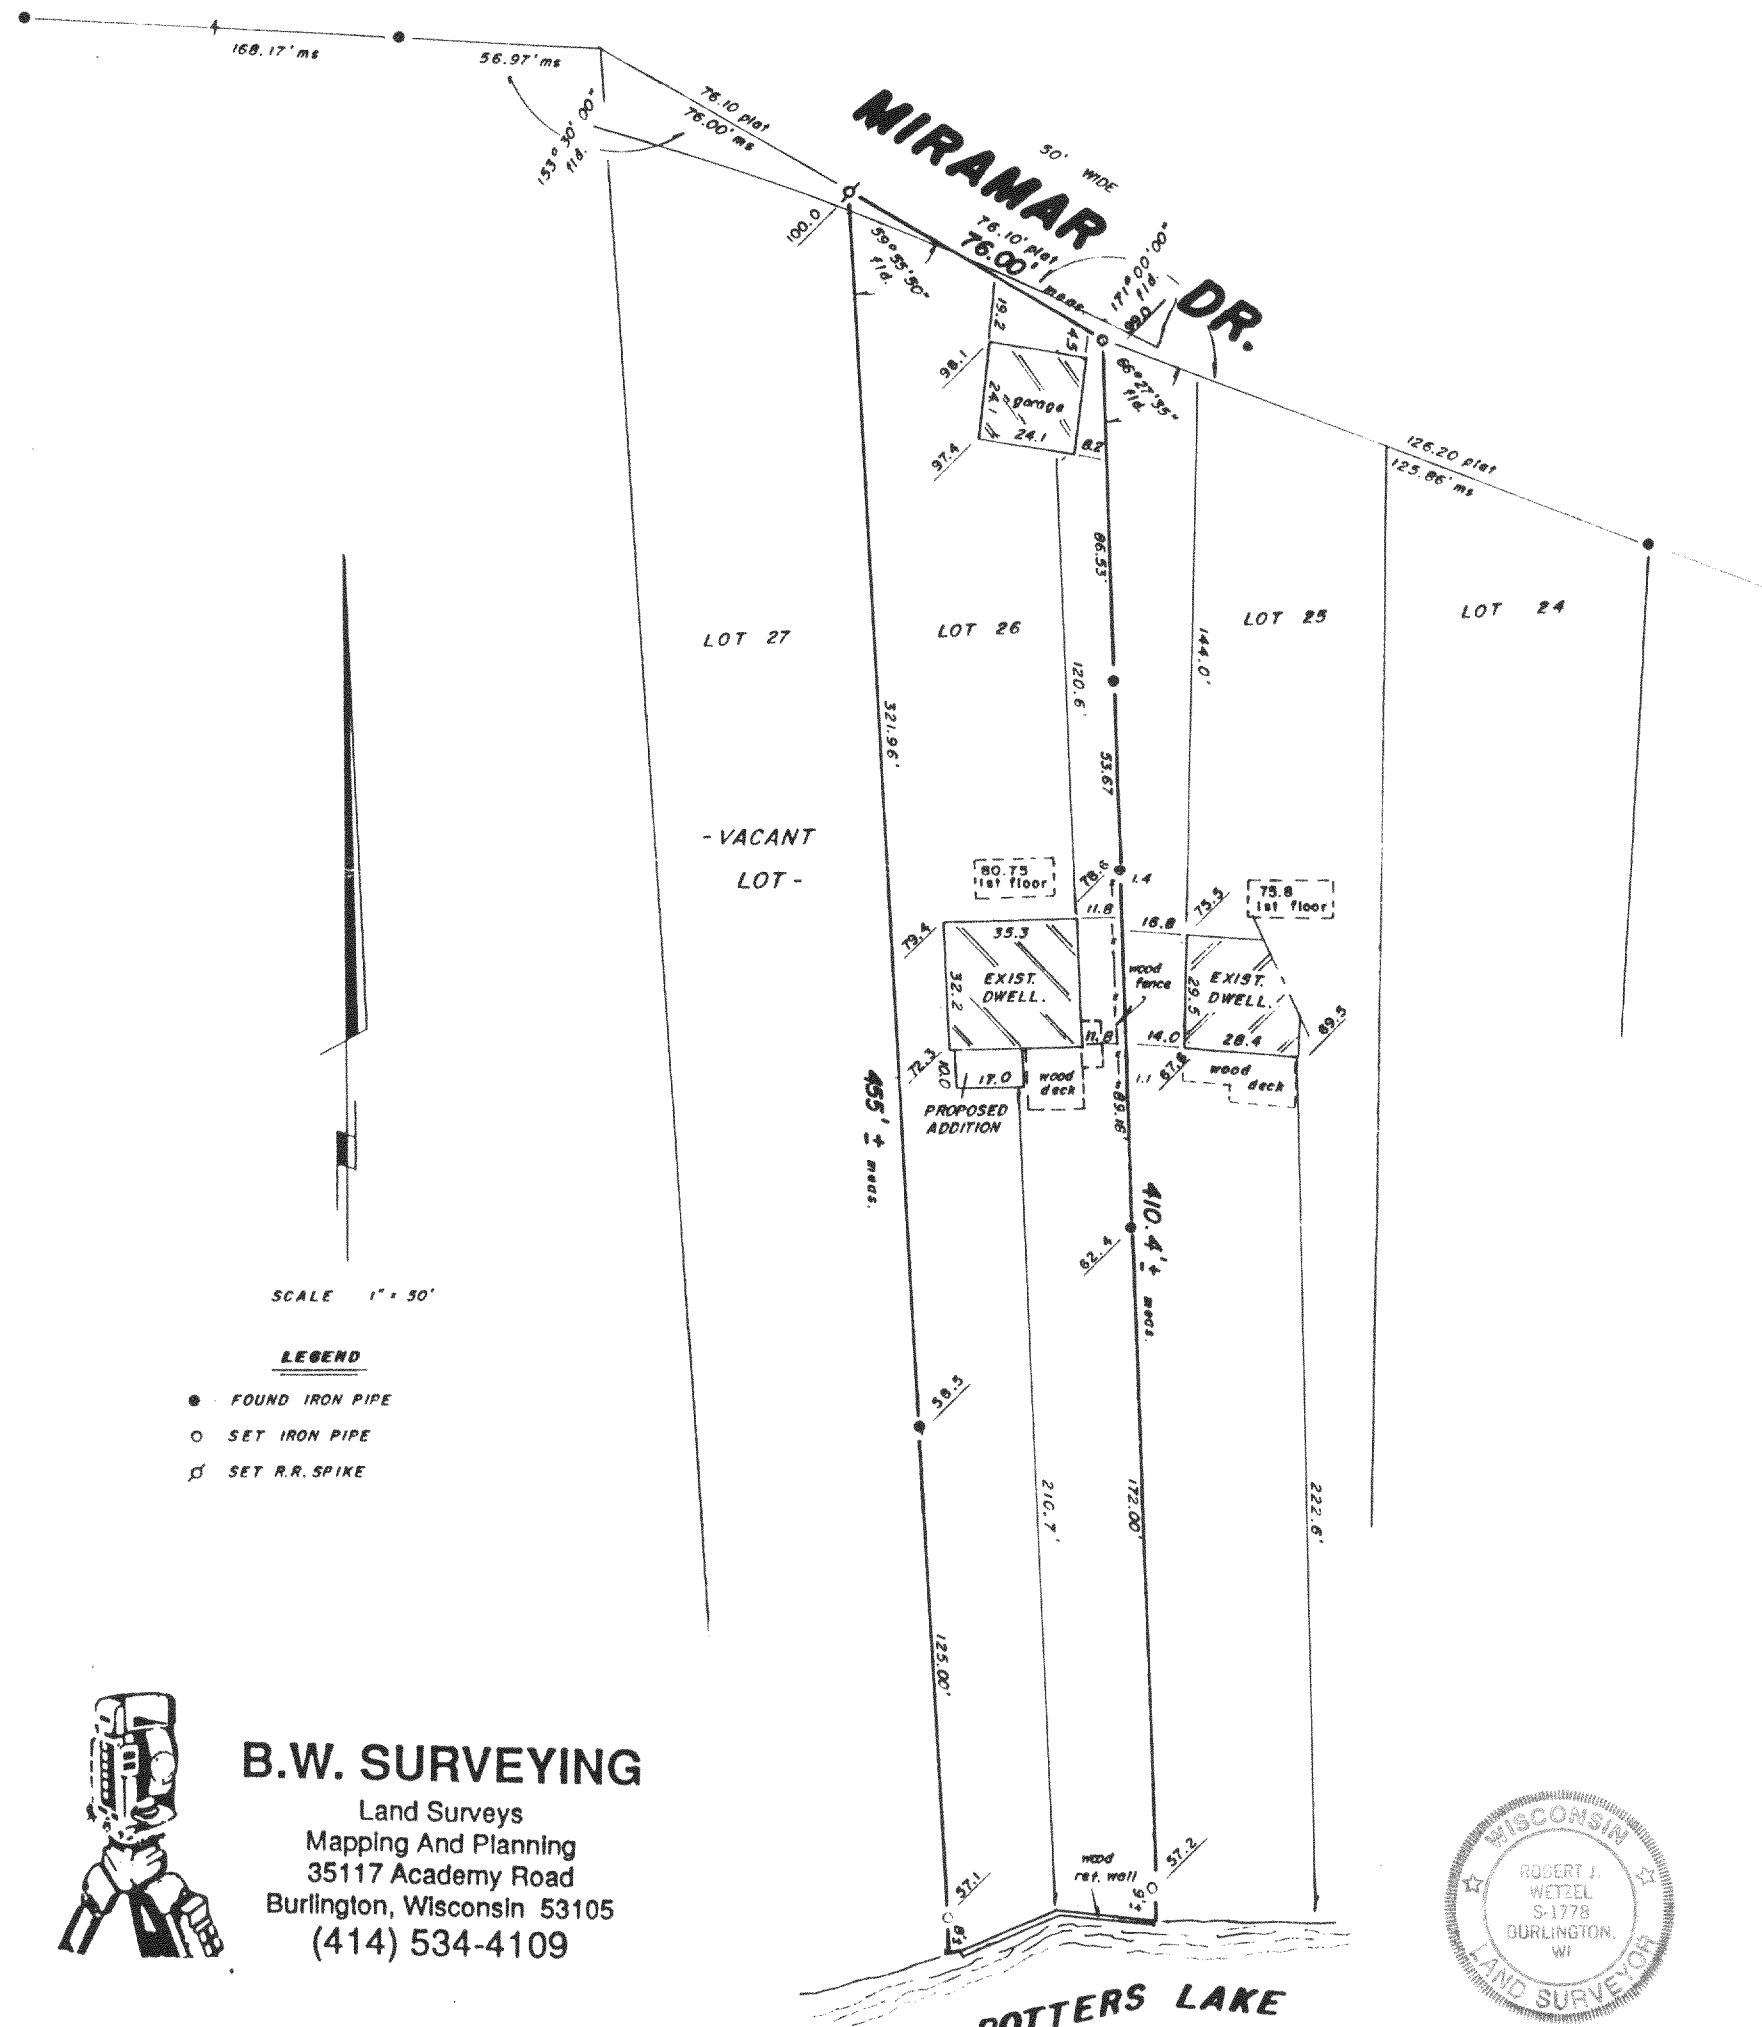

I hereby certify that I have surveyed the above described property and that the above map is a true representation thereof and shows the size and location of the property, its exterior boundaries, the location of all visible structures and dimensions of all principal buildings thereon, boundary fences, apparent easements, roadways and encroachments, if any.

This survey is made for the use of the present owners of the property, and those who purchase, mortgage, or guarantee the title thereto within one year from date hereof.

SEPT. 23, 1992
DATE

1024
JOB NUMBER

418-887

PMR-20A