


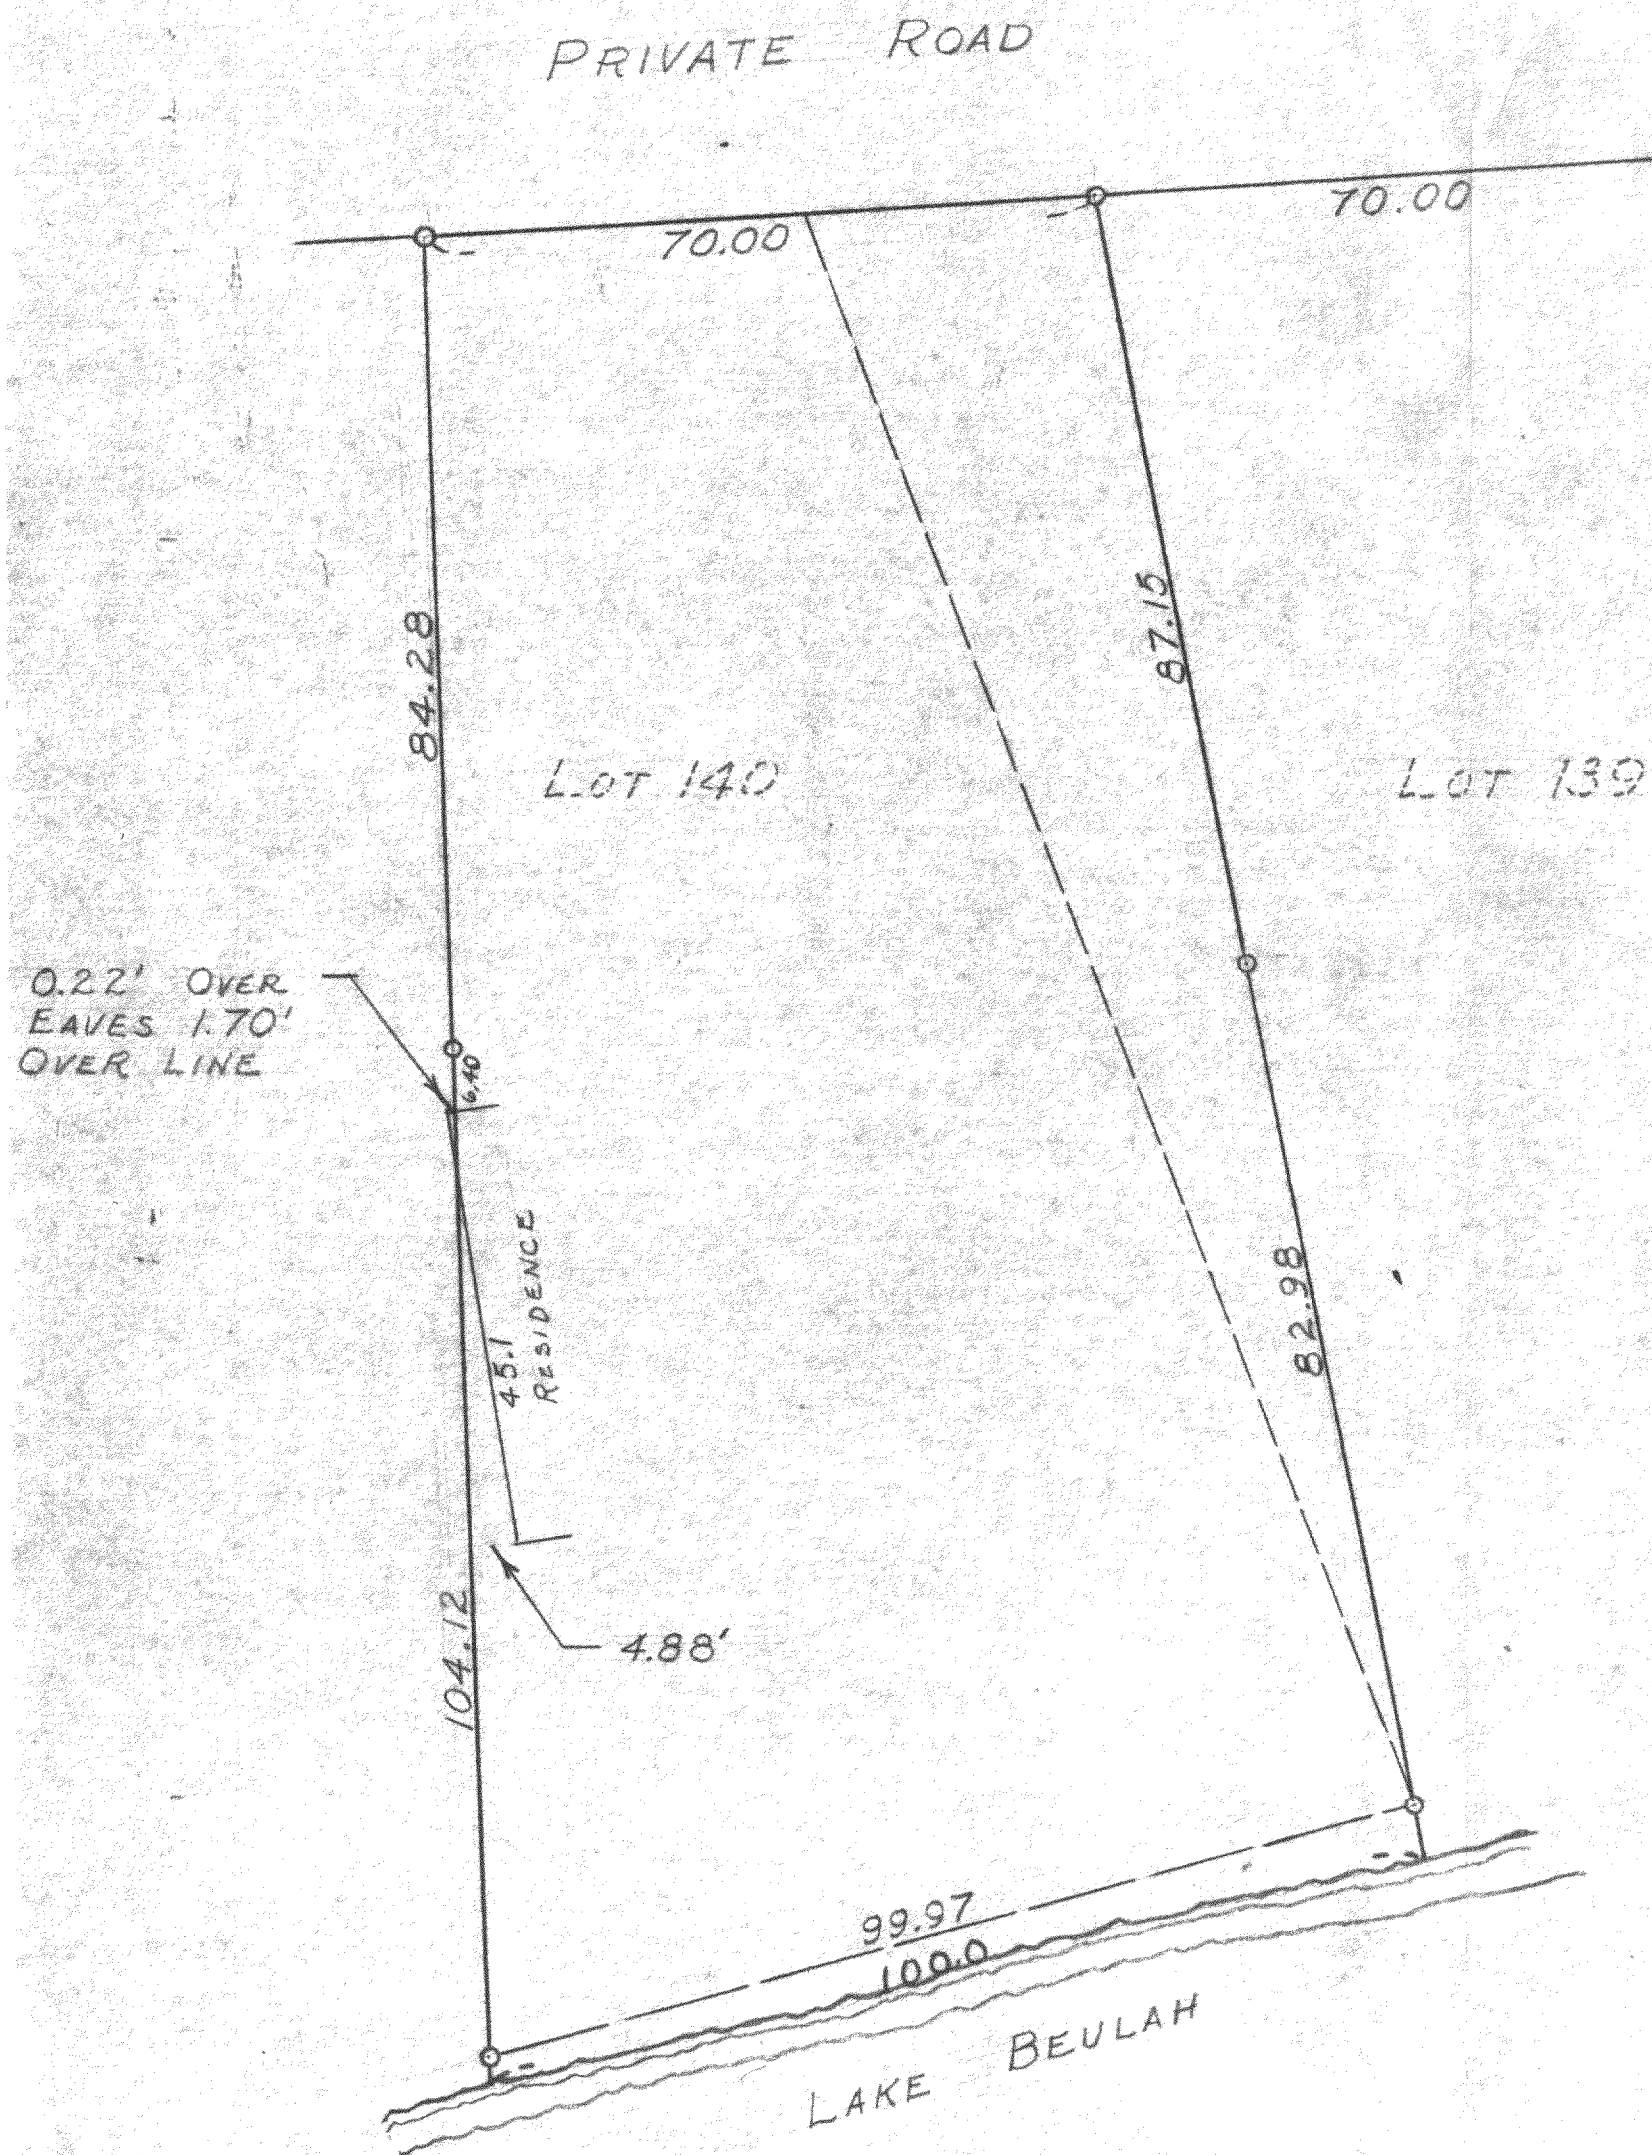

SCALE ~ 1" = 20'
 O ~ IRON PIPE

PLAT OF SURVEY OF PART OF LOTS 139 AND 140, BEULAH HEIGHTS SUBDIVISION
 LOCATED IN SECTIONS 7 AND 18, T4NR18E OF WALWORTH COUNTY, WISCONSIN
 JUNE 17, 1957

BH-23.22

George T. Dunham
 GEORGE T. DUNHAM, SURVEYOR
 DELAVAN, WIS.

418-9