



PLAT OF SURVEY OF

LOT 6 OF HIGHLAND VIEW ESTATES CONDOMINIUM
LOCATED IN SECTION 17, T4N, R18E, TOWN OF
EAST TROY, WALWORTH COUNTY, WISCONSIN

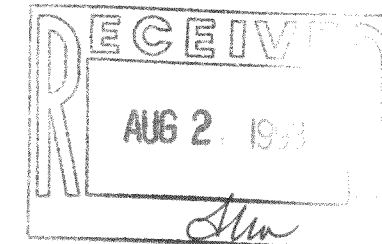

1" = 50'

BEARINGS REFERENCED TO CONDOMINIUM PLATT

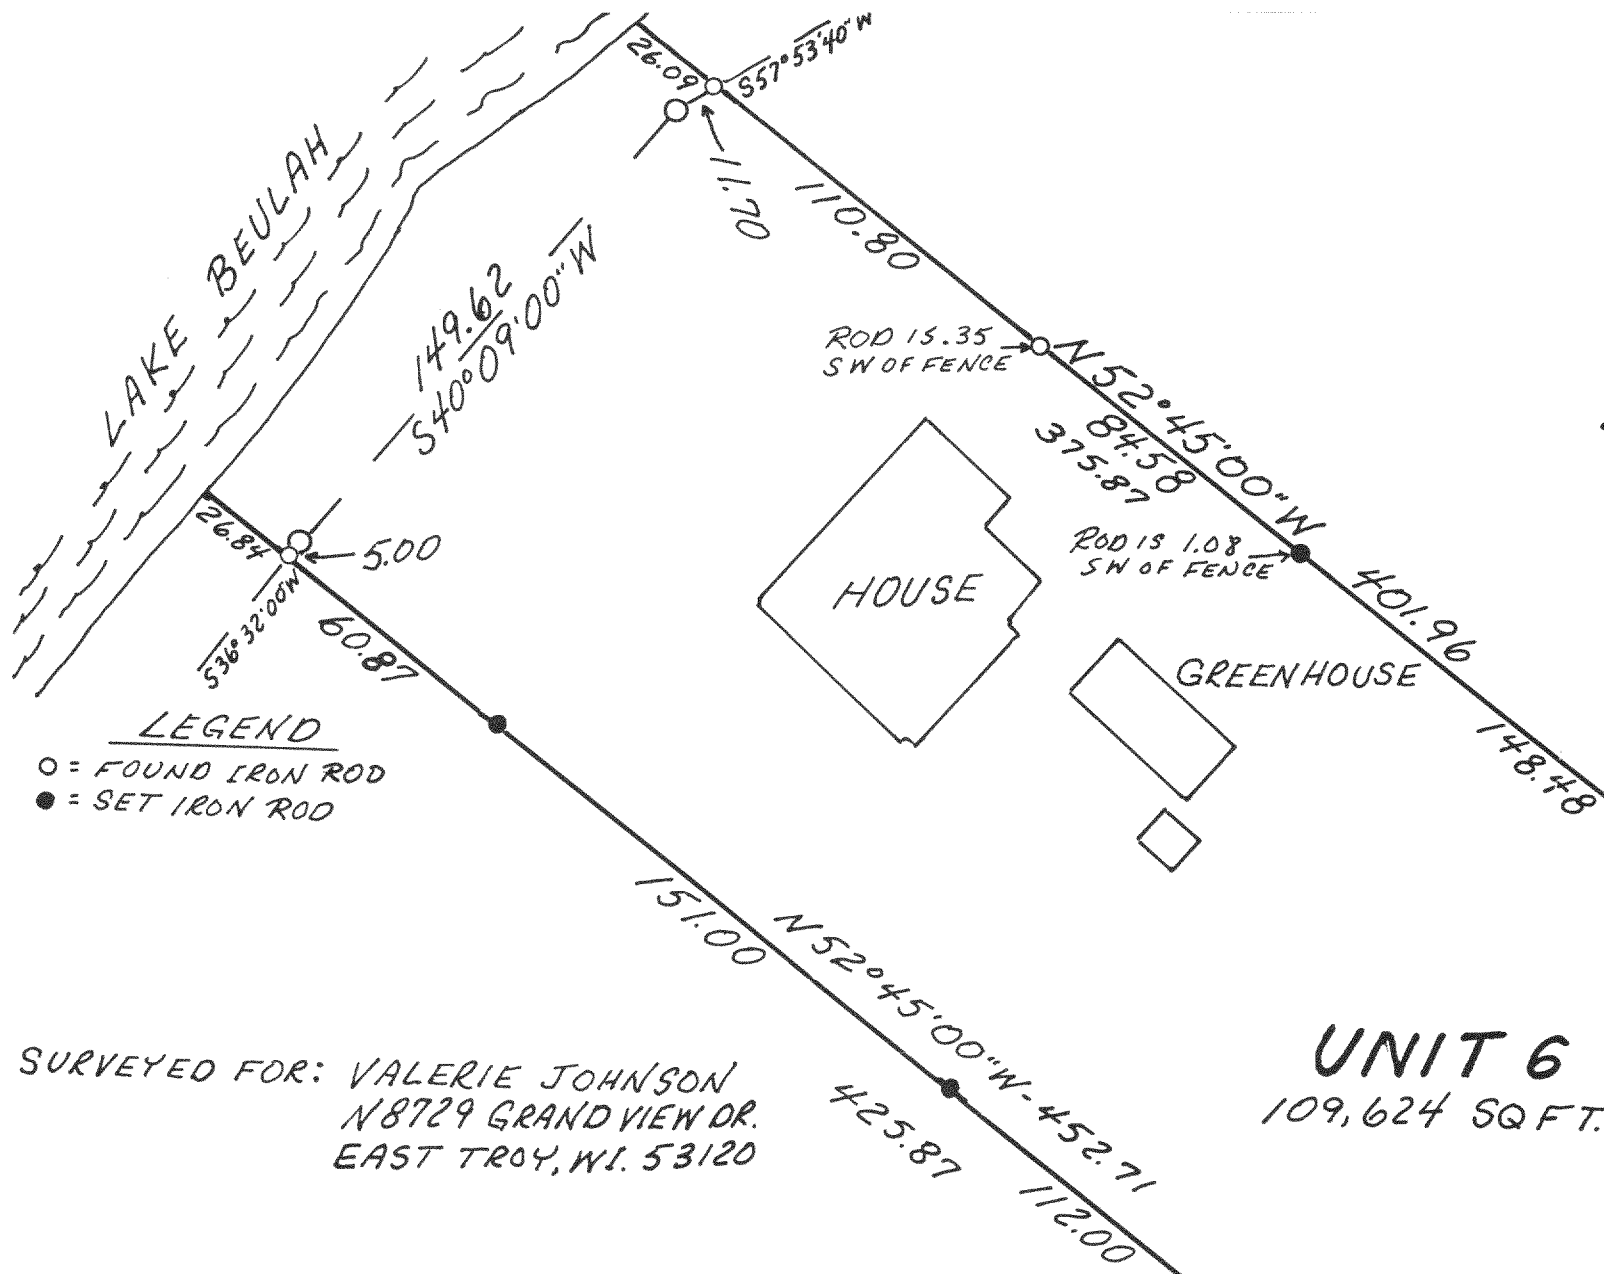


SURVEYED FOR: VALERIE JOHNSON
N8729 GRAND VIEW DR.
EAST TROY, WI. 53120

UNIT 6
109,624 SQ FT.

Copyright © 1993 by Jensen Surveying & Mapping S.C.

All rights reserved. No part of this survey plat may be reproduced or transmitted in any form by any means - graphic, electronic, or mechanical, including photocopying, tracing, or information storage and retrieval systems - without permission in writing from Thomas P.A. Jensen, Jensen Surveying & Mapping S.C.

Note: This survey plat is not
certified unless signed
and sealed in red ink.

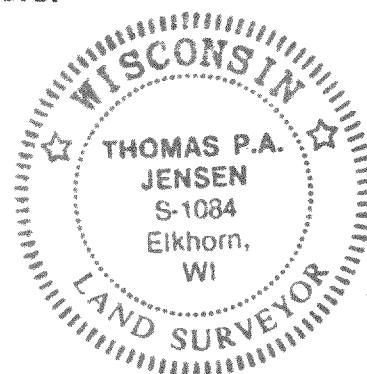

I, Thomas P.A. Jensen, Wisconsin Registered Land Surveyor, do hereby certify that this survey was performed by me, or under my direction, in full compliance with the owner's/agent's instructions and Chapter A-E 7 of the Wisconsin Administrative Code "Minimum Standards For Property Surveys"; and that this map is an accurate representation thereof to the best of my knowledge and belief.

Thomas P.A. Jensen

Thomas P.A. Jensen R.L.S-1084
Jensen Surveying & Mapping S.C.

JENSEN SURVEYING & MAPPING S.C.

45 South Wisconsin Street P.O. Box 322
Elkhorn, Wisconsin. 53121
(414) 723-3434



418-909

1993 012

PHV-6