

PLAT OF SURVEY

DATE: November 15, 1991

JOB NO. Z-4-39104

LOT 12 OF ISLAND CLUB

Town of East Troy, Walworth County, Wisconsin, together with an easement in common with others, from Island Club Subdivision Subdivision to Walworth County Highway "J", together with the right to use the 20 foot private road as laid out in said subdivision.

Located at 553 Island Drive

Owner: Gerald and Eveland Hoffman

FOUND IRON PIPE

SET IRON PIPE

8522 West Lisbon Avenue
Milwaukee, Wisconsin 53222

SURVEYED FOR


St. Francis Bank
2360 North 124th Street
Wauwatosa, Wisconsin 53226

LANDMARK SURVEYING CO.


I, Richard J. Lammi, surveyed the above described property, and the above map is a true representation thereof and shows the size and location of the property, its exterior boundaries, the location and dimensions of all visible structures thereon, fences, apparent easements, roadways and visible encroachments.

This survey is made for the exclusive use of the present owners of the property; also those who purchase, mortgage or guarantee the title thereto, within one year of date hereof.

PHONE
461-3730

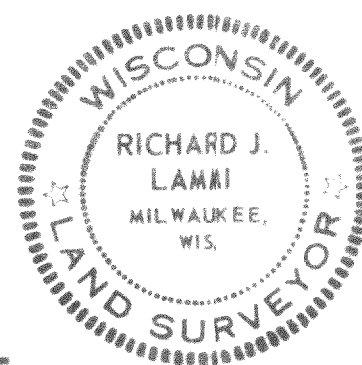

REGISTERED LAND SURVEYOR NO. 5777 - STATE OF WISCONSIN

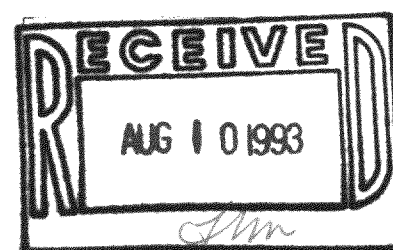

SCALE 1" = 30'

IN ACCORDANCE WITH CHAPTER A-E 7.01-1B,
A SIGNED AGREEMENT IS ON FILE WAIVING
THE SETTING OF MONUMENTS ON THE PROPERTY.

P1-12

418.912