



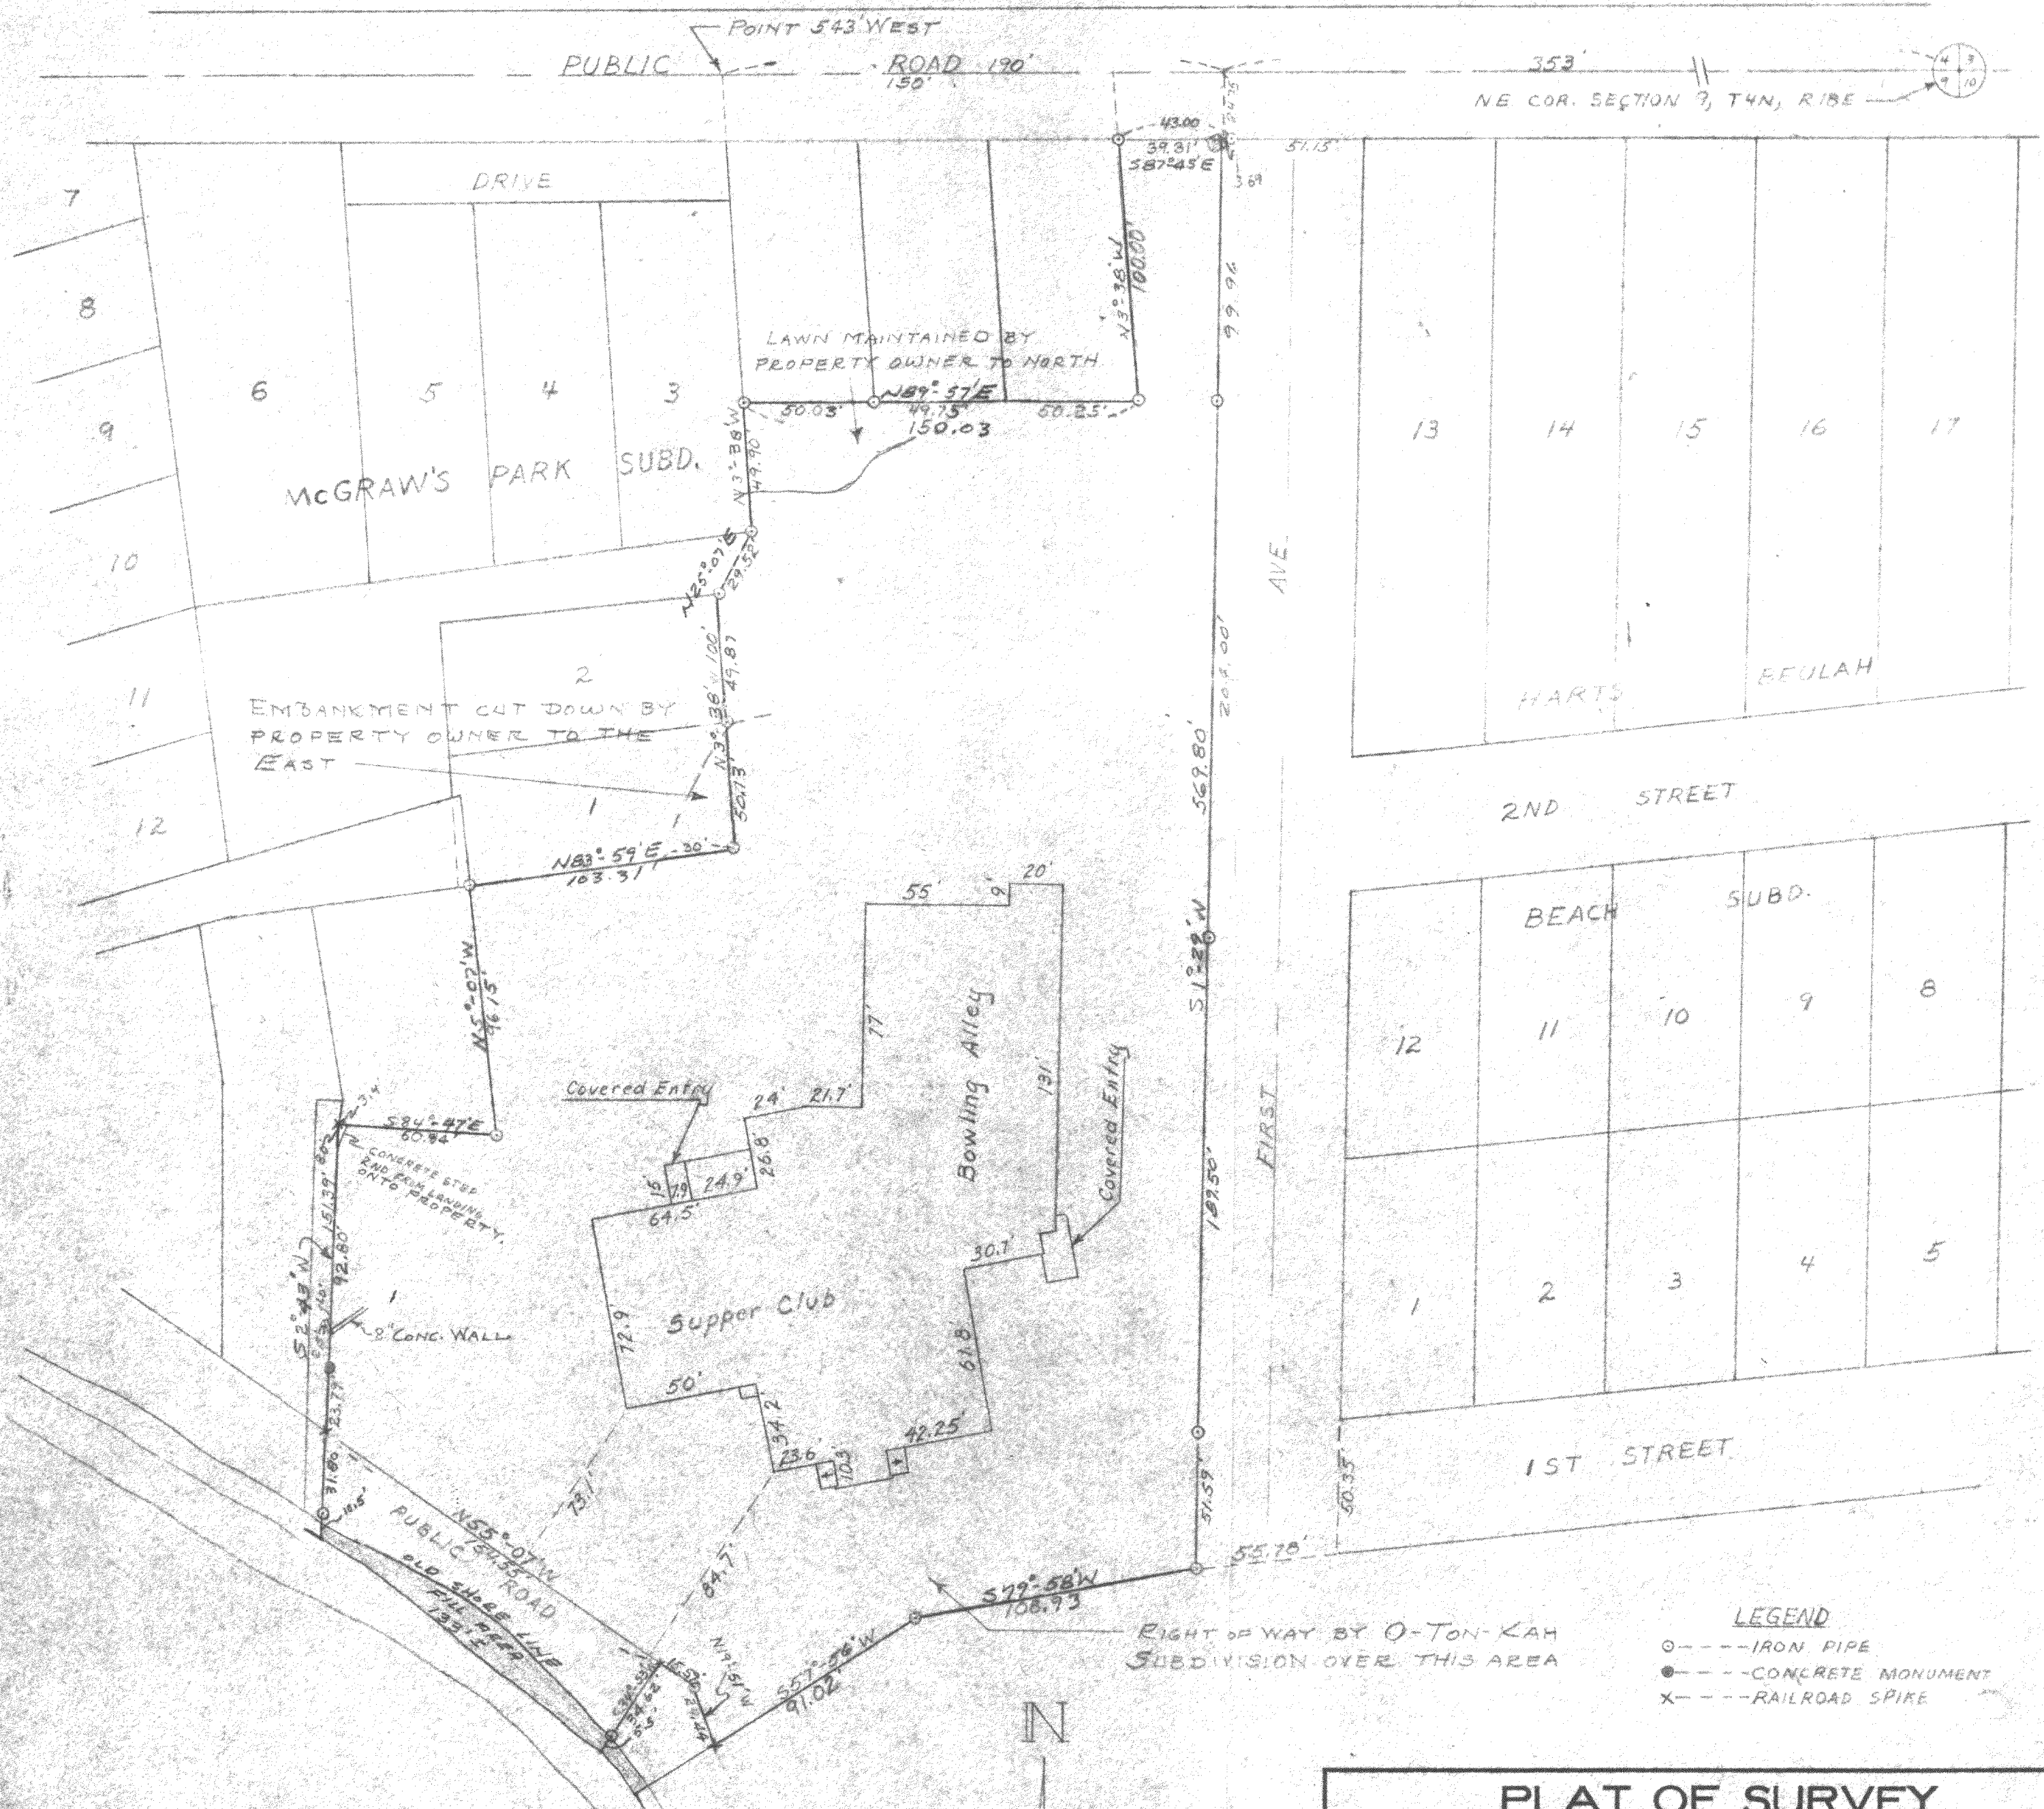

I HEREBY CERTIFY THAT THE BUILDINGS ARE CORRECTLY SHOWN ON THE PROPERTY SURVEYED AND THE ENCROACHMENTS OVER THE PROPERTY LINE AND ONTO THE PROPERTY ARE SHOWN. UNDER GROUND STRUCTURES ARE NOT SHOWN. PUBLIC AND PRIVATE ROADS ON THE PROPERTY ARE NOT SHOWN.
 Lloyd L. Jensen
 SURVEYOR
 MAY 22, 1962
 JULY 1970 (P.C.)

ET-9-1D
 ET-9-1B
 ET-9-4E ET-9, 4N, 4L + 4M

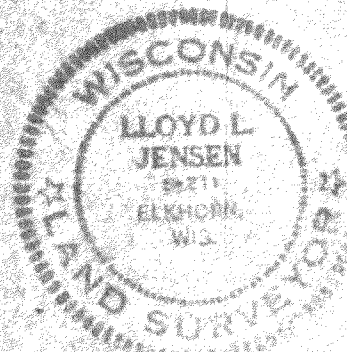

PLAT OF SURVEY OF

LAND LOCATED IN THE NORTHEAST
 1/4 OF FRACTIONAL SECTION 9, T4N, R18E
 OF WALWORTH COUNTY, WISCONSIN
 SHOWING BUILDINGS LOCATED THEREIN.

Lloyd L. Jensen
 SURVEYOR

SCALE 1" = 50'

DATE JULY 1960
 Revised - March 1962
 REVISED - JULY 1970