

ABERNATHY and ASSOCIATES

Kenneth B. Abernathy Jr.

Wisconsin Registered Land Surveyor S-1594

Rt. 3, Box 273
Elkhorn, Wisconsin 53121
Phone: (414) 723-4260 (office)
(414) 723-4813 (residence)


PLAT OF SURVEY

PART OF LOT 4 AND 5 OF LAKE BEULAH
COUNTRY PARK, A SUBDIVISION LOCATED
IN THE NORTH 1/2 OF SECTION 18, TOWN
4 NORTH, RANGE 18 EAST, TOWN OF EAST
TROY, WALWORTH COUNTY, WISCONSIN.

OWNER: BETTY RHODE
W2251 COUNTRY CLUB LANE
EAST TROY, WI. 53120

LEGAL DESCRIPTION:

VOL. 287 P. 107 DOC. NO. 80051

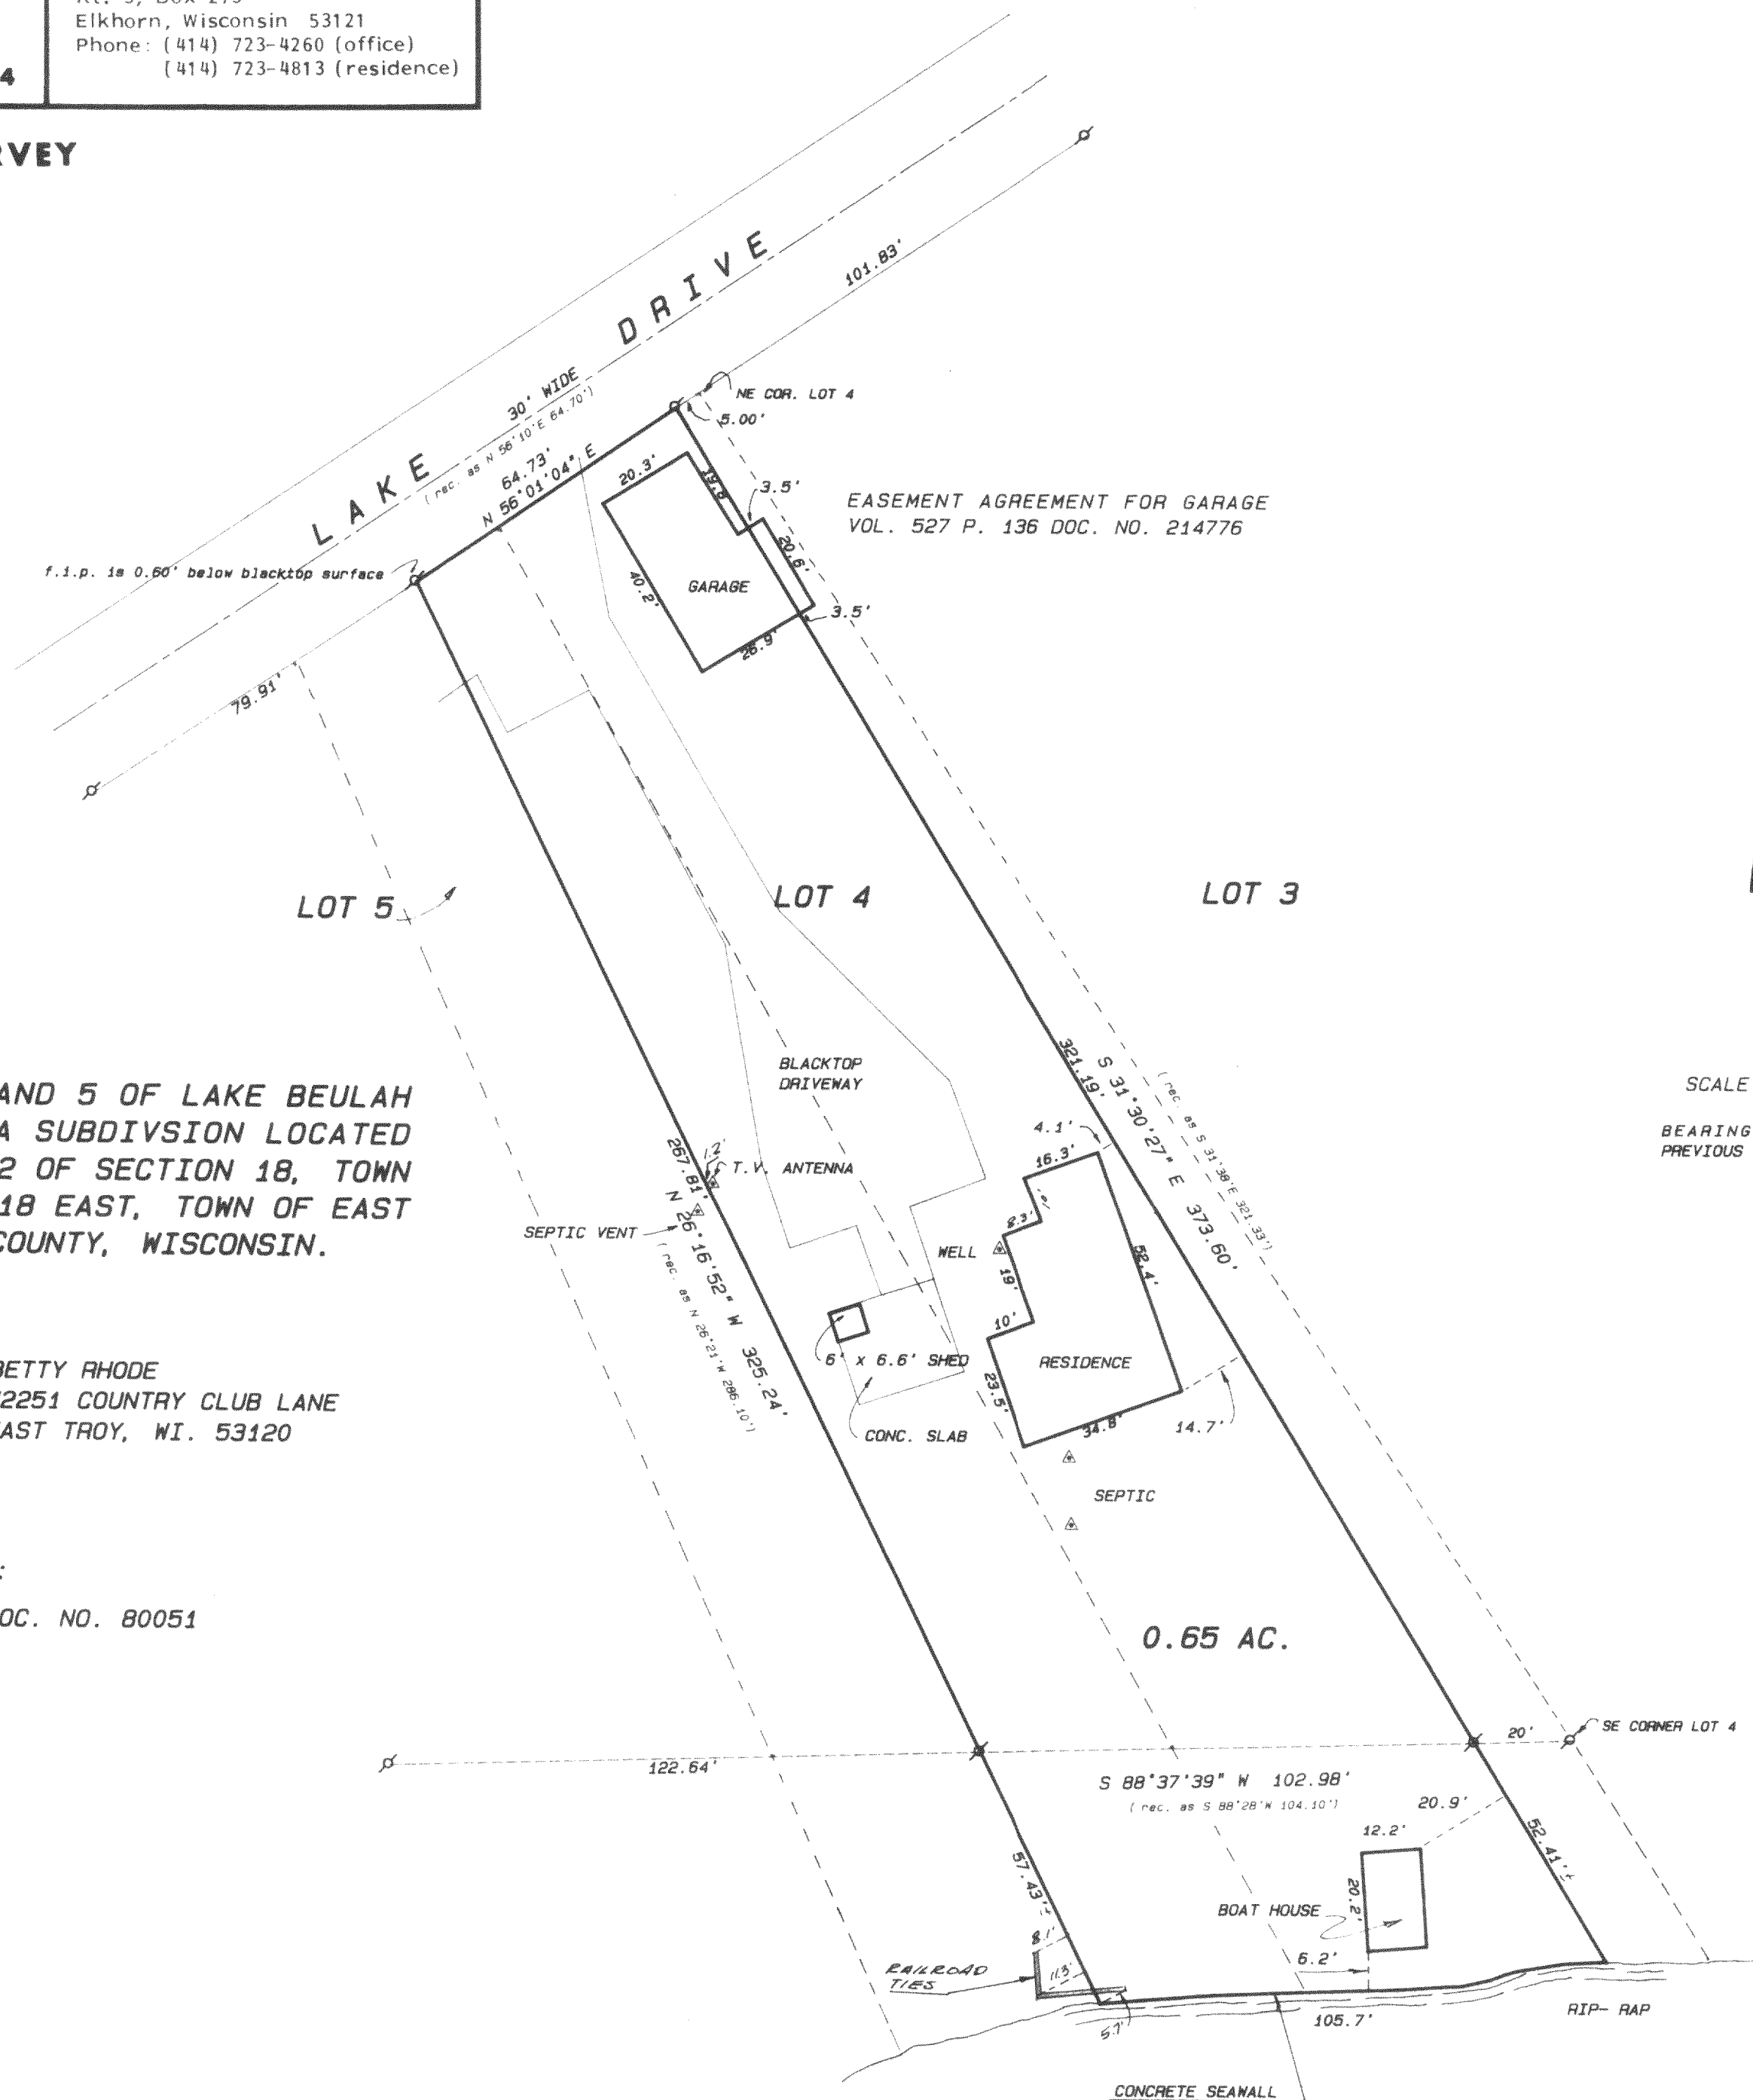


SCALE 1" = 30 FEET

BEARINGS REFERENCED TO
PREVIOUS SURVEY TO THE EAST

Legend

- FOUND IRON PIPE
- FOUND IRON ROD
- FOUND BRASS CAPPED MONUMENT
- * FOUND CONCRETE MONUMENT
- + CHISEL CUT IN CONCRETE
- SET IRON ROD, 24" LONG, WEIGHING 1.5 LBS./LINEAL FT., 3/4" DIA.
- SET IRON ROD, 30" LONG, WEIGHING 4.5 LBS./LINEAL FT., 1-11/16" DIA.
- (xx) RECORDED AS DIMENSION
- X-X- EXISTING FENCE

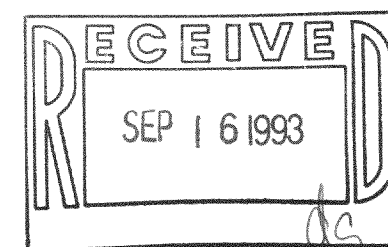

SCALE: 1" = 30 FEET


"I hereby certify that I have surveyed the above described property and that the above map is a true representation thereof and shows the size and location of the property, its exterior boundaries, the location of all visible structures and dimensions of all principal buildings thereon, boundary fences, apparent easements, roadways and visible encroachments, if any."

"This survey is made for the use of the present owners of the property, and also those who purchase, mortgage, or guarantee the title thereto within one year from date hereof."

Kenneth B. Abernathy Jr.

KENNETH B. ABERNATHY, JR.
WISCONSIN REGISTERED LAND SURVEYOR,
S-1594

Date: 5-21-93 Job No. 93.507

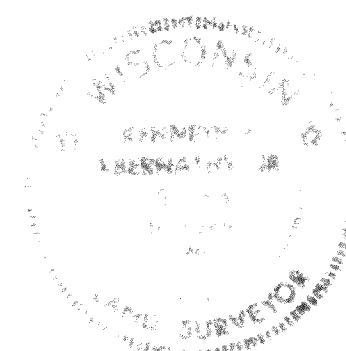

418-929

PLR-4