

PLAT OF SURVEY
OF


LOTS 1 & 2, BLOCK 2, WILMER GROVE BEACH, LOCATED IN THE EAST 1/2 OF SECTION 18, T. 4. N.,
R. 18 E. OF THE 4TH P.M., TOWNSHIP OF EAST TROY, COUNTY OF WALWORTH, STATE OF WISCONSIN.

I HEREBY CERTIFY THAT I HAVE SURVEYED THE LAND DESCRIBED ABOVE AND THAT THE PLAT DRAWN
HEREON IS A CORRECT REPRESENTATION OF SAID SURVEY. I FURTHER CERTIFY THAT THE BUILDINGS
ON SAID LAND ARE LOCATED AS SHOWN ON THIS PLAT.

SCALE 1" EQUALS 20'

O DENOTES IRON PIPE STAKE FOUND.

John F. Degen 5-13-71
JOHN F. DEGEN, LAND SURVEYOR #242
589 N. PINE ST., BURLINGTON, WISCONSIN.

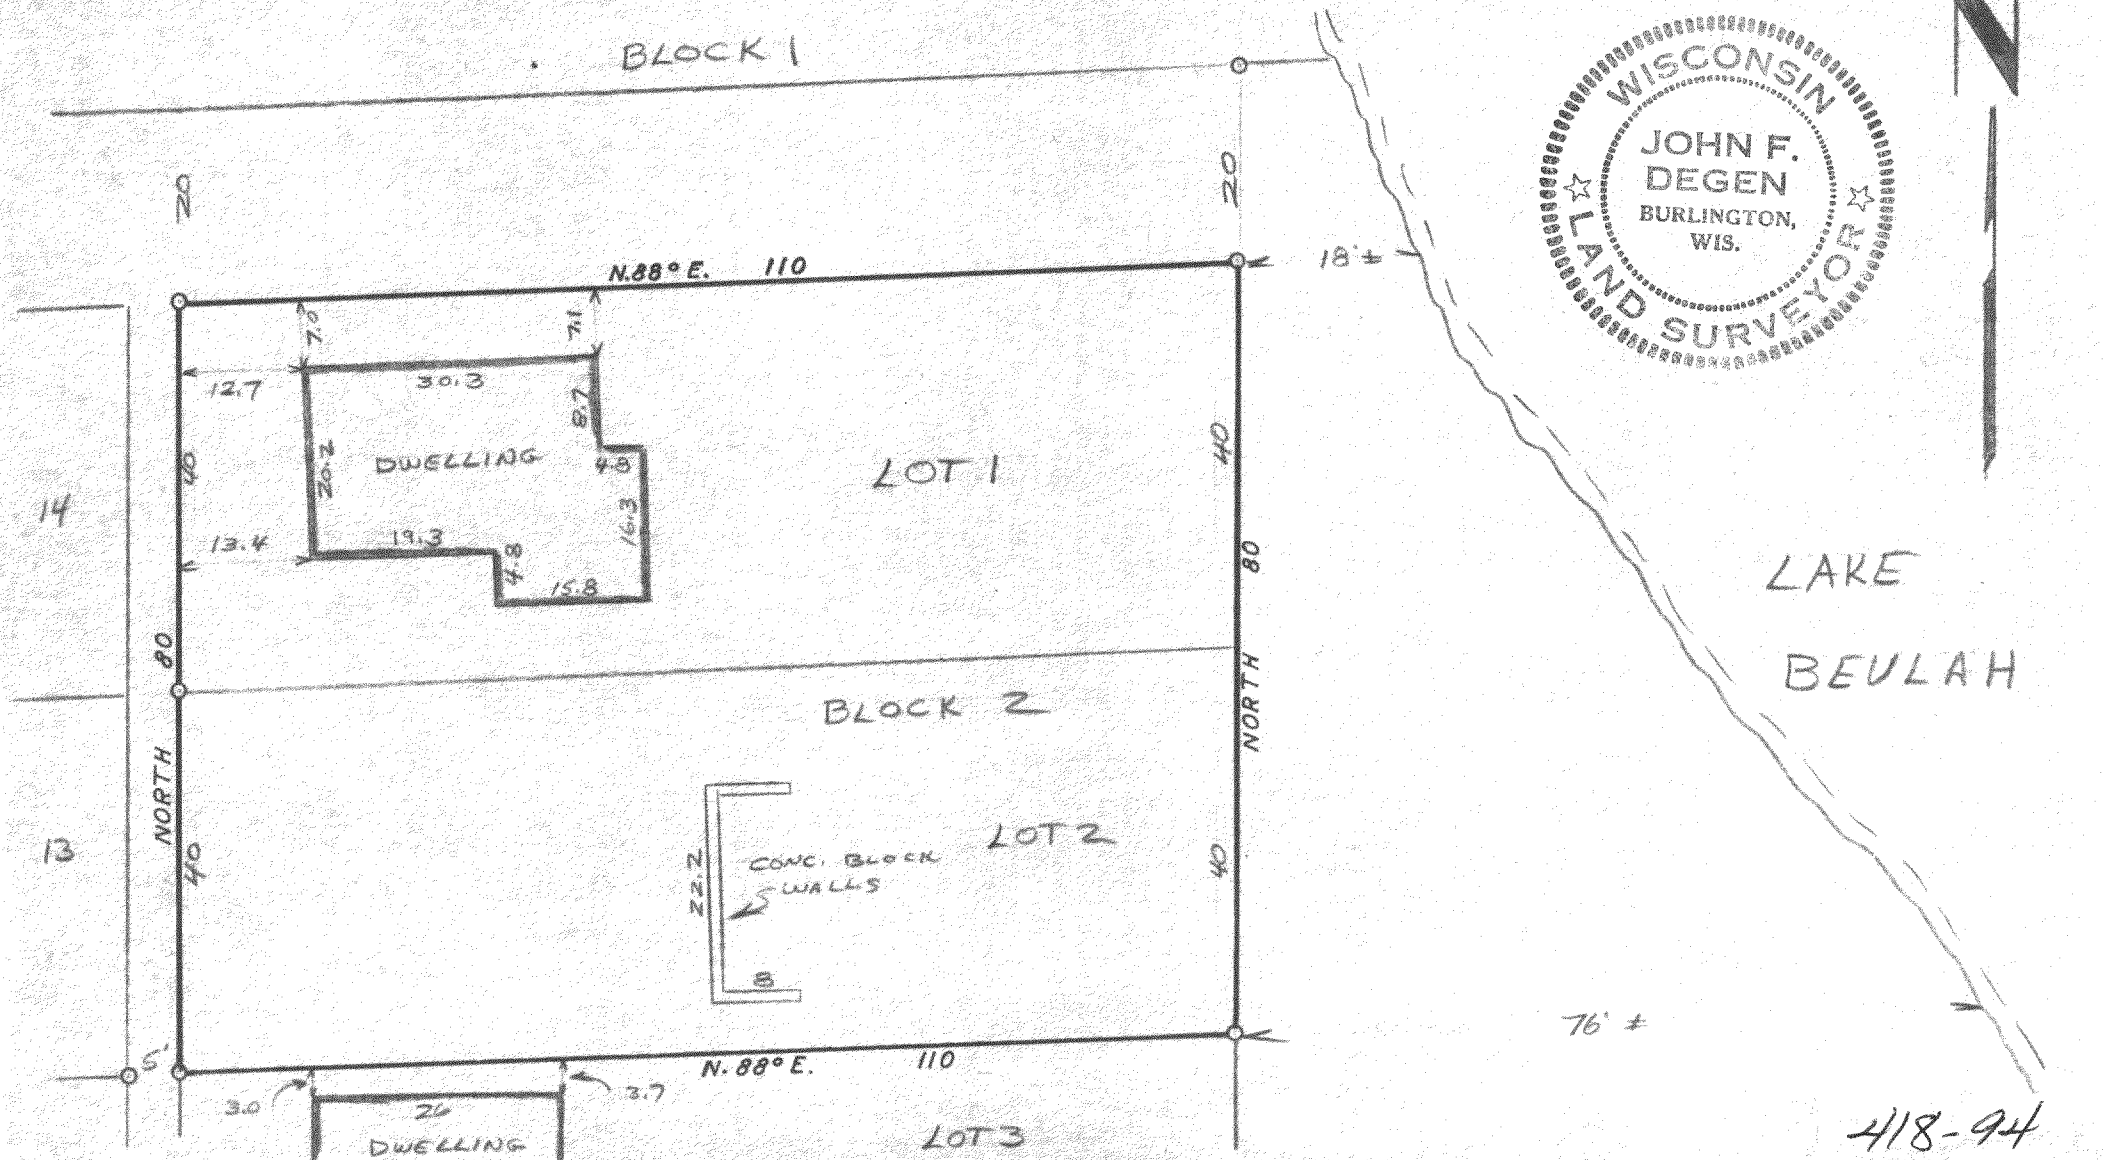

5-13-71 DRAWER 100