
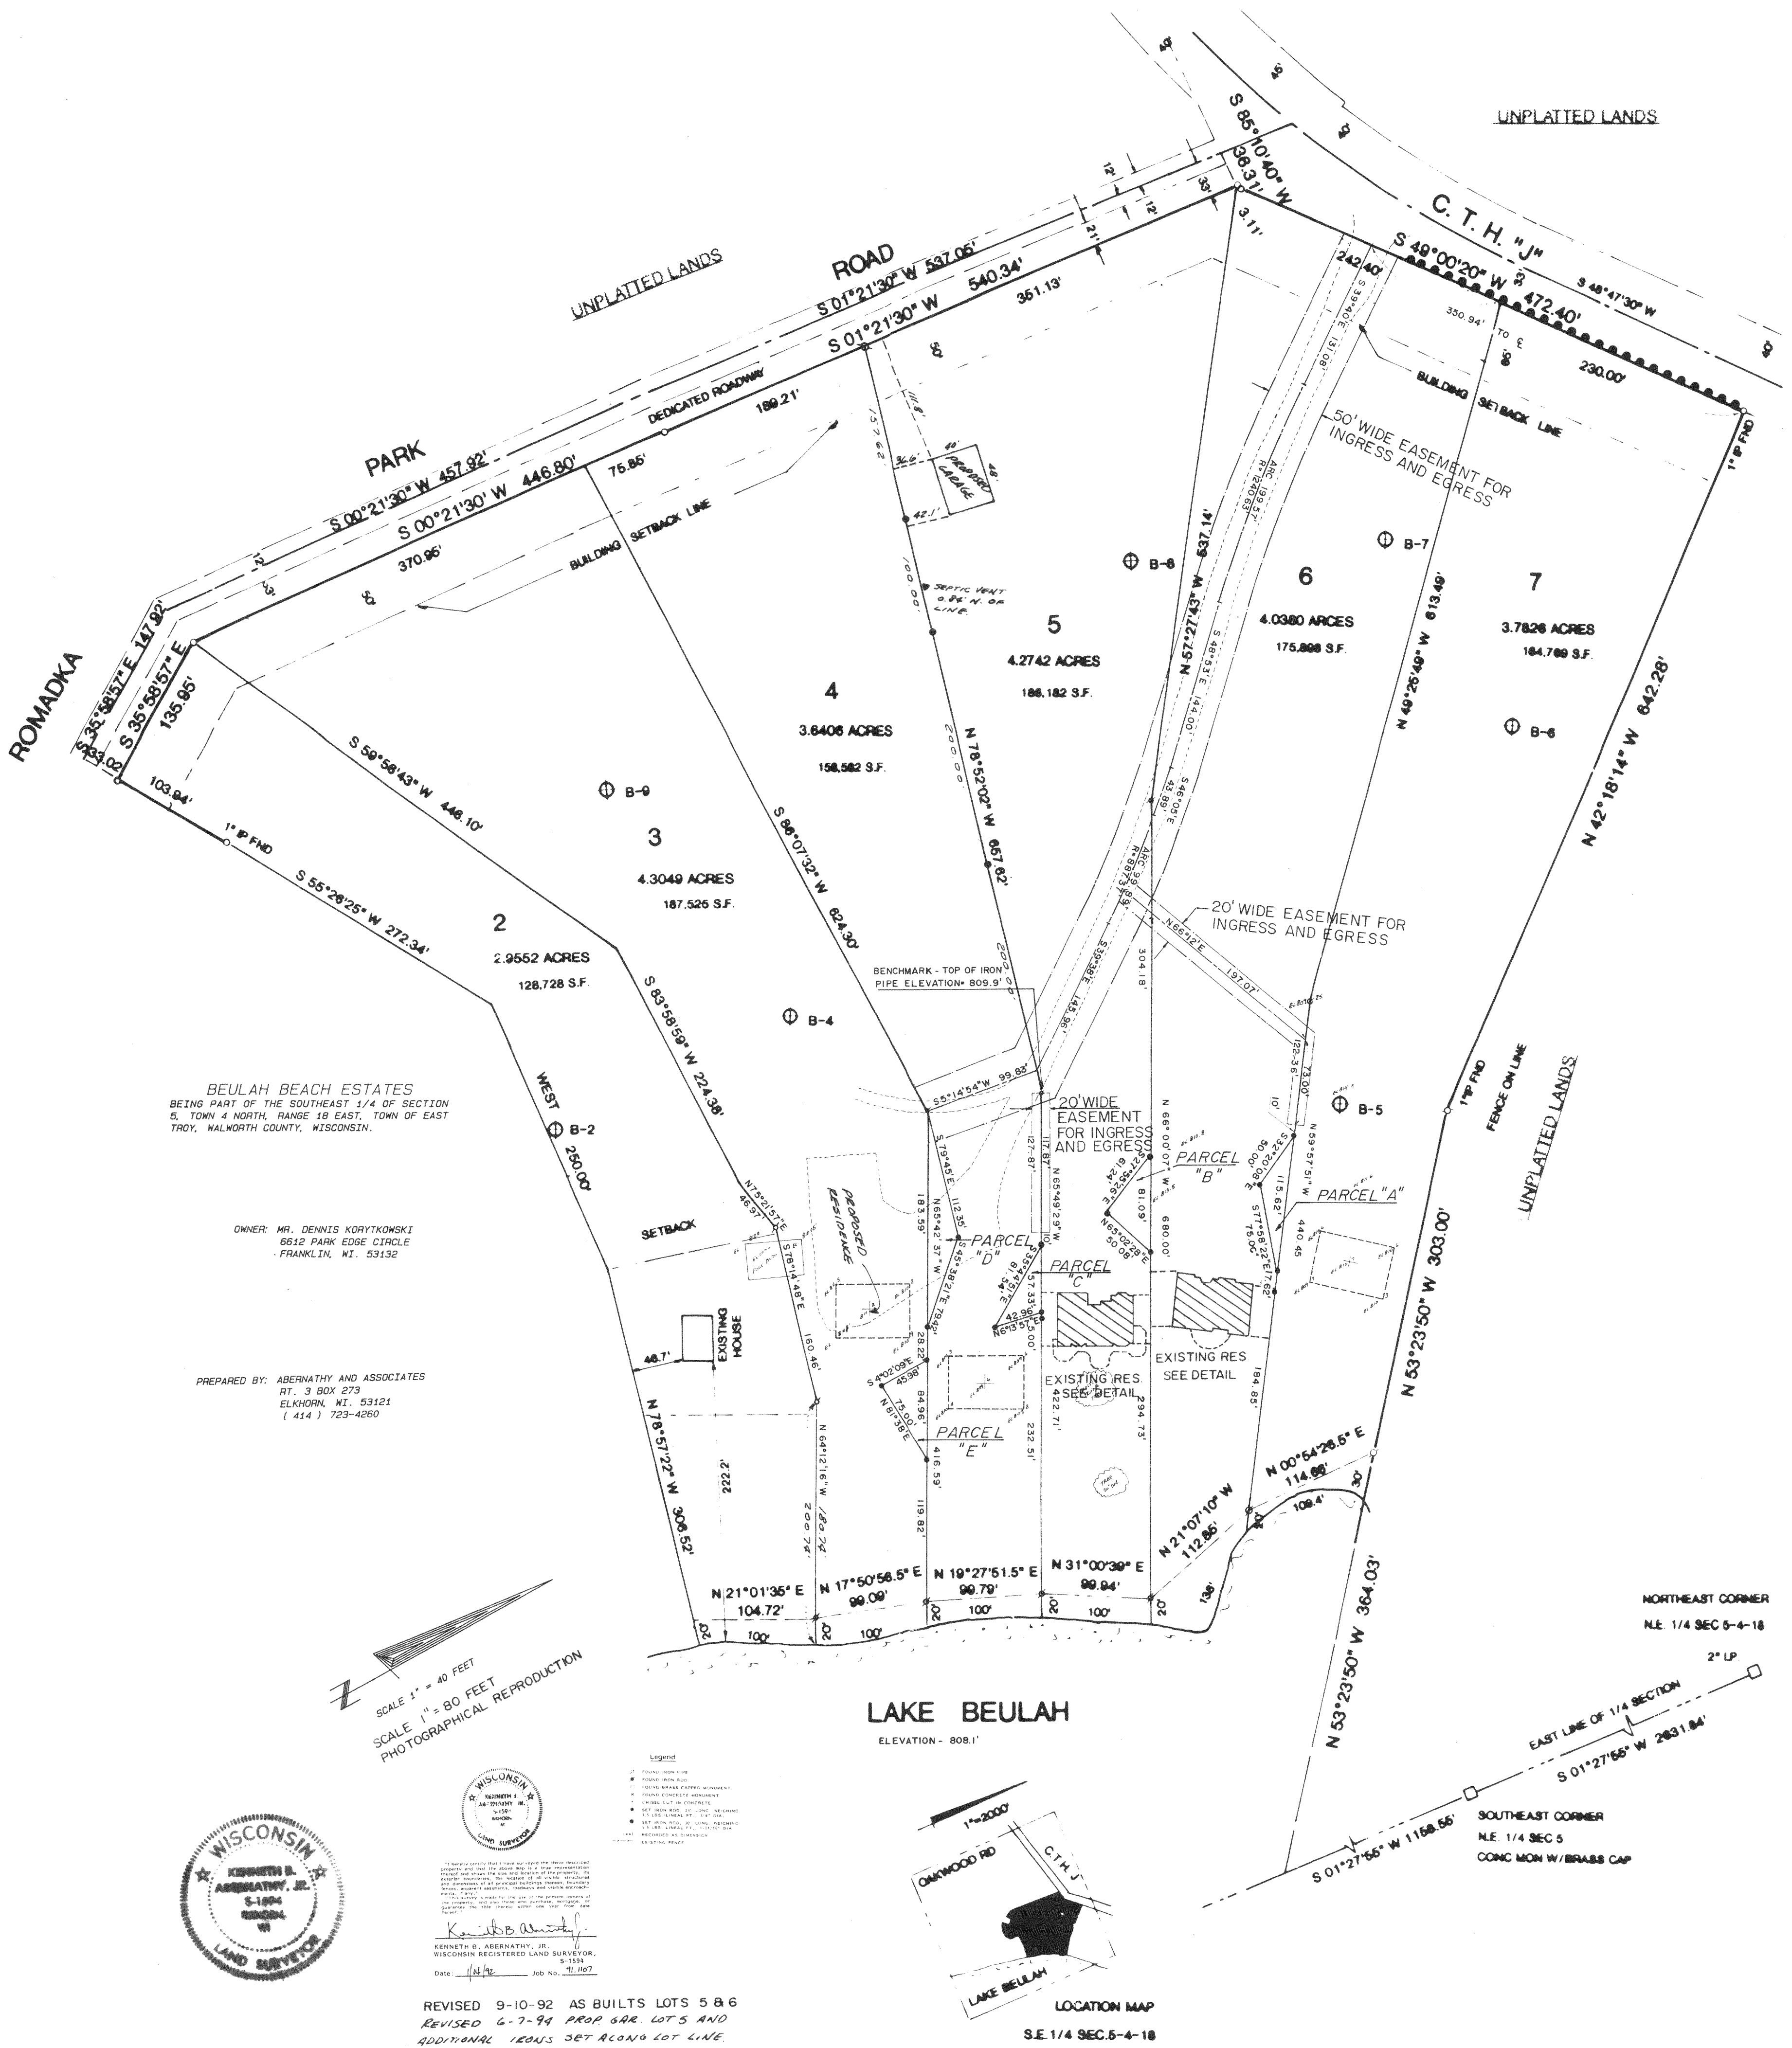


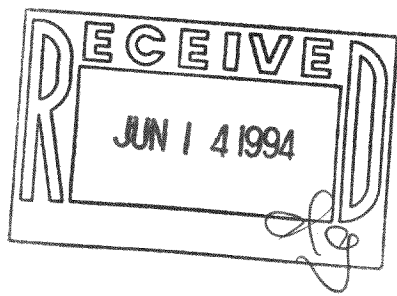

PBB-2
PBB-3
PBB-4
PBB-5
PBB-6
PBB-7