


PLAT OF SURVEY



OWNER: JAMES L. SCHNEIDER


DATE: 1/19/94

DESCRIPTION: LOT 14 OF WILLIAMS PARK SUBDIVISION LOCATED IN SECTION 4, TOWNSHIP 4 NORTH, RANGE 18 EAST, TOWN OF EAST TROY, WALWORTH COUNTY, WISCONSIN, DESCRIBED AS FOLLOWS: BEGINNING AT THE INTERSECTION OF THE NORTH RIGHT OF WAY OF HORSESHOE LANE (33' R/W) AND THE WEST RIGHT OF WAY OF EAST SHORE ROAD (66' R/W); THENCE WITH THE NORTH RIGHT OF WAY OF HORSESHOE LANE S87°59'00"W, A DISTANCE OF 214.23' TO A POINT; THENCE N06°18'00"W, A DISTANCE OF 147.37' TO A POINT; THENCE N89°16'59"E, A DISTANCE OF 214.14' TO A POINT ON THE WEST RIGHT OF WAY OF EAST SHORE ROAD; THENCE S06°30'21"E, ALONG SAID WEST RIGHT OF WAY OF EAST SHORE ROAD DISTANCE OF 142.54' TO THE POINT OF BEGINNING.

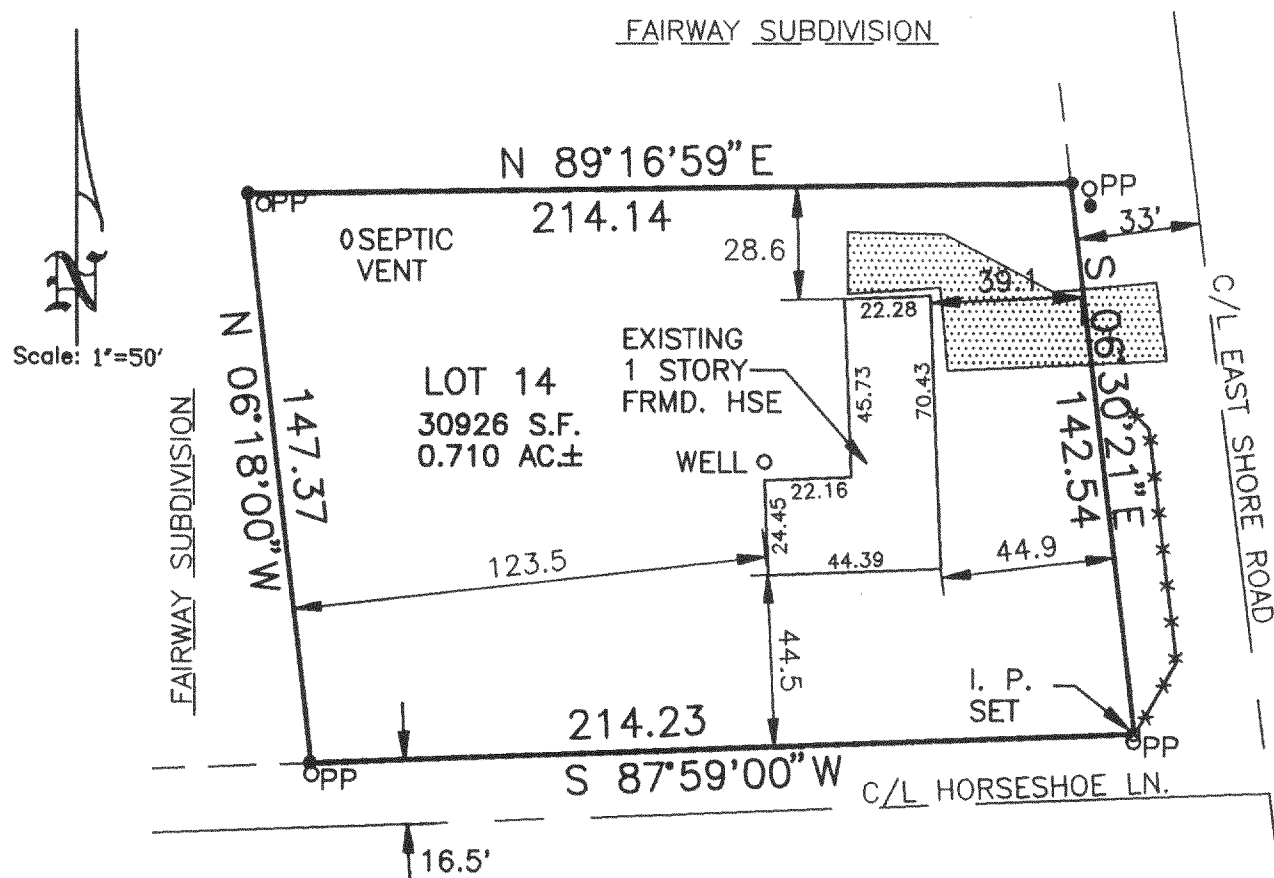

LEGEND

- IRON PIPE FOUND
- ◊ IRON PIPE SET
- opp POWER POLE
- *** FENCE
- CONCRETE

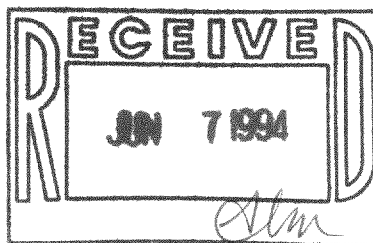

The above map is a true representation thereof and shows the size and location of all the property, exterior boundaries, the location of all visible boundary fences, apparent easements, roadways and visible encroachments, if any.

This survey is made for the use of the present owners of the property, and also those who purchase, mortgage or guarantee title thereto within one (1) year from date hereof.

Bradford L. Spencer, R.L.S. 2069

#94022 PWP-15A1

THIS IS ORIGINAL
PRINT ONLY IF
SEAL IS IMPRINTED
IN RED



48-986