


Survey of lots 39 & 40 of Blk. 2
of 3rd Add to Inlet Oaks.
Subd. in T2N R16E


5-25-38

Lloyd & Jensen
by K.E.J.

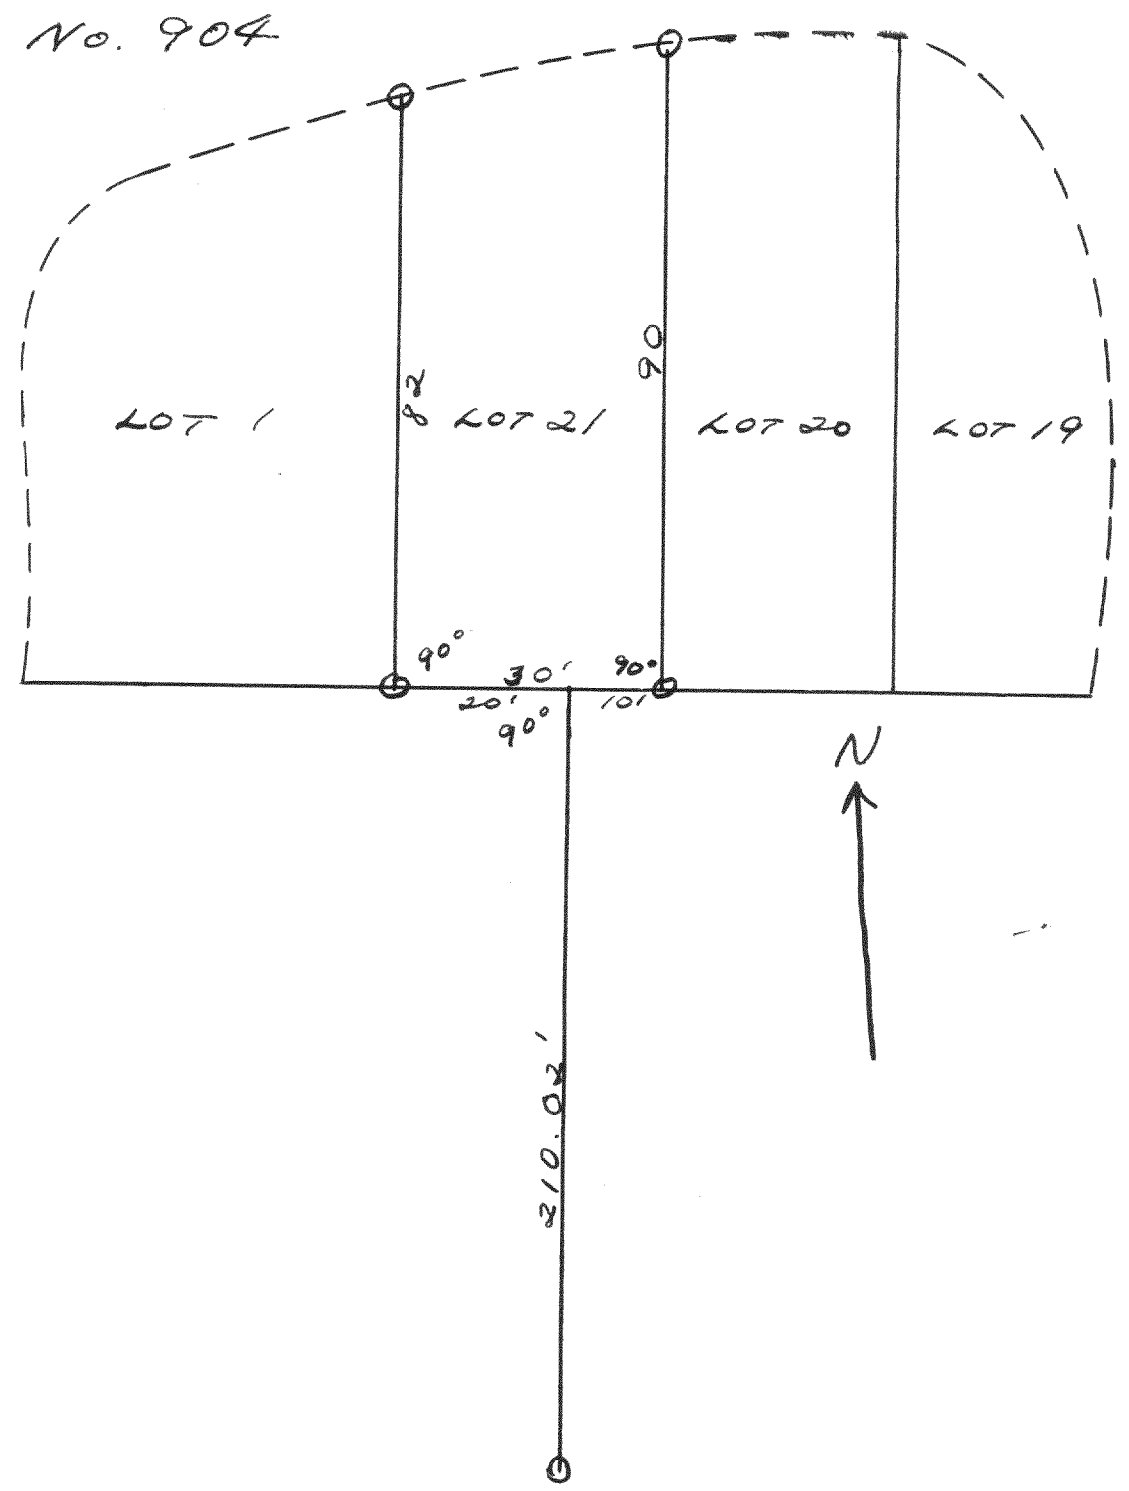

Survey of Lot 21 Blk. 0
of Pelawan Lake Assembly
Grounds

Nov. 21, 1938 Lloyd L. Jensen
by K.E.J.

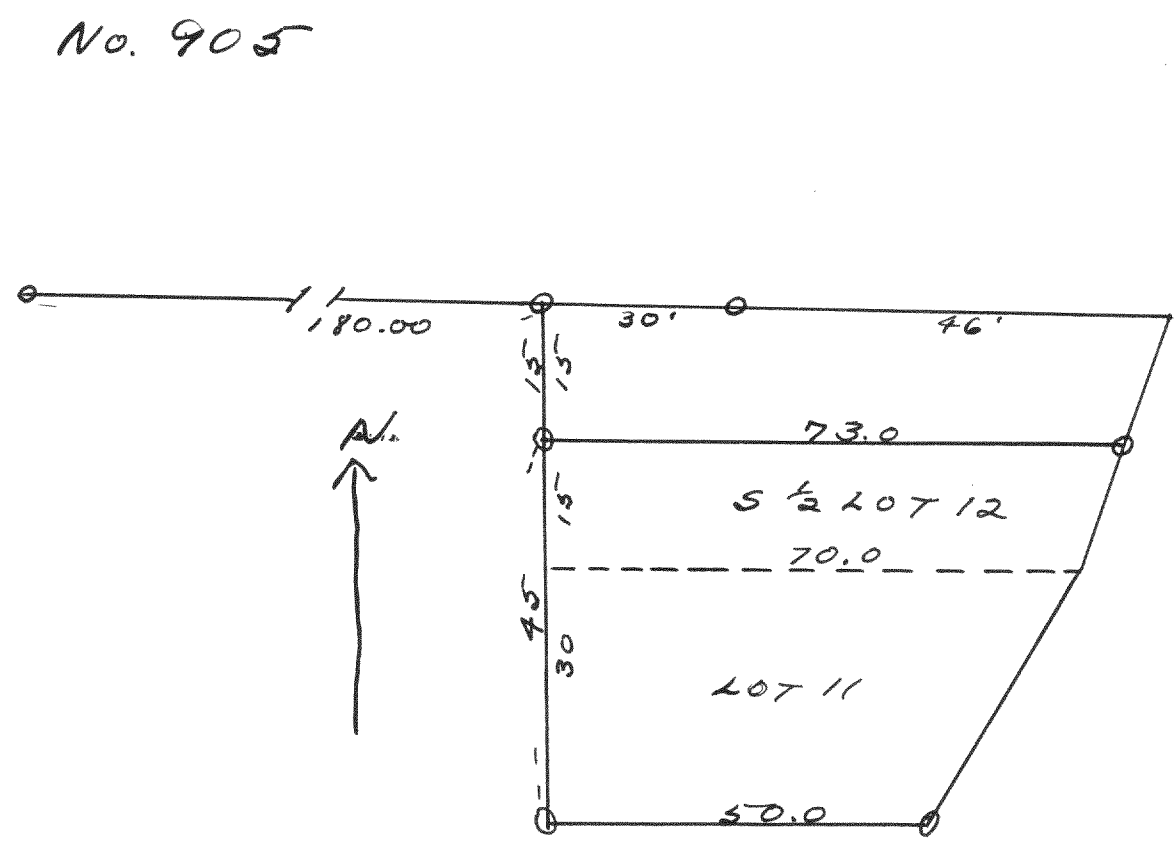

Survey of lot 11 and the
south half of lot 12 block 0
of Pelawan Lake Assembly
Grounds

Nov. 21, 1938 Lloyd L. Jensen
by K.E.J.