


NSURVEY No. 968 ✓

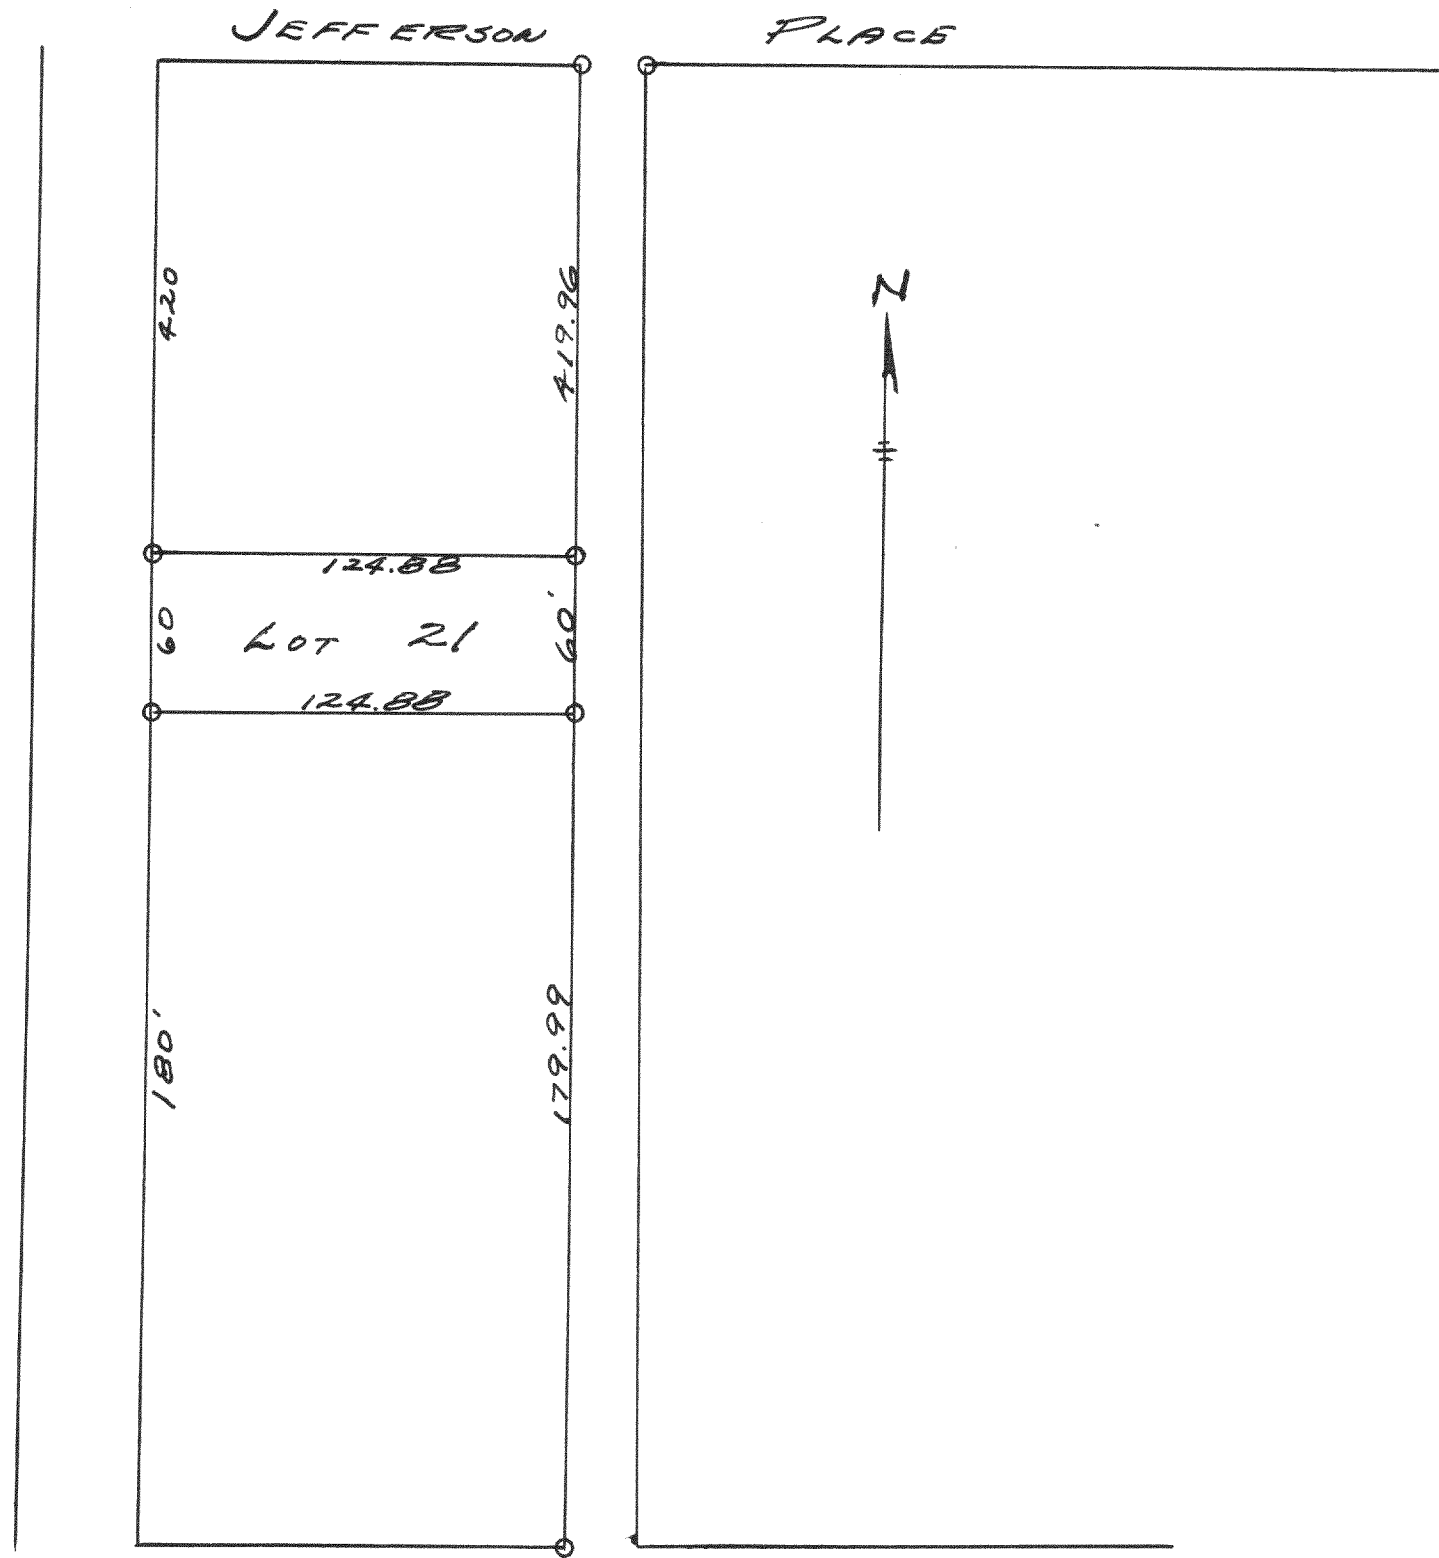


Plat of survey of Lot 21 of the original subdivision of Cedar Point Park in the Village of Wms. Bay.

May 8, 1939

Lloyd L Jensen
by N. E. J.

SURVEY No. 969 ✓

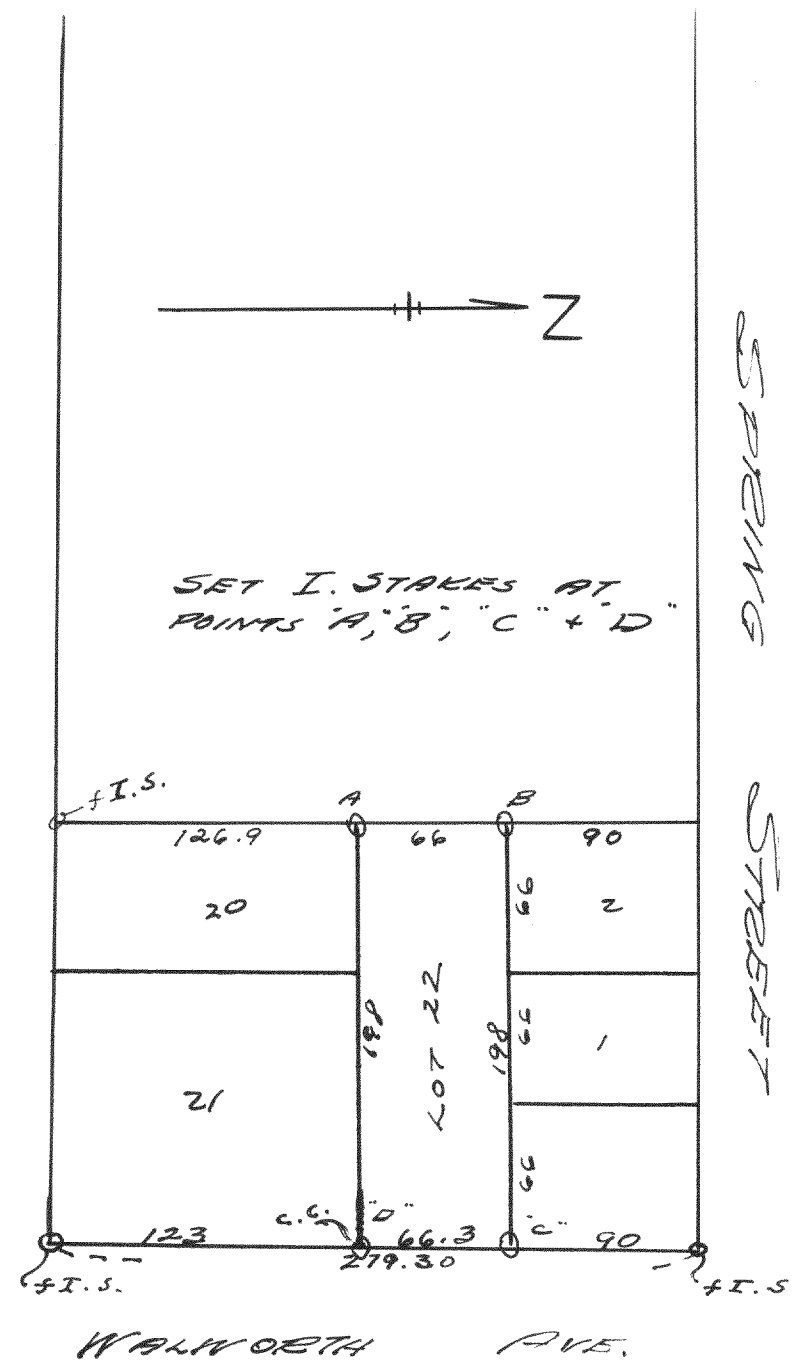

Plat of survey of Lot 22 of Johnson's Addition to the Village of Wms Bay.

Jan., 1939

Lloyd L Jensen
by N. E. J.