


Plat of survey of Lot 44 of  
Lackey Bros. subdivision  
in the Village of Wms. Bay.

June, 1939


Lloyd L. Jensen  
by N.C.J.

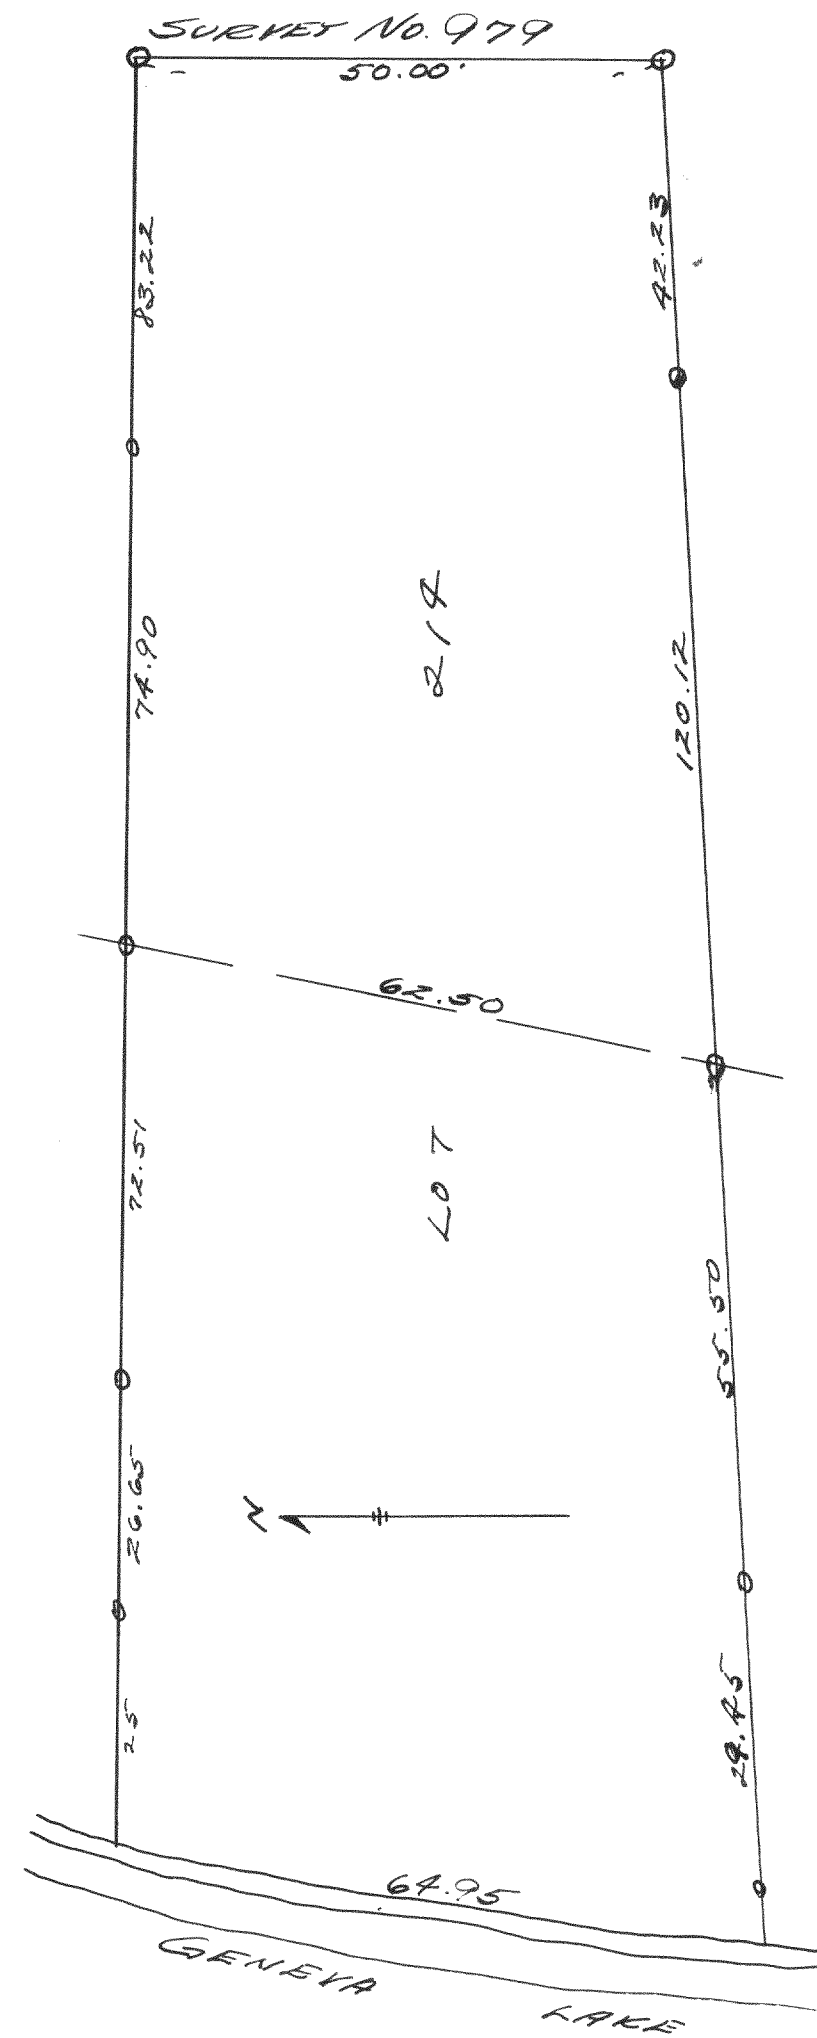

Plat of survey of lot 217 of the  
3<sup>RD</sup> add to Cedar Point Park,  
in the Village of Wms. Bay.

June, 1939

Lloyd L. Jensen  
by N.C.J.

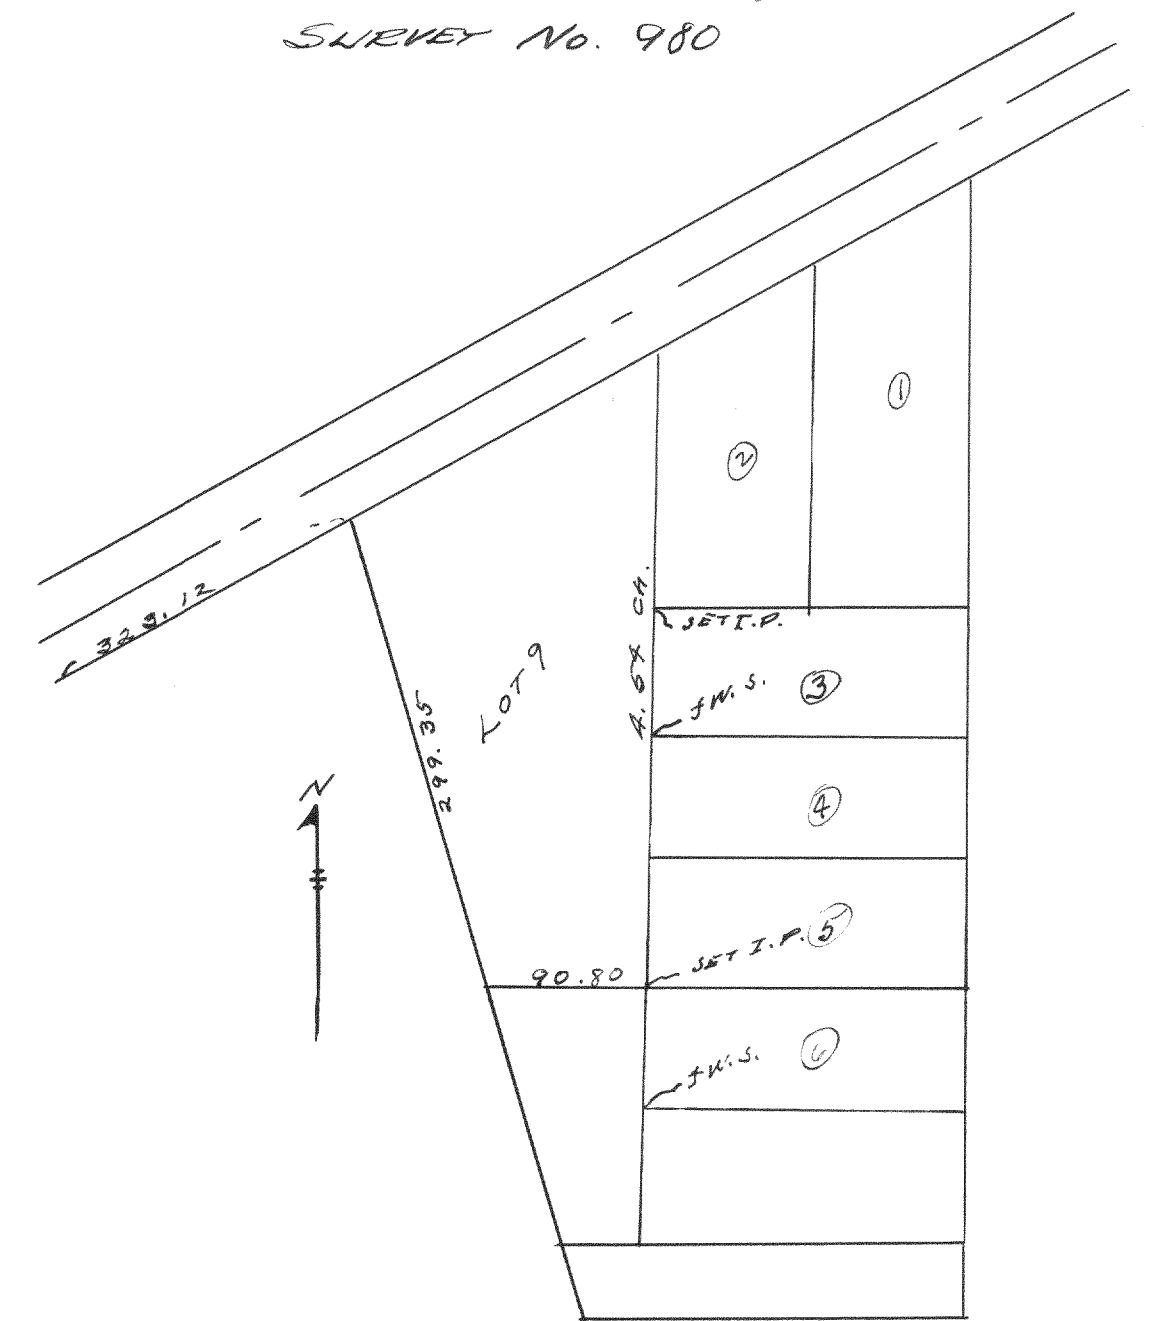

Plat of survey of that part  
of lot 9 which lies north of  
the north line of lot 6  
extended. All in Cairns  
Add. to the city of Whitewater

April 1939

Lloyd L. Jensen  
by N.C.J.