


no 135

Carl Schwabe

Township North of Range 22 4 15 - 1 - 16 4 Principal Meridian

as presented by the courses and distances on the following plat and annexed field-notes of survey:  
 Established the center of the section at the point of intersection of straight quarter lines  
 from corner of Church lot 330 made point This point  
 is 64 + 724.5 + 330 = 1118.5 N of RR line from this point E  
 1441 to stone rods E of an part of 1211 more to line for 1/8 corner  
 N. on RR line from RR line to corner 1600 distance and 3117.5  
 notes of the Government survey.  
 more fence. Transit line run goes over stone and is 11.5  
 W. of stone at R.R. and is 1436 C. of N.W. corner. Ran line  
 on 15 feet E. of NW corner and first mentioned point.  
 This line at RR is 8 E. of corner, angle at RR is 69°-30'  
 This shortens R.R. line 8', SE along RR from corner  
 to line from 715 37 + 11.5 = 1548.5 distance from corner  
 to stone in road.

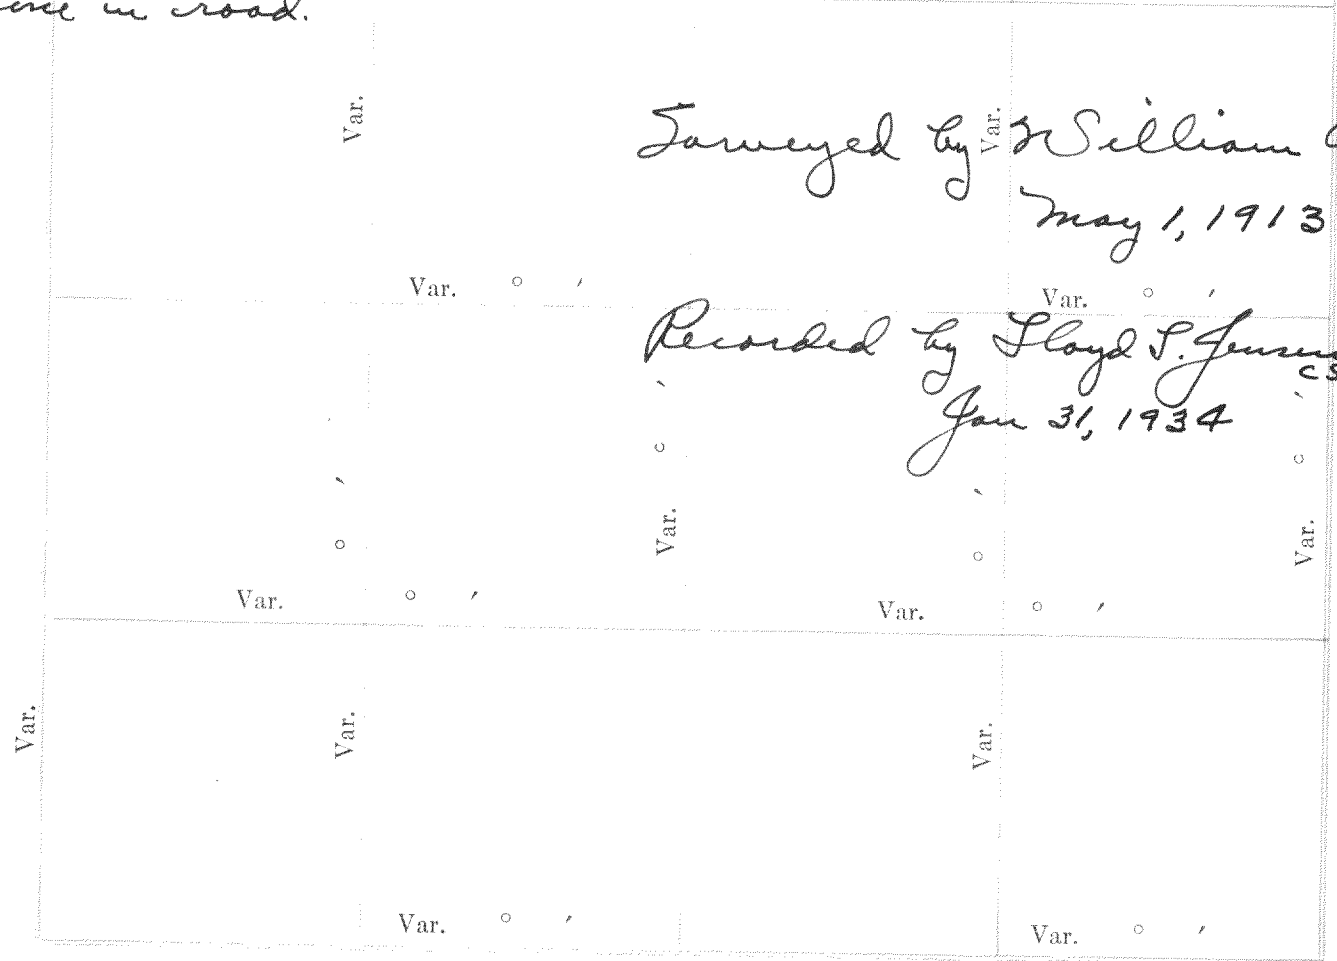

Surveyed by William Child CS. May 1, 1913

Recorded by Lloyd S. Jensen CS. Jan 31, 1934

OF SECTION, QUARTER SECTION AND QUARTER QUARTER SECTION CORNERS

GOVERNMENT CORNERS				H. C. MILLER CO. MFG. STATIONERS. MILWAUKEE WISCONSIN			
No.	Bearing	In.	Links	Bearing	In.	Links	No.
	Trees	Dist.	they bear	Trees	Dist.	they bear	
1.	N. W. Sec. Cor. identified,						1. Center 1/4 Sec. Cor. and on This line make pt. for SW. cor. of old passageway
2.	N. E. Sec. Cor. identified,						2. North 1/4-1/4s N. W. cor lot 13" E. of walk + 2" N. of seam.
3.	S. E. Sec. Cor. identified,						3. East 1/4-1/4s N. W. qr., 66 N. of This is 7" E + 2" N. of NE. cor of cement walk
4.	S. W. Sec. Cor. identified,						4. South 1/4-1/4s N. W. qr., 115.5 N. being rods drive pipe for cor. of blk, being
5.	N. 1/4 Sec. Cor. identified,						5. West 1/4-1/4s N. W. qr., 4" S. of walk + 2" E of seam, find stake at
6.	E. 1/4 Sec. Cor. identified,						6. Center 1/4-1/4s N. W. qr., NW. corner of Wilson lot. Ran to that for S. line of
7.	S. 1/4 Sec. Cor. identified,						7. North 1/4-1/4s N. E. qr., St. from these 2 lines lay out lot rods N + S by
8.	W. 1/4 Sec. Cor. identified,						8. East 1/4-1/4s N. E. qr., 8 Rods E + W.
Subdivision Corners							
9.							9. South 1/4-1/4s N. E. qr.,
10.							10. Center 1/4-1/4s N. E. qr.,
11.							11. East 1/4-1/4s S. E. qr.,
12.							12. South 1/4-1/4s S. E. qr.,
13.							13. West 1/4-1/4s S. E. qr.,
14.							14. Center 1/4-1/4s S. E. qr.,
15.							15. South 1/4-1/4s S. W. qr.,
16.							16. West 1/4-1/4s S. W. qr.,
17.							17. Center 1/4-1/4s S. W. qr.

Walworth Village  
 Stake at NW of Wilson lot pt. at SW  
 of old passageway lot 13" E + 2" N. of seam in walk.  
 SW of Ride out lot 2" N + 7" E of corner of blk in walk  
 E of seam and 4" S of walk.  
 Found stake at NE corner of blk W and take  
 at south end of street on W. line of cross walk  
 being 1' W. of west side of walk. Ran line between these  
 pts and 49.5 E of This line make line for E. line of street  
 and on This line make pt. for SW. cor. of old passageway

Surveyed by William Child CS.  
 Recorded by Lloyd S. Jensen CS.  
 Jan 31, 1934

Plat of Section \_\_\_\_\_, Township \_\_\_\_\_ North, Range \_\_\_\_\_ of 4 Principal Meridian Scale  
 80 chains to 6 inches. The figures in red ink are the lengths of the lines as stated in the field-notes of the  
 Government survey.

Declination of the Magnetic Meridian from the True Meridian \_\_\_\_\_  
 Surveyed and sub-divided \_\_\_\_\_ A. D. 1 \_\_\_\_\_, in accordance  
 with the State Laws and Instructions of the Commissioner of the General Land office, and recorded on pages  
 \_\_\_\_\_ of Register in the County Clerk's office.

Witness my hand this \_\_\_\_\_ day of \_\_\_\_\_ A. D. 1 \_\_\_\_\_  
 \_\_\_\_\_ SURVEYOR.

CHAINMEN \_\_\_\_\_ NAMES OF SWORN ASSISTANTS \_\_\_\_\_  
 FLAGMEN \_\_\_\_\_ AXMEN \_\_\_\_\_

no 137

Walworth Village  
Hanson Oil Co.

Beginning at the  $\frac{1}{4}$  sec. corner on the W. line of said Sec. 22, Thence E. on the  $\frac{1}{4}$  Sec. line 90.5 ft. to a point Thence S 33.5 ft. to an iron stake, at the S. line of Cement walk and 96.5 ft. to an iron stake, Thence E. 11 ft. to an iron stake, Thence S 44 ft. Then W 64.3 ft. to the E. line of the Cement walk, and 99.3 ft. to the  $N 45\frac{1}{4}$  Sec. line, Thence N. on the said  $\frac{1}{4}$  Sec. line 142 ft. to the place of beginning, said grantors reserving for themselves their heirs executors, and assigns, the use of the driveway as it now exists at the present time, on the S side of the real estate herein conveyed, for all purposes of passing to and from all lands of said grantors heretofore reached by said driveway, until such time as a public street or alley shall be provided or laid out by the village of Walworth, which shall communicate with the said lands of said grantors.

William Child  
C.S.

Recorded by Lloyd S. Jensen  
Feb. 1, 1934  
C.S.

no 138



William Child  
C.S.

Recorded by Lloyd S. Jensen  
Feb. 1, 1934  
C.S.