


Record of Survey.

DESCRIPTION

OF SECTION, QUARTER SECTION AND QUARTER QUARTER SECTION CORNERS

Township....., North of Range.....of 4 Principal Meridian
as presented by the courses and distances on the following plat, and annexed field-notes of survey:
Established the center of the section at the point of intersection of STRAIGHT quarter lines.
Established all quarter-quarter corners upon the section boundary at proportional distances between known section and quarter section corners, according to the original field-notes of the Government survey.
Established all lost corners at proportionate distances between known corners, according to the original field notes of the Government survey.

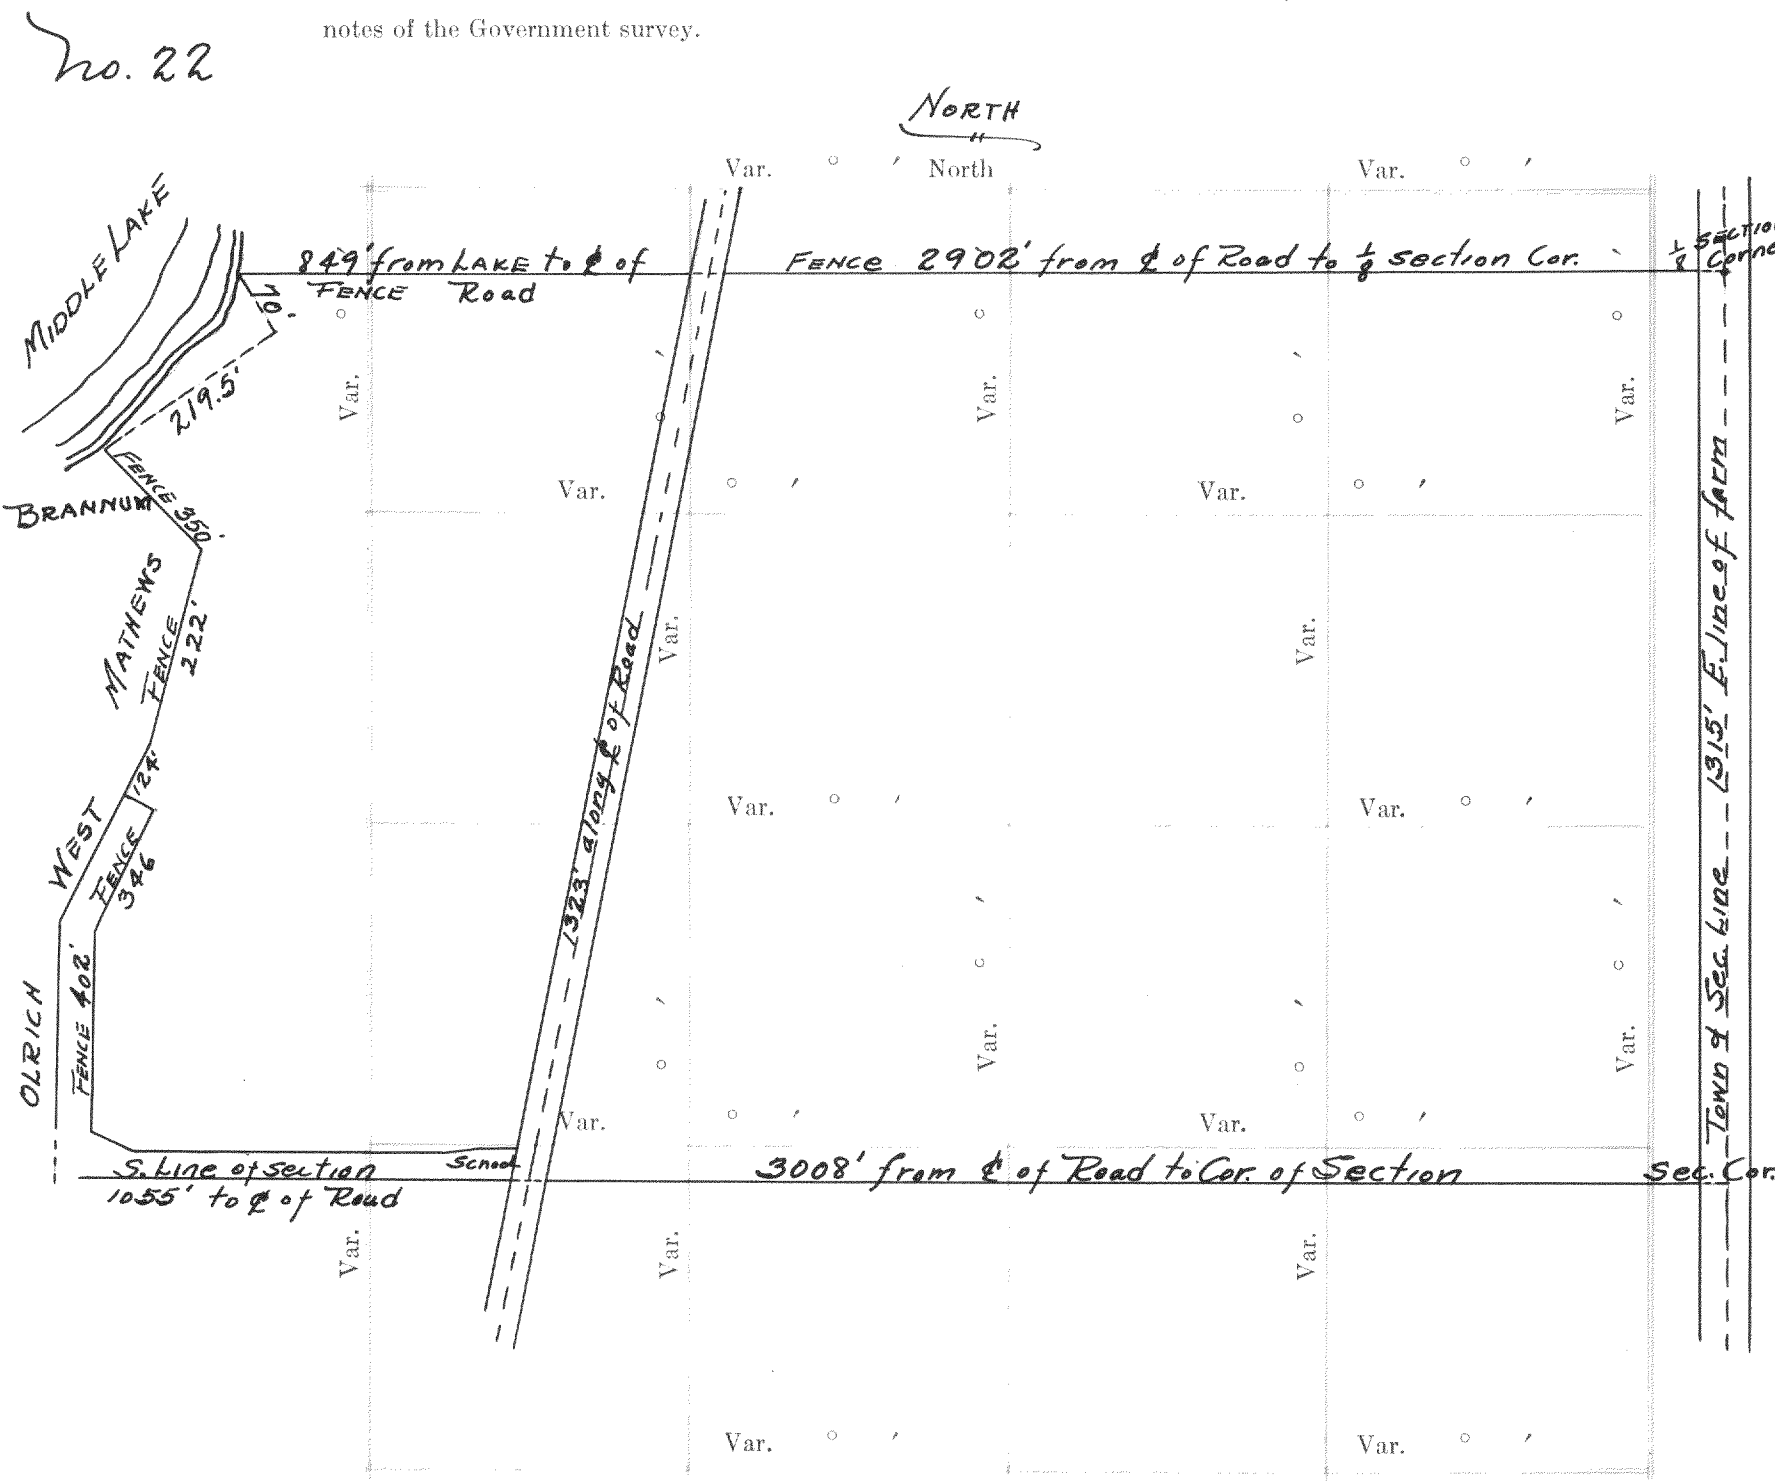

Plat of Section....., Township.....North, Range.....of 4 Principal Meridian Scale
80 chains to 6 inches. The figures in red ink are the lengths of the lines as stated in the field-notes of the
Government survey.
Declination of the Magnetic Meridian from the True Meridian.....
Surveyed and sub-divided.....A. D. 1....., in accordance
with the State Laws and Instructions of the Commissioner of the General Land office, and recorded on pages
.....of Register in the County Clerk's office.
Witness my hand this.....day of.....A. D. 1.....

.....SURVEYOR.

- GOVERNMENT CORNERS
- No.
1. N. W. Sec. Cor. identified,
2. N. E. Sec. Cor. identified,
3. S. E. Sec. Cor. identified,
4. S. W. Sec. Cor. identified,
5. N. $\frac{1}{4}$ Sec. Cor. identified,
6. E. $\frac{1}{4}$ Sec. Cor. identified,
7. S. $\frac{1}{4}$ Sec. Cor. identified,
8. W. $\frac{1}{4}$ Sec. Cor. identified,
Subdivision Corners
No.
1. Center $\frac{1}{4}$ Sec. Cor.
2. North $\frac{1}{4}$ - $\frac{1}{4}$ s N. W. qr.,
3. East $\frac{1}{4}$ - $\frac{1}{4}$ s N. W. qr.,
4. South $\frac{1}{4}$ - $\frac{1}{4}$ s N. W. qr.,
5. West $\frac{1}{4}$ - $\frac{1}{4}$ s N. W. qr.,
6. Center $\frac{1}{4}$ - $\frac{1}{4}$ s N. W. qr.,
7. North $\frac{1}{4}$ - $\frac{1}{4}$ s N. E. qr.,
8. East $\frac{1}{4}$ - $\frac{1}{4}$ s N. E. qr.,
9. South $\frac{1}{4}$ - $\frac{1}{4}$ s N. E. qr.,
10. Center $\frac{1}{4}$ - $\frac{1}{4}$ s N. E. qr.,
11. East $\frac{1}{4}$ - $\frac{1}{4}$ s S. E. qr.,
12. South $\frac{1}{4}$ - $\frac{1}{4}$ s S. E. qr.,
13. West $\frac{1}{4}$ - $\frac{1}{4}$ s S. E. qr.,
14. Center $\frac{1}{4}$ - $\frac{1}{4}$ s S. E. qr.,
15. South $\frac{1}{4}$ - $\frac{1}{4}$ s S. W. qr.,
16. West $\frac{1}{4}$ - $\frac{1}{4}$ s S. W. qr.,
17. Center $\frac{1}{4}$ - $\frac{1}{4}$ s S. W. qr.

Location - $5\frac{1}{2}$, $5\frac{1}{2}$ sec 25, T4N, R16E

Plot of a survey made by the direction of F. M. Porter and O. W. Leach of Elkhorn, Wisconsin to show the length of the lines and the number of acres contained in the farm owned and occupied by R. B. Wilcox. Which farm is the east end of the South half of the South half of section No. 25, Town No. 4 North Range 16 East being the Town of La-Grange, Walworth County, Wisconsin. The lines shown on the West of the plat are the lines of the different owners. And I find there is 117.25 Acres of land enclosed within the lines as shown on the Plat.

Scale of Plat, 1" = 150' Elkhorn Aug. 1st 1925

Wm Child
County Surveyor
Walworth Co. Wisconsin


Recorded Feb. 21, 1933 by
Lloyd S. Jensen
County Surveyor

NAMES OF SWORN ASSISTANTS

CHAINMEN

FLAGMEN

AXMEN

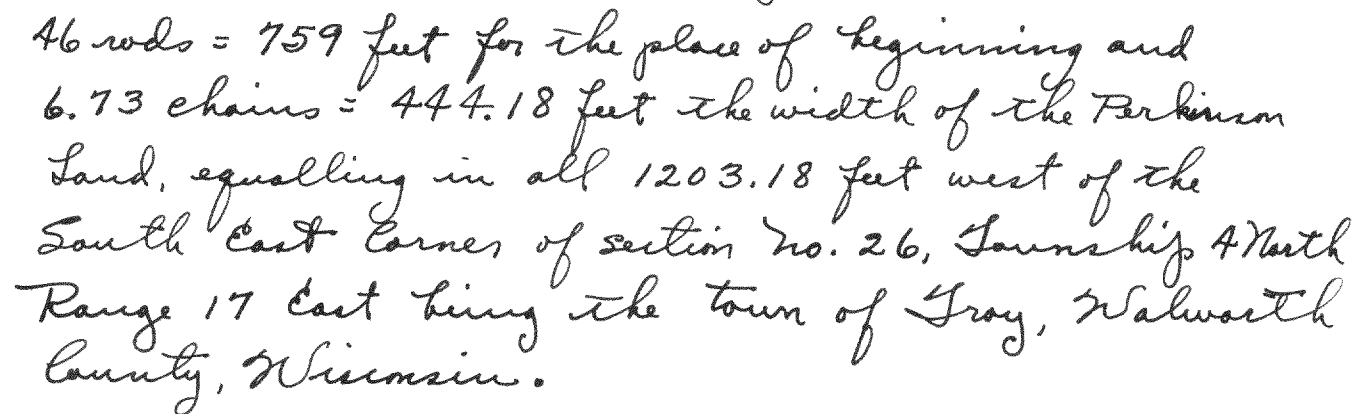


Elkhorn June 11, 1929

From Child

County Surveyor

Recorded Feb. 21, 1933 by Lloyd F. Jensen, County Surveyor.

No. 24

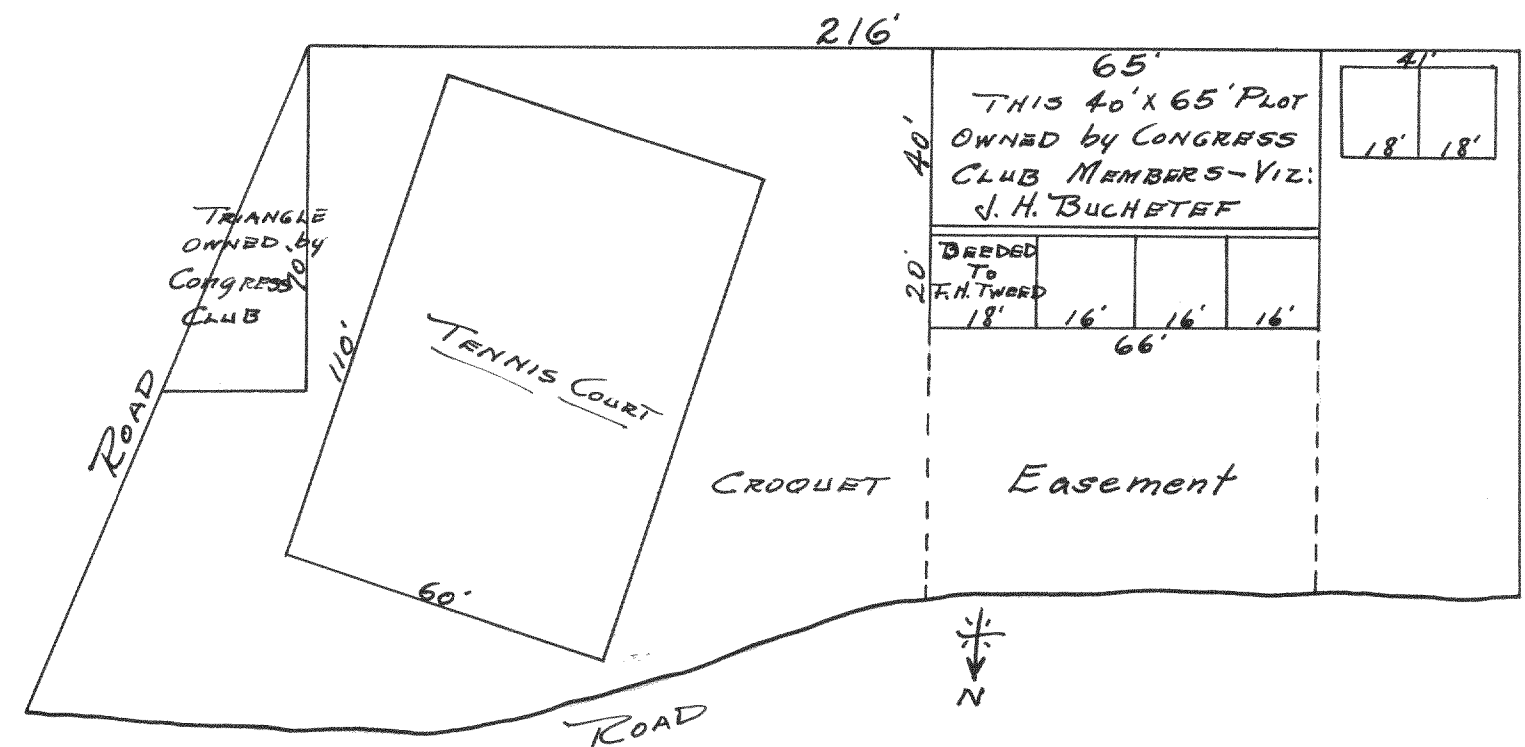

Survey of Tennis Court & Garage Lots of Lock Vista Club.
Location - SW $\frac{1}{4}$ sec 1, T1N, R16E
Tennis Court & Garage Lots - Property of Lock Vista Club,
Williams Bay, Wisconsin

Arlington Engineering Corporation
111 W. Jackson Boulevard
Chicago Illinois

Recorded Feb. 21, 1933 by Lloyd S. Jensen, County Surveyor.