


no 329

Record of Survey


DESCRIPTION

Township....., North of Range.....of 4 Principal Meridian
as presented by the courses and distances on the following plat, and annexed field-notes of survey:
Established the center of the section at the point of intersection of STRAIGHT quarter lines.
Established all quarter-quarter corners upon the section boundary at proportional distances between known section and quarter section corners, according to the original field-notes of the Government survey.
Established all lost corners at proportionate distances between known corners, according to the original field notes of the Government survey.

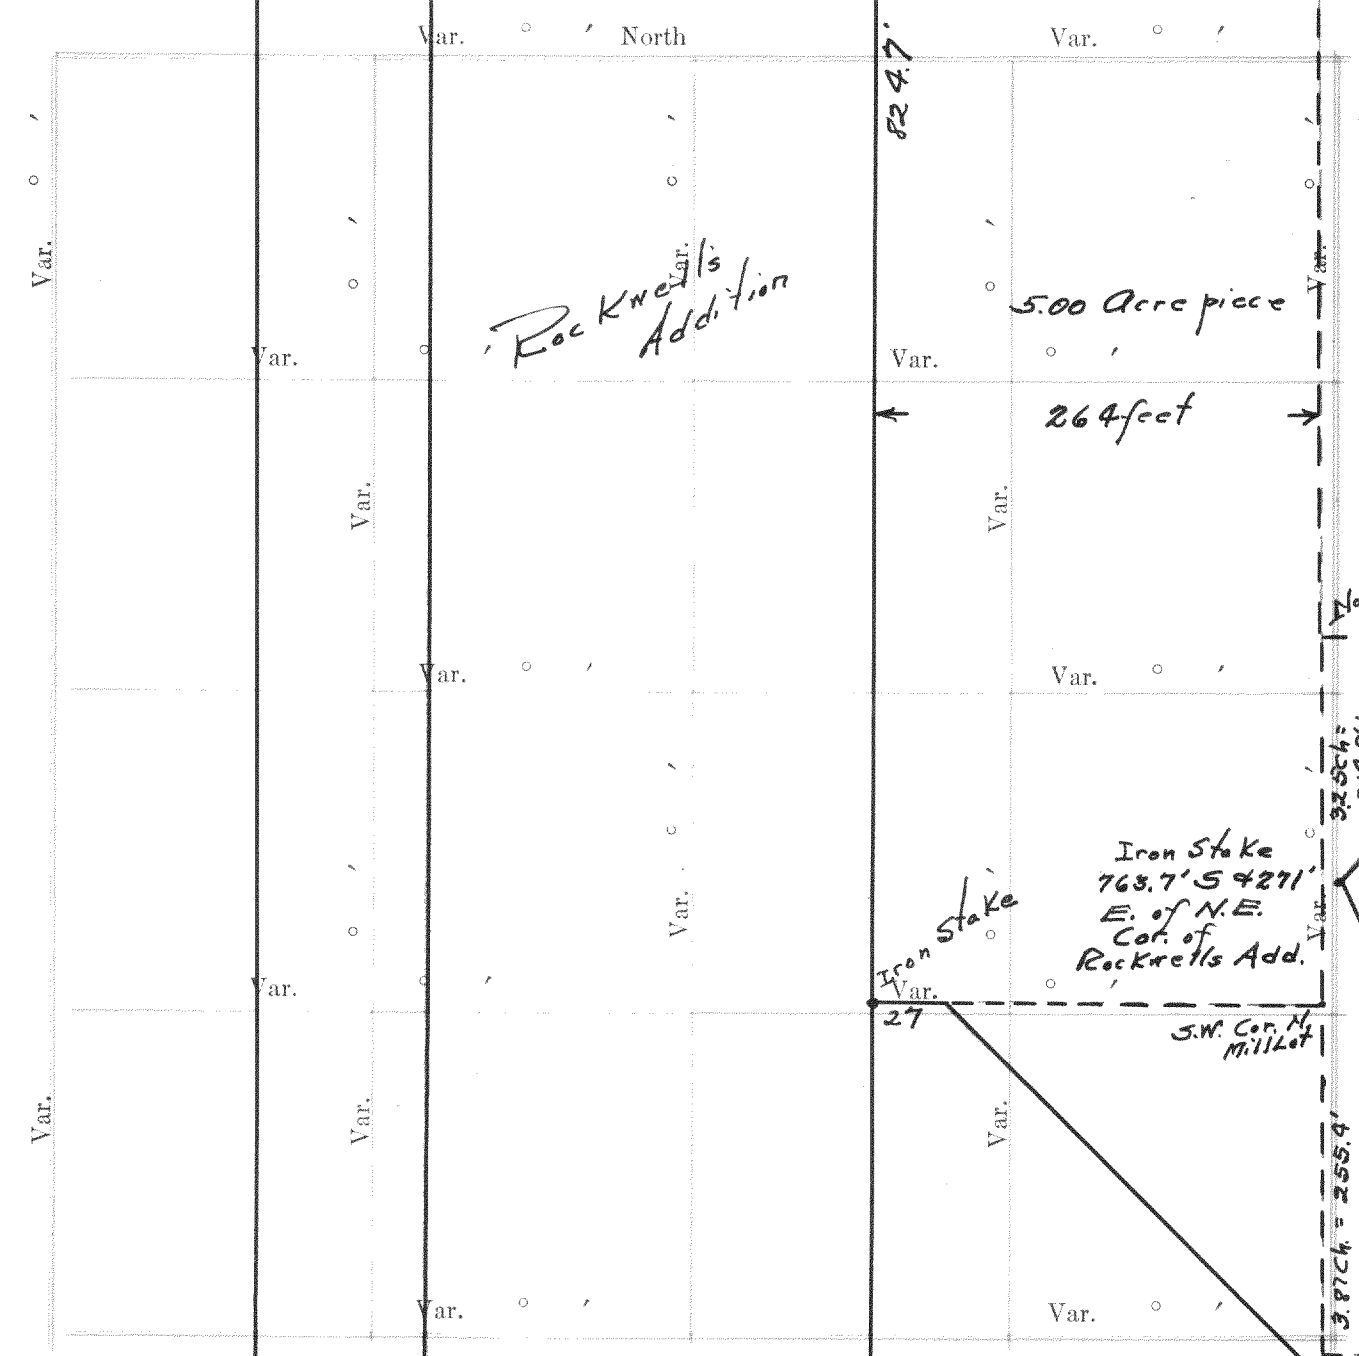

- GOVERNMENT CORNERS
- No. 1. N. W. Sec. Cor. identified,
 - 2. N. E. Sec. Cor. identified,
 - 3. S. E. Sec. Cor. identified,
 - 4. S. W. Sec. Cor. identified,
 - 5. N. 1/4 Sec. Cor. identified,
 - 6. E. 1/4 Sec. Cor. identified,
 - 7. S. 1/4 Sec. Cor. identified,
 - 8. W. 1/4 Sec. Cor. identified,
- Subdivision Corners
- No. 1. Center 1/4 Sec. Cor.
 - 2. North 1/4-1/4s N. W. qr.,
 - 3. East 1/4-1/4s N. W. qr.,
 - 4. South 1/4-1/4s N. W. qr.,
 - 5. West 1/4-1/4s N. W. qr.,
 - 6. Center 1/4-1/4s N. W. qr.,
 - 7. North 1/4-1/4s N. E. qr.,
 - 8. East 1/4-1/4s N. E. qr.,
 - 9. South 1/4-1/4s N. E. qr.,
 - 10. Center 1/4-1/4s N. E. qr.,
 - 11. East 1/4-1/4s S. E. qr.,
 - 12. South 1/4-1/4s S. E. qr.,
 - 13. West 1/4-1/4s S. E. qr.,
 - 14. Center 1/4-1/4s S. E. qr.,
 - 15. South 1/4-1/4s S. W. qr.,
 - 16. West 1/4-1/4s S. W. qr.,
 - 17. Center 1/4-1/4s S. W. qr.,

Bearing	In.	Courses	Links	Bearing	In.	Courses	Links	Bearing	In.	Courses	Links	Bearing	In.	Courses	Links
Trees	Dia.	they bear	Distant	Trees	Dia.	they bear	Distant	Trees	Dia.	they bear	Distant	Trees	Dia.	they bear	Distant

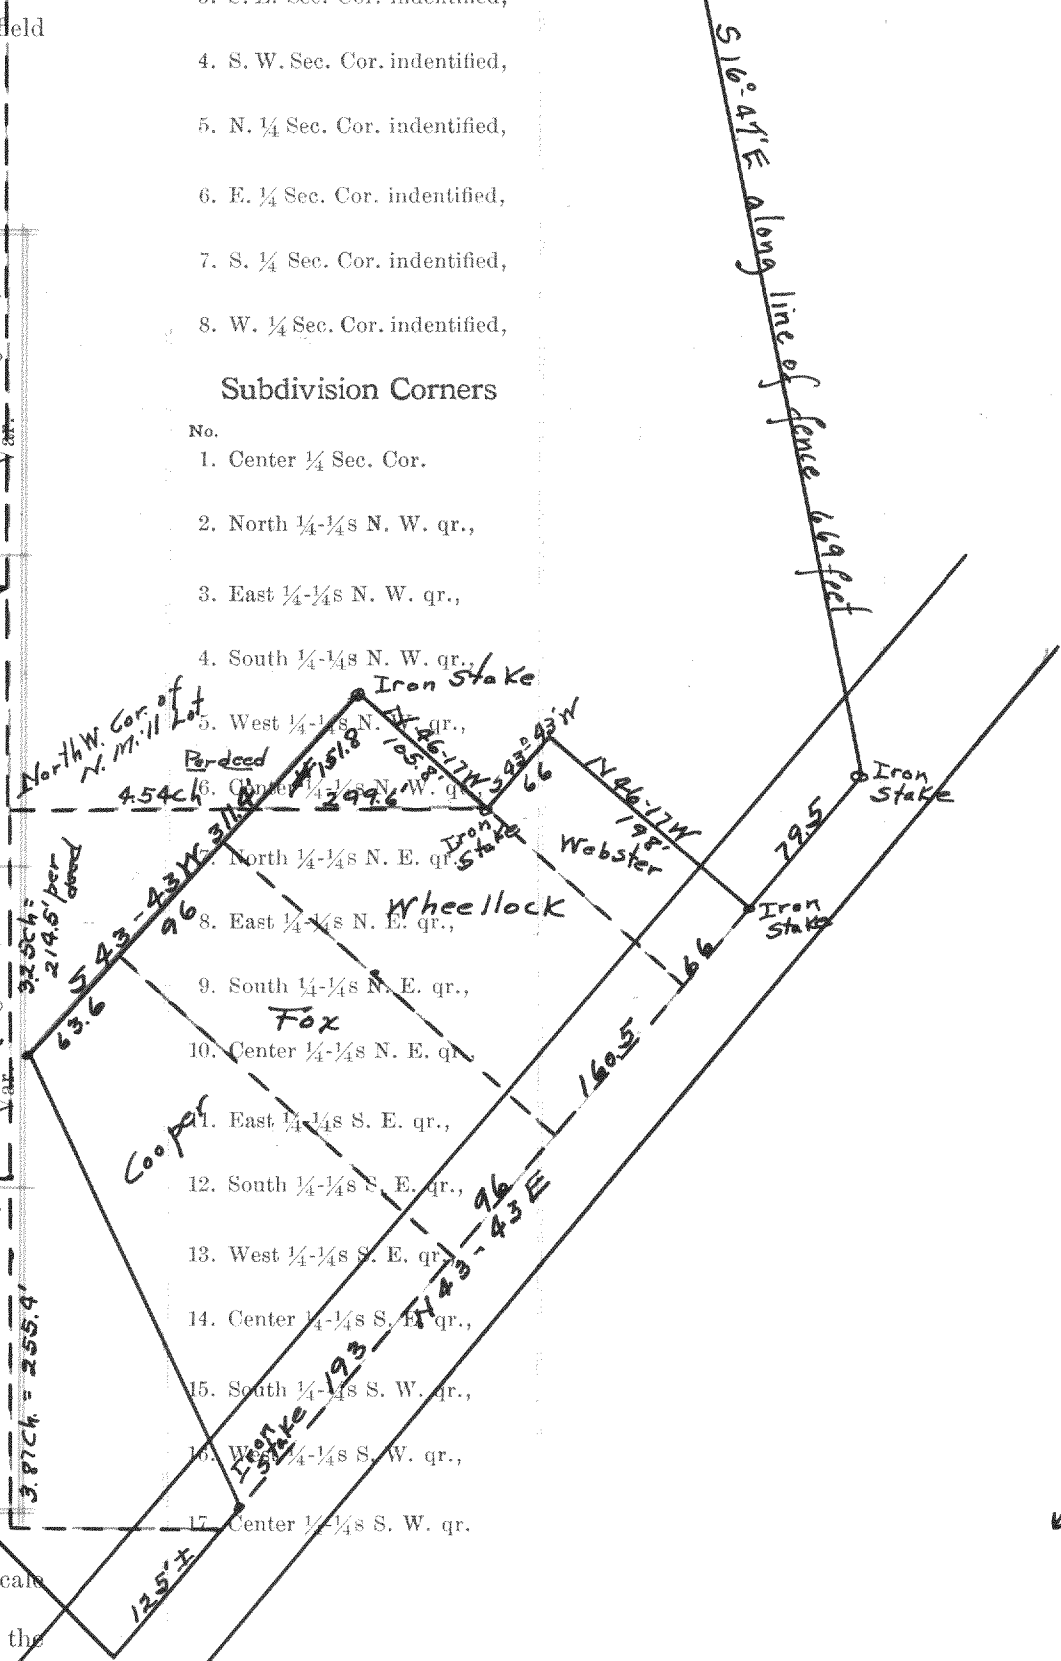

Description on next page -

Plat of Section....., Township.....North, Range.....of 4 Principal Meridian Scale
80 chains to 6 inches. The figures in red ink are the lengths of the lines as stated in the field-notes of the
Government survey.
Declination of the Magnetic Meridian from the True Meridian.....
Surveyed and sub-divided.....A. D. 1.....in accordance
with the State Laws and Instructions of the Commissioner of the General Land office, and recorded on pages
.....of Register in the County Clerk's office.

NAMES OF SWORN ASSISTANTS

CHAINMEN	FLAGMEN	AXMEN

Witness my hand this.....day of.....A. D. 1.....
.....SURVEYOR.

329 cont.

Description from survey

Commencing at a point on The East and West quarter section line of Section 31, Township 3 N, R 17 E at The Northeast corner of Rockwell's Add. to The Village of Elkhorn, according to The recorded plat of said Add.; Thence running East on said quarter section line 612 feet to an iron stake at The corner of lands owned by William McCrossin; Thence South $16^{\circ} 47'$ East along The line of one certain fence 669 feet to an iron stake in The center line of The highway leading from Elkhorn past The Fair grounds and known as The Plank Road; Thence $543^{\circ} 43' W$ along The centerline of said road 79.5 ft. to an iron pipe being The Southeast corner of lands conveyed by Joseph W. Layford & Wife to Japhaniah Short by deed recorded in The Register of Deeds Office in said County in Vol. 26 of Deeds on page 466; Thence $N 46^{\circ} 47' W$ being at right angles to said highway and being The Easterly line of land conveyed to Short as aforesaid 198 feet (equaling 12 Rods) to an iron stake being The Northeast corner of said land; Thence Southwesterly parallel to said highway and in The northerly line of said Short's land 66 feet (equaling 4 rods) to an iron stake on The Easterly line of lands conveyed by J.W. Layford and Wife to J. C. M. Kehlor by deed recorded in said Register of Deeds Office in Volume 52 of Deeds on page 345; Thence $N 46^{\circ} 47' W$, being in a line at right angles to said highway and in The Easterly line of lands so conveyed to said Kehlor 105.5' to an iron stake at The northeasterly corner thereof; Thence $543^{\circ} 43' W$, being in a line parallel to said highway and in The northwesterly line of lands so conveyed to said Kehlor and being also The Southeastery line of lands conveyed by J. C. M. Kehlor & Wife to J. W. Layford by deed dated December 2, 1872 & recorded in said Register's Office in Volume 71 of Deeds on page 59, 371.1 feet to an iron stake being 763.7 feet South and 271 feet East of The Northeast corner of said Rockwell's Add. and being also in line of one certain fence referred to in said deed of J. C. M. Kehlor and Wife to J. W. Layford; Thence $522^{\circ} E$ in a line of said fence 333.5 feet to an iron stake in The center of said Plank Road; Thence Southwesterly in The center of said Plank Road 125 feet more or less to The point of intersection of said center line of said highway with a line 25 feet easterly of and parallel with The centerline of The right of way as surveyed and staked out by The Wisconsin Central Railroad Company and referred to in deed of C. S. Russell to said Company dated January 9, 1854 and recorded in said Register's Office in Volume 19 of deed on page 16; Thence northwesterly along The easterly line of said right of way as above described 475 feet more or less to The East line of The above mentioned Rockwell's Add.; Thence north on said East line to The place of beginning.

Surveyed by Wm Childs

Recorded by Lloyd F. Jensen
March 3, 1934