

Record of Survey.

DESCRIPTION

112

no 341


17-4-18

OF SECTION, QUARTER SECTION AND QUARTER QUARTER SECTION CORNERS

Township..... North of Range..... *7. E. Schaefer* *Principle Meridian*
as presented by the courses and distances on the following plat, and annexed field-notes of survey:

Established the center of the section at the point of intersection of straight quarter lines.
Established all quarter-quarter corners upon the section boundary at proportional distances between known
section and quarter-quarter corners according to the original field-notes of the Government survey.
Established all lost corners at proportionate distances between known corners, according to the original field
notes of the Government survey.
from Southwest line of Pastime Park, laid
off 300 foot lots and was done thru
from the West line of Pastime Park to be
N 53° W and the South side is N 74° 3/4° E
804 feet, then N 1° 30' E 404 to fence post
at the north end of west line fence, this is
from plat.

From corner of Plat N 74° 45' E 125 is
point where line, parallel with and 100 feet from
the west line

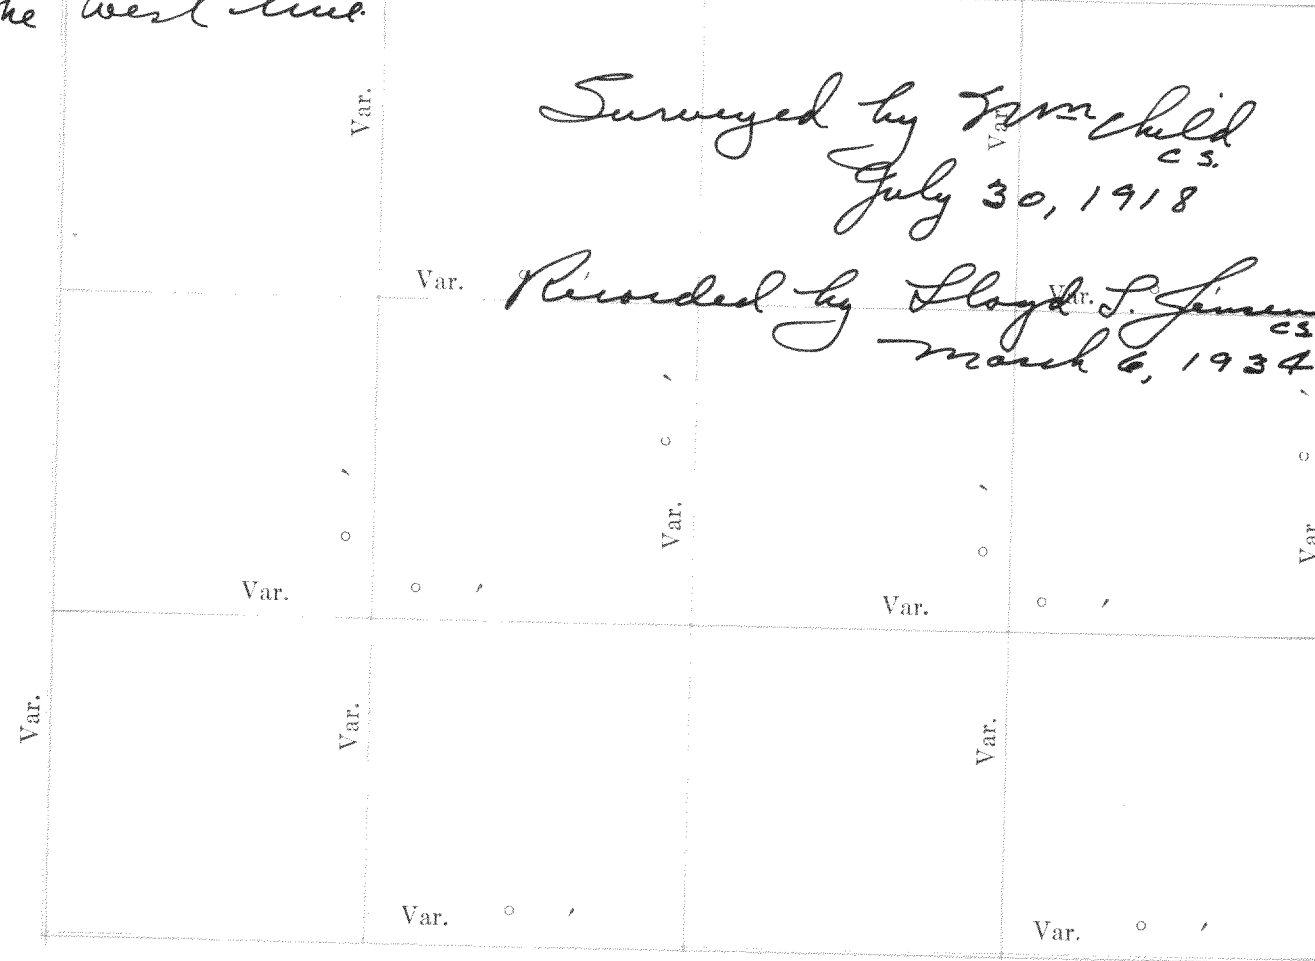

Plat of Section..... Township..... North, Range..... of 4 Principal Meridian Scale
80 chains to 6 inches. The figures in red ink are the lengths of the lines as stated in the field-notes of the
Government survey.

Declination of the Magnetic Meridian from the True Meridian.....
Surveyed and sub-divided..... A. D. 1 , in accordance
with the State Laws and Instructions of the Commissioner of the General Land office, and recorded on pages
..... of Register in the County Clerk's office.

Witness my hand this..... day of..... A. D. 1

SURVEYOR.

GOVERNMENT CORNERS

1. N. W. Sec. Cor. identified,
2. N. E. Sec. Cor. identified,
3. S. E. Sec. Cor. identified,
4. S. W. Sec. Cor. identified,
5. N. 1/4 Sec. Cor. identified,
6. E. 1/4 Sec. Cor. identified,
7. S. 1/4 Sec. Cor. identified,
8. W. 1/4 Sec. Cor. identified,

Subdivision Corners

1. Center 1/4 Sec. Cor.
2. North 1/4-1/8 N. W. qr.,
3. East 1/4-1/8 N. W. qr.,
4. South 1/4-1/8 N. W. qr.,
5. West 1/4-1/8 N. W. qr.,
6. Center 1/4-1/8 N. W. qr.,
7. North 1/4-1/8 N. E. qr.,
8. East 1/4-1/8 N. E. qr.,
9. South 1/4-1/8 N. E. qr.,
10. Center 1/4-1/8 N. E. qr.,
11. East 1/4-1/8 S. E. qr.,
12. South 1/4-1/8 S. E. qr.,
13. West 1/4-1/8 S. E. qr.,
14. Center 1/4-1/8 S. E. qr.,
15. South 1/4-1/8 S. W. qr.,
16. West 1/4-1/8 S. W. qr.,
17. Center 1/4-1/8 S. W. qr.

Bearing	In.	Courses	Links	Bearing	In.	Courses	Links	Bearing	In.	Courses	Links	Bearing	In.	Courses	Links
Trees	Dia.	they bear	Distant	Trees	Dia.	they bear	Distant	Trees	Dia.	they bear	Distant	Trees	Dia.	they bear	Distant

no 342

Converse Sub. in Melavan City
Block 1, lots 9 & 10

Dr. Weiss
Find iron stake at Southeast at
Block and Southwest corner 12, Block 2
Ran line and at 49.5 west of Southeast corner
find stake hole. Drive iron stake for
Southeast and Southwest corner of lot 9 and
10. From Southwest of lot 7 to iron stake
at Northwest corner is 161 feet.
Plot is 160.3 not knowing plat
Set iron stakes for northeast of lot 10
and Northwest of 9, at 161 north of
Street line being .7' in alley.

Surveyed by Wm. Child
Mar. 21, 1921

Recorded by Lloyd S. Jensen
March 6, 1934

NAMES OF SWORN ASSISTANTS

CHAINMEN

FLAGMEN

AXMEN

no 343

Lym
C. C. Reeve

In center of road at Southeast corner of lot 7 found stake, drove iron stake also 290.2 feet Southwest in center of street found stake, iron stake also found stake in center of Street 68 feet west of stone. Ran line over last two stakes on south and set stake 33 feet east of center of Street at corner of Lantz plat. At stake in center of street at S.E. of 7 turned off R.R. West and set stake 33 feet west from this South 135 feet to point hole 100 feet from R.R. track, from stake on W. of Street N. found measurements to correspond with fences and points said to be known, drove stake at Southeast of 7. Northeast 460 feet and left hub then 208.8 ft. found

Surveyed by Wm Child^{CS.}
Aug. 9, 1901

Recorded by Lloyd S. Jensen^{CS.}
March 8, 1934

no. 344

10-2-18 Lyons

Found iron stake at northwest corner of Martin motor piece on S. of road, from this measured east along road 990 = 653.4 feet being the distance shown on a plat, this comes to East of Miller stump, set back about 60 feet and drive iron stake on or near this line and 95 ft. Southeast of this drive iron stake, 10 feet from pond, on line of these stakes, drive 3 iron stakes 52.4 feet Northwest and which stake is in line with the South side of iron on the South side of the bridge and is 236.7 from the large bolt in the iron work on said bridge.

Surveyed by Wm Child^{CS.}
Dec. 15, 1911

Recorded by Lloyd S. Jensen^{CS.}
March 8, 1934