

DESCRIPTION

Record of Survey.

Observatory Sub.

no 351

Township....., North of Range.....of 4 Principal Meridian

as presented by the courses and distances on the following plat, and annexed field-notes of survey:

Established the center of the section at the point of intersection of STRAIGHT quarter lines.

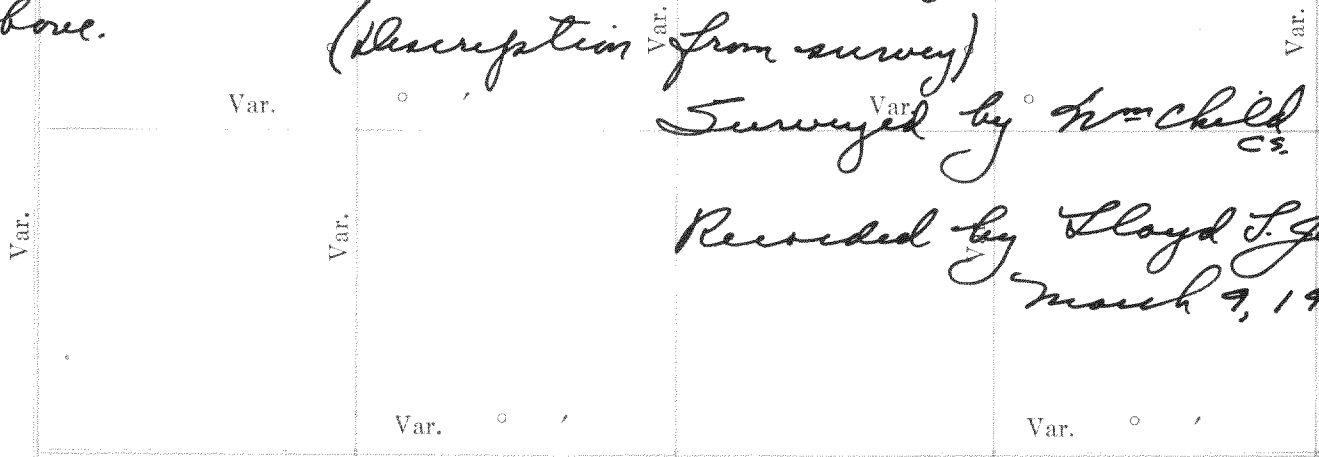
Established all quarter-quarter corners upon the section boundary at proportional distances between known

section and quarter section corners, according to the original field notes of the Government survey.

Established all lost corners at proportionate distances between known corners, according to the original field

notes of the Government survey.

Beginning at the northwest corner of Lot 5 in The Observatory Subdivision so-called, in the Southwest quarter of Section 1, T1N, R16E, according to the plat thereof of said subdivision as recorded in the office of the Register of Deeds in and for said County of Walworth, Thence running due East along lot line eighty one and one half feet to West boundary line of land now owned by Joseph Luekey and purchased of said parties of the first part; Thence South along said west boundary line two hundred feet (200); Thence west along north boundary of said lands owned by Joseph Luekey 81.5 feet; Thence north 200 feet to place of beginning, excepting a strip 20 feet wide off the west side of parcel described above.



Plat of Section....., Township.....North, Range.....of 4 Principal Meridian Scale

80 chains to 6 inches. The figures in red ink are the lengths of the lines as stated in the field-notes of the

Government survey.

Declination of the Magnetic Meridian from the True Meridian.....

Surveyed and sub-divided.....A. D. 1, in accordance

with the State Laws and Instructions of the Commissioner of the General Land office, and recorded on pages

.....of Register in the County Clerk's office.

Witness my hand this.....day of.....A. D. 1

.....SURVEYOR.

OF SECTION, QUARTER SECTION AND QUARTER QUARTER SECTION CORNERS

H. C. MILLER CO. MFG. STATIONERS, MILWAUKEE X15000															
GOVERNMENT CORNERS															
No.	Bearing	In.	Courses	Links	Bearing	In.	Courses	Links	Bearing	In.	Courses	Links	Bearing	In.	Courses
	Trees	Dia.	they bear	Distant	Trees	Dia.	they bear	Distant	Trees	Dia.	they bear	Distant	Trees	Dia.	they bear
1.	N. W. Sec. Cor. identified,														
2.	N. E. Sec. Cor. identified,														
3.	S. E. Sec. Cor. identified,														
4.	S. W. Sec. Cor. identified,														
5.	N. ¼ Sec. Cor. identified,														
6.	E. ¼ Sec. Cor. identified,														
7.	S. ¼ Sec. Cor. identified,														
8.	W. ¼ Sec. Cor. identified,														
Subdivision Corners															
No.															
1.	Center ¼ Sec. Cor.														
2.	North ¼-¼s N. W. qr.,														
3.	East ¼-¼s N. W. qr.,														
4.	South ¼-¼s N. W. qr.,														
5.	West ¼-¼s N. W. qr.,														
6.	Center ¼-¼s N. W. qr.,														
7.	North ¼-¼s N. E. qr.,														
8.	East ¼-¼s N. E. qr.,														
9.	South ¼-¼s N. E. qr.,														
10.	Center ¼-¼s N. E. qr.,														
11.	East ¼-¼s S. E. qr.,														
12.	South ¼-¼s S. E. qr.,														
13.	West ¼-¼s S. E. qr.,														
14.	Center ¼-¼s S. E. qr.,														
15.	South ¼-¼s S. W. qr.,														
16.	West ¼-¼s S. W. qr.,														
17.	Center ¼-¼s S. W. qr.														

no 352

Wm Bay

1-1-16

At 1/8 post red corner of block 24.75 North and 24.75 West from this. West 6 lots - 66 by 132, 1-66 feet lot is 177.2 on East & 122.5 feet on West. This point is 148.2 on South and 195.3 on North, on East side 2 lots are 66 x 132, then 1-66 x 66 then northeast corner lot is 175.8 on east, lots on north are 86.9.

Surveyed by Wm Child
CS.
April 15, 1915

Recorded by Lloyd S. Jensen
CS.
March 9, 1934

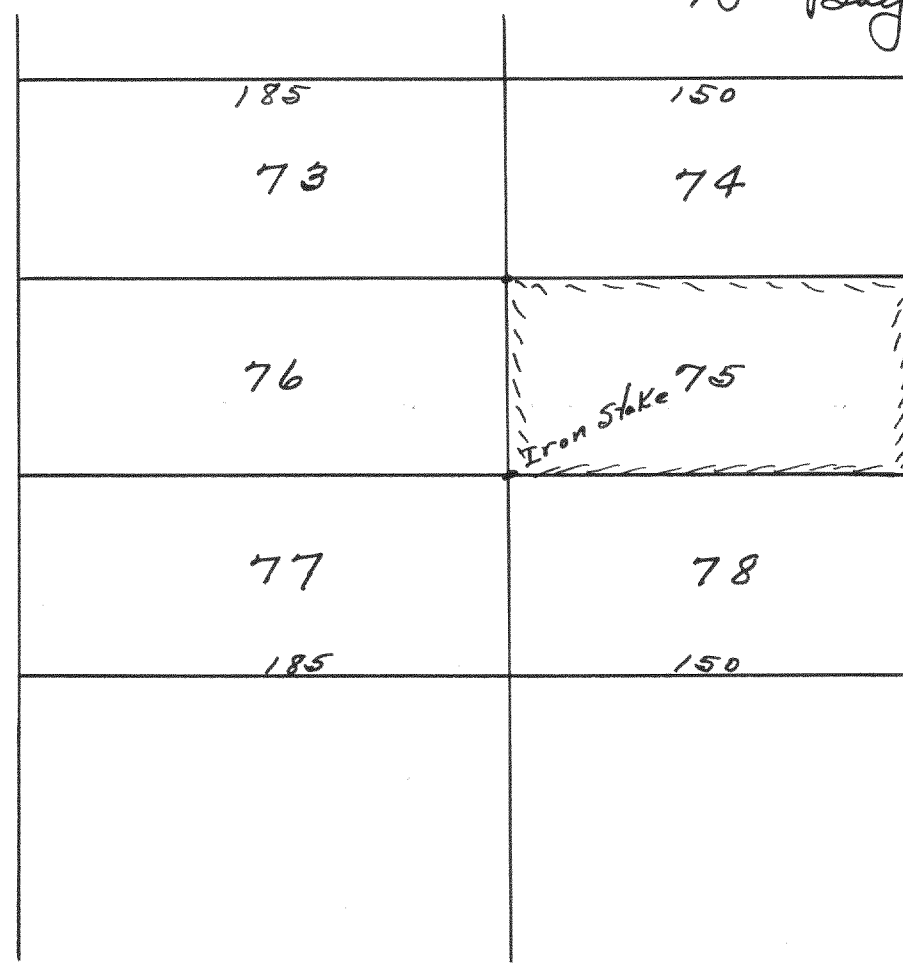
NAMES OF SWORN ASSISTANTS

CHAINMEN

FLAGMEN

AXMEN

no 353

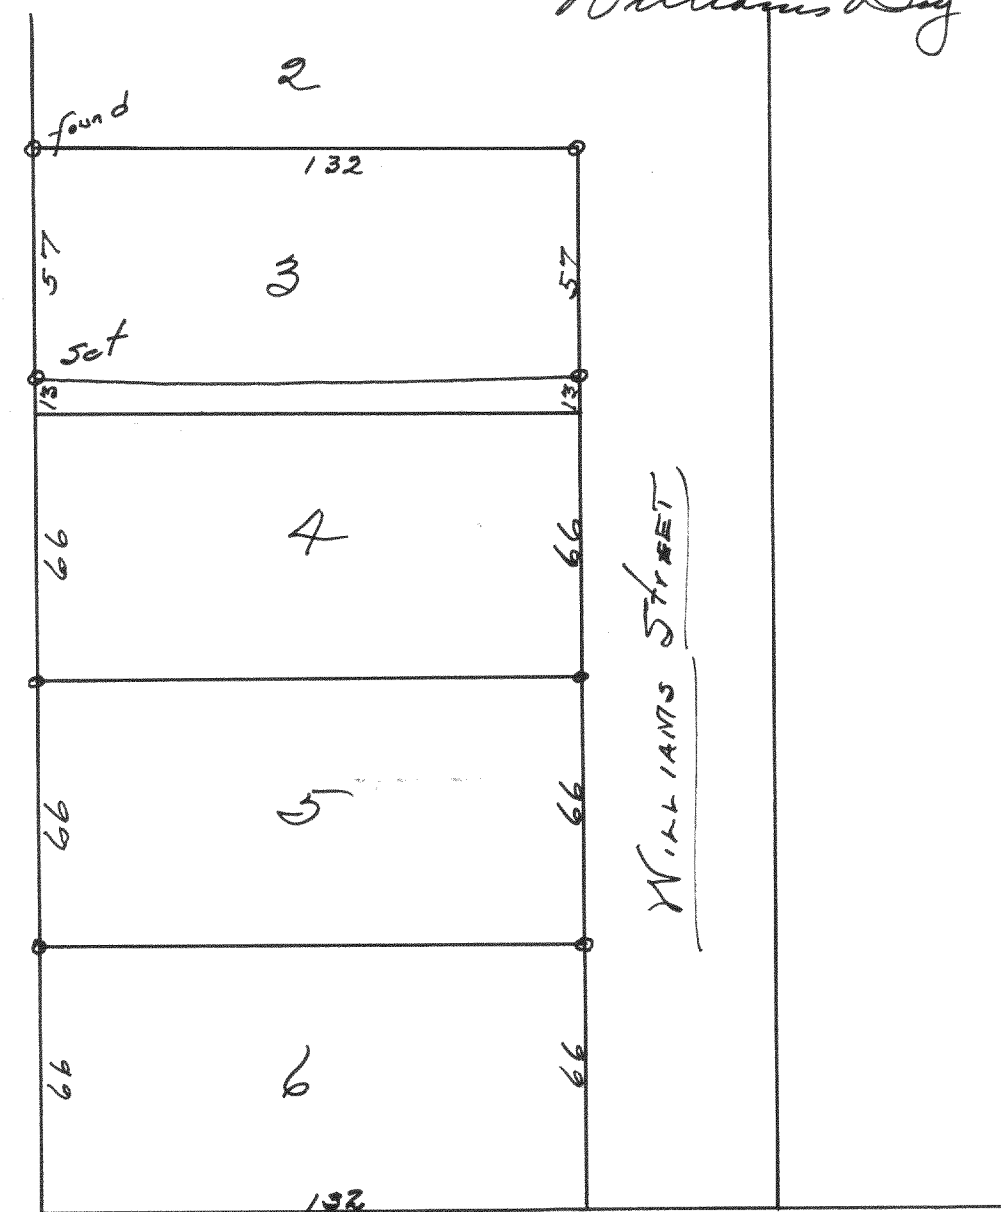
Bay View Subdivision
Wm Bay.

Plot of survey of Lot 75 of
Bay View Sub. in The Village of
Wm Bay.

Surveyed by Wm Child
C.S.

Recorded by Lloyd J. Jensen
C.S.
March 9, 1934

no 354

Original Town of
Williams Bay

Plot of survey of part of The
original Town of Williams Bay. for
B. W. Stenstrom.

Surveyed by Wm Child
C.S.

Recorded by Lloyd J. Jensen
C.S.
March 9, 1934