


no. 360

WILLIAMS BAY BLOCK 3

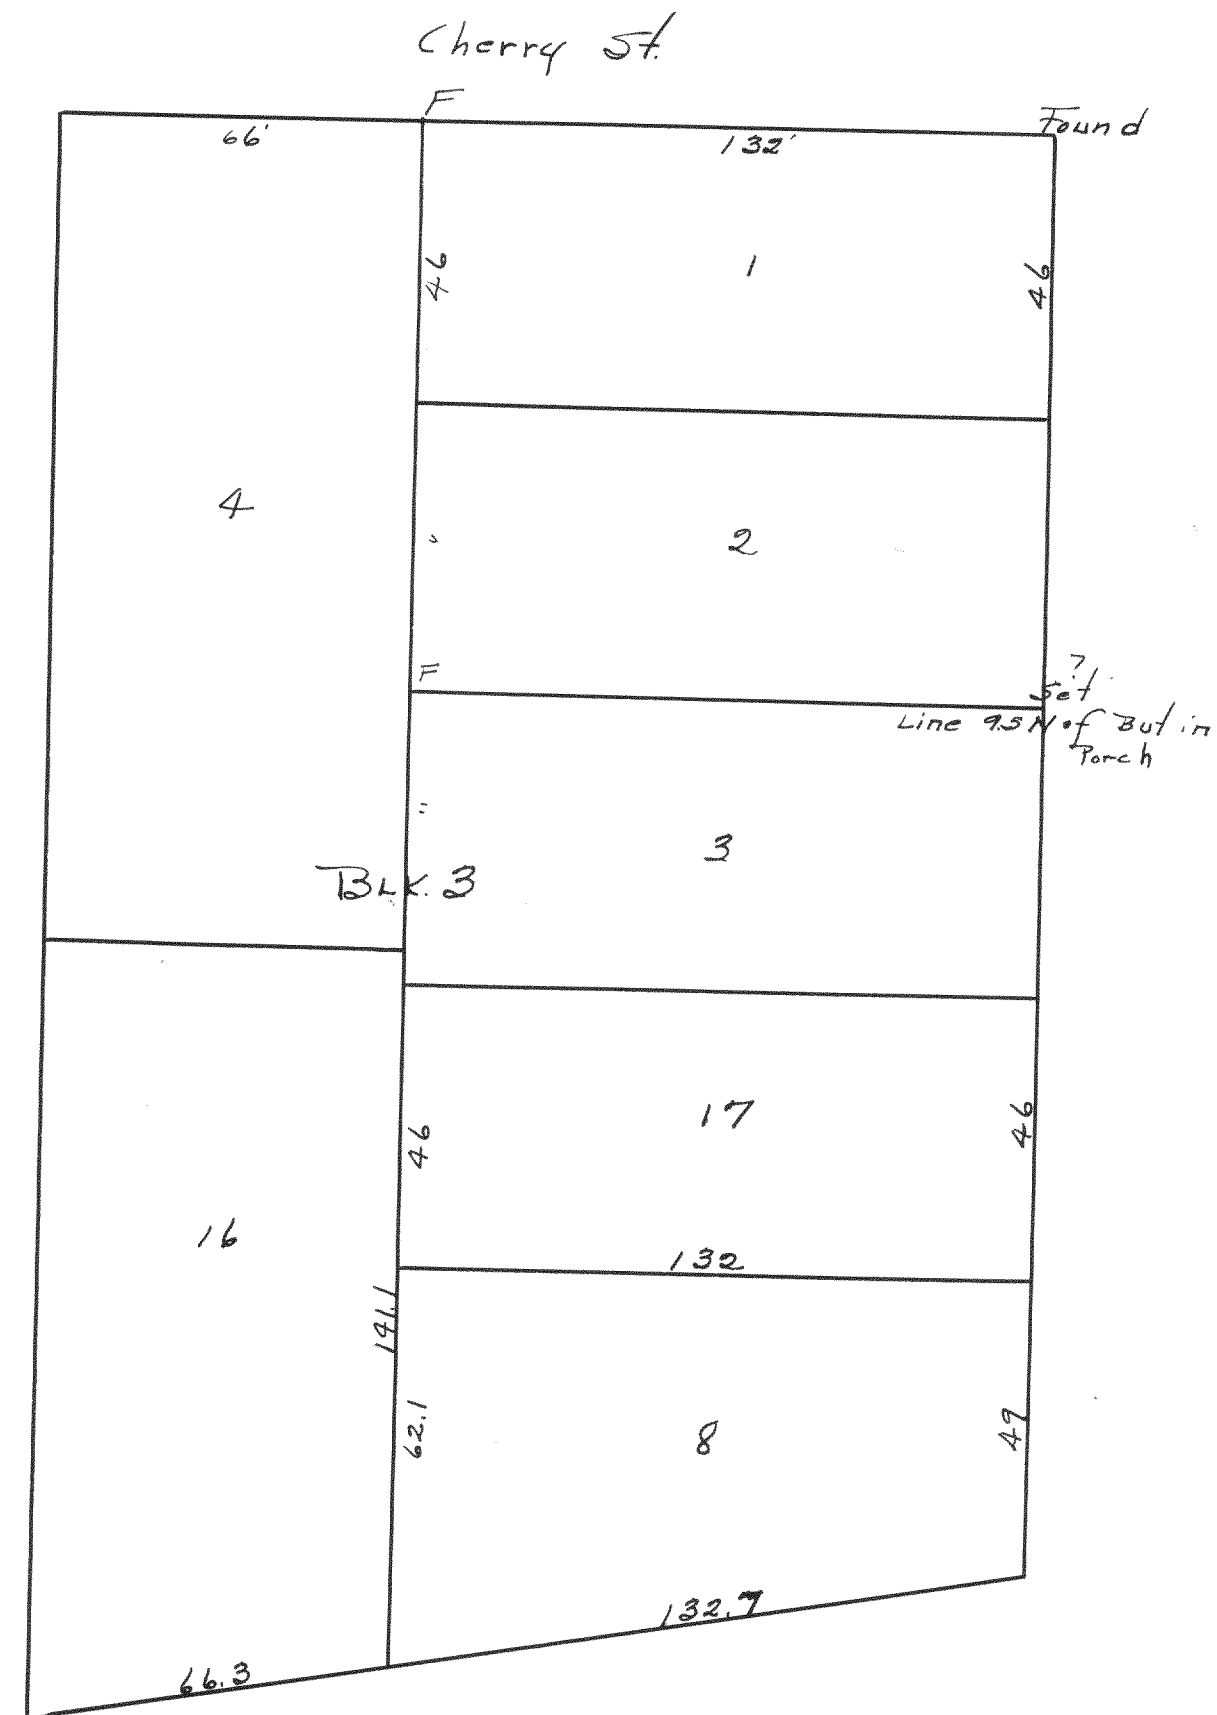


Plot of survey in Block 3 of
original town of Williams Bay.

Surveyed by W. A. Child
C.S.

Recorded by Lloyd S. Jensen
March 9, 1934

No 361

WILLIAMS BAY

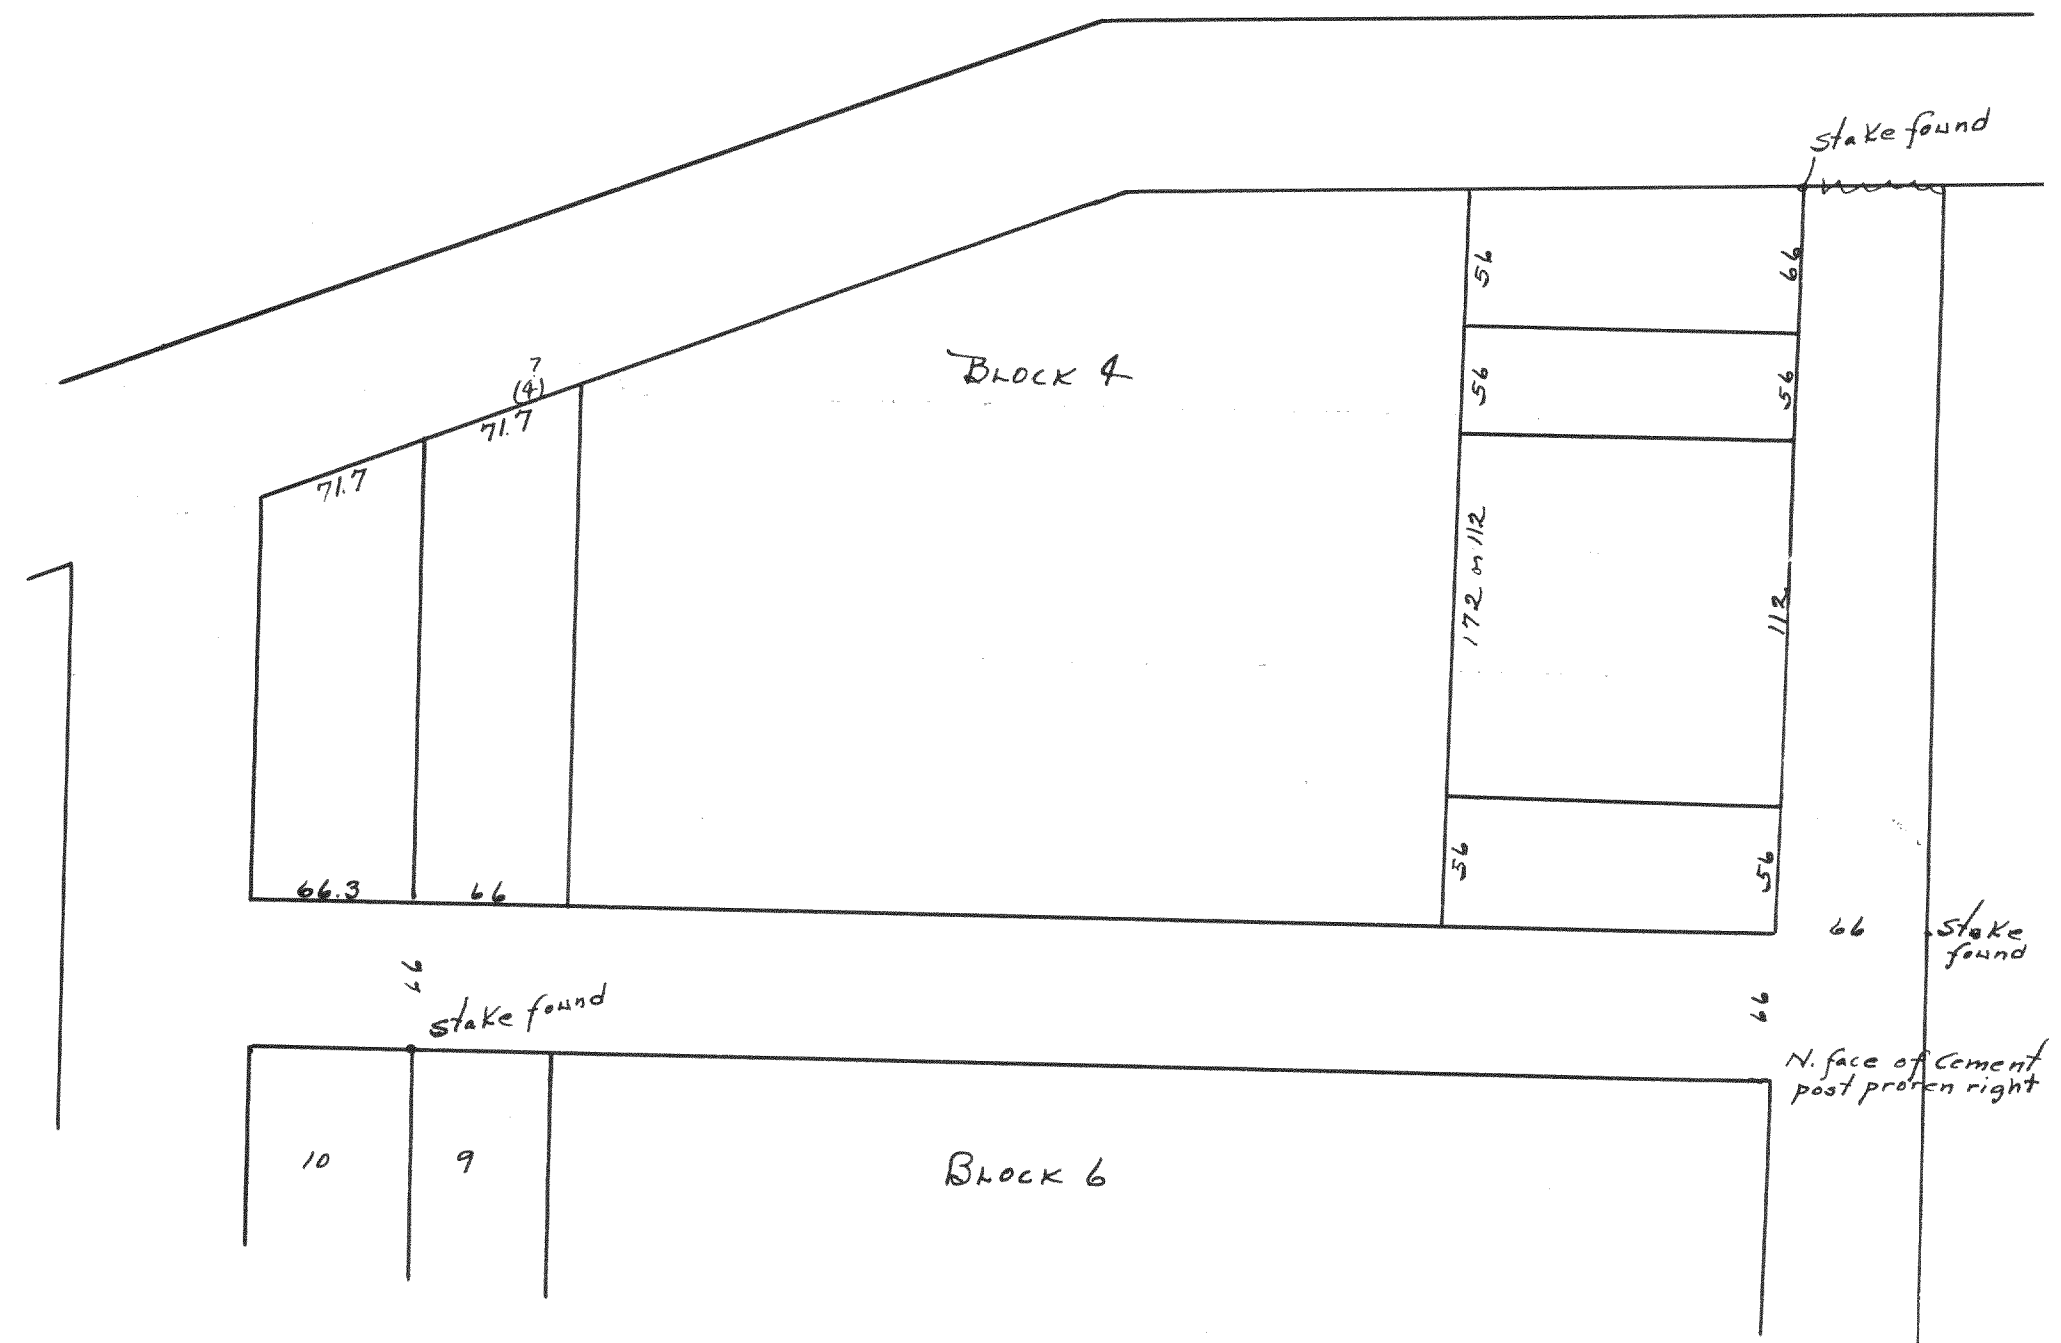

Plot of survey in Block 4 of original town
of Williams Bay.

Surveyed by Wm Child
CS
Recorded by Lloyd S. Linsam
CS
March 9, 1934