

Record of Survey.
WALWORTH VILLAGE

DESCRIPTION

120


No 364

OF SECTION, QUARTER SECTION AND QUARTER QUARTER SECTION CORNERS

Township....., North of Range..... of 4 Principal Meridian
as presented by the courses and distances on the following plat, and annexed field-notes of survey:
Established the center of the section at the point of intersection of STRAIGHT quarter lines.
Established all quarter-quarter corners upon the section boundary at proportional distances between known section and quarter section corners, according to the original field-notes of the Government survey.
Established all lost corners at proportionate distances between known corners, according to the original field notes of the Government survey.

POWER HOUSE & RAILROAD LAND

C. H & L. G. TRACK

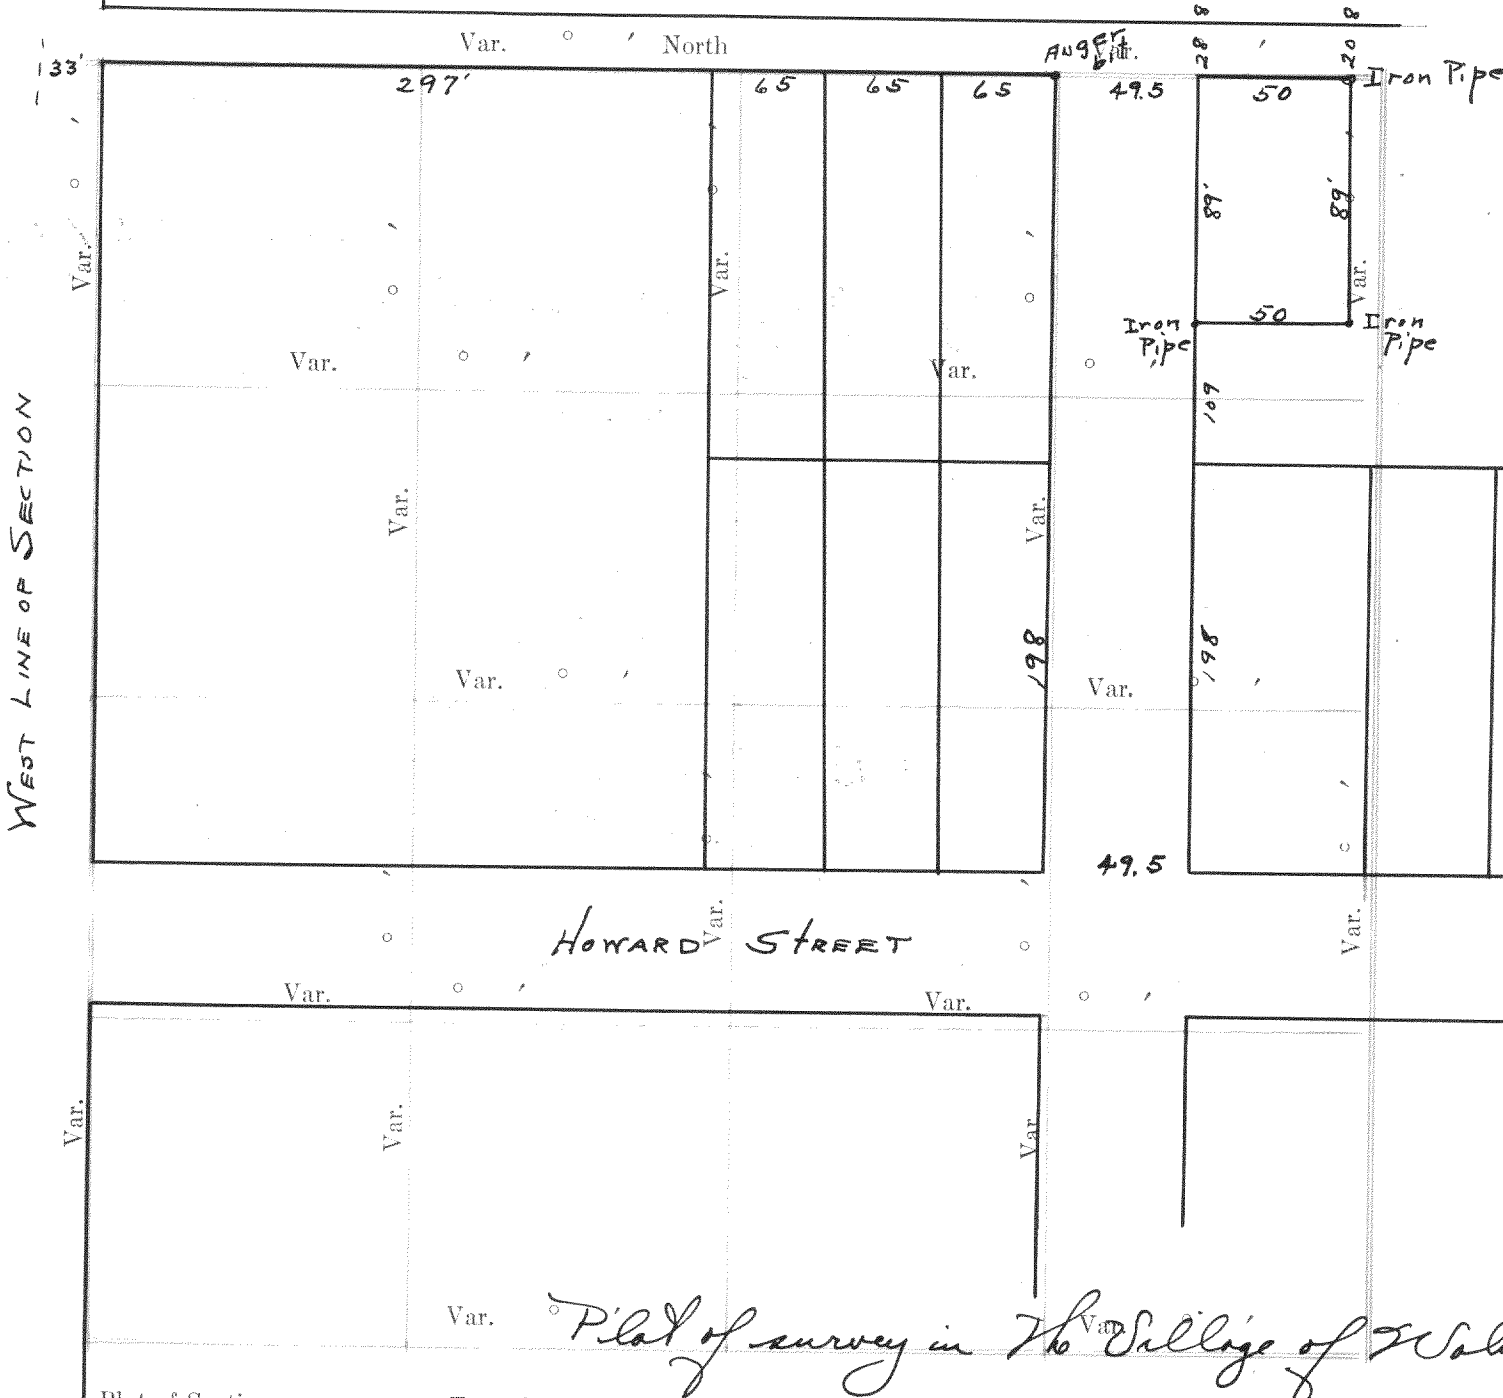


- GOVERNMENT CORNERS
- No.
1. N. W. Sec. Cor. identified,
 2. N. E. Sec. Cor. identified,
 3. S. E. Sec. Cor. identified,
 4. S. W. Sec. Cor. identified,
 5. N. $\frac{1}{4}$ Sec. Cor. identified,
 6. E. $\frac{1}{4}$ Sec. Cor. identified,
 7. S. $\frac{1}{4}$ Sec. Cor. identified,
 8. W. $\frac{1}{4}$ Sec. Cor. identified,

- Subdivision Corners
- No.
1. Center $\frac{1}{4}$ Sec. Cor.
 2. North $\frac{1}{4}$ - $\frac{1}{4}$ s N. W. qr.,
 3. East $\frac{1}{4}$ - $\frac{1}{4}$ s N. W. qr.,
 4. South $\frac{1}{4}$ - $\frac{1}{4}$ s N. W. qr.,
 5. West $\frac{1}{4}$ - $\frac{1}{4}$ s N. W. qr.,
 6. Center $\frac{1}{4}$ - $\frac{1}{4}$ s N. W. qr.,
 7. North $\frac{1}{4}$ - $\frac{1}{4}$ s N. E. qr.,
 8. East $\frac{1}{4}$ - $\frac{1}{4}$ s N. E. qr.,
 9. South $\frac{1}{4}$ - $\frac{1}{4}$ s N. E. qr.,
 10. Center $\frac{1}{4}$ - $\frac{1}{4}$ s N. E. qr.,
 11. East $\frac{1}{4}$ - $\frac{1}{4}$ s S. E. qr.,
 12. South $\frac{1}{4}$ - $\frac{1}{4}$ s S. E. qr.,
 13. West $\frac{1}{4}$ - $\frac{1}{4}$ s S. E. qr.,
 14. Center $\frac{1}{4}$ - $\frac{1}{4}$ s S. E. qr.,
 15. South $\frac{1}{4}$ - $\frac{1}{4}$ s S. W. qr.,
 16. West $\frac{1}{4}$ - $\frac{1}{4}$ s S. W. qr.,
 17. Center $\frac{1}{4}$ - $\frac{1}{4}$ s S. W. qr.,

No 365

WALWORTH VILLAGE

High STREET

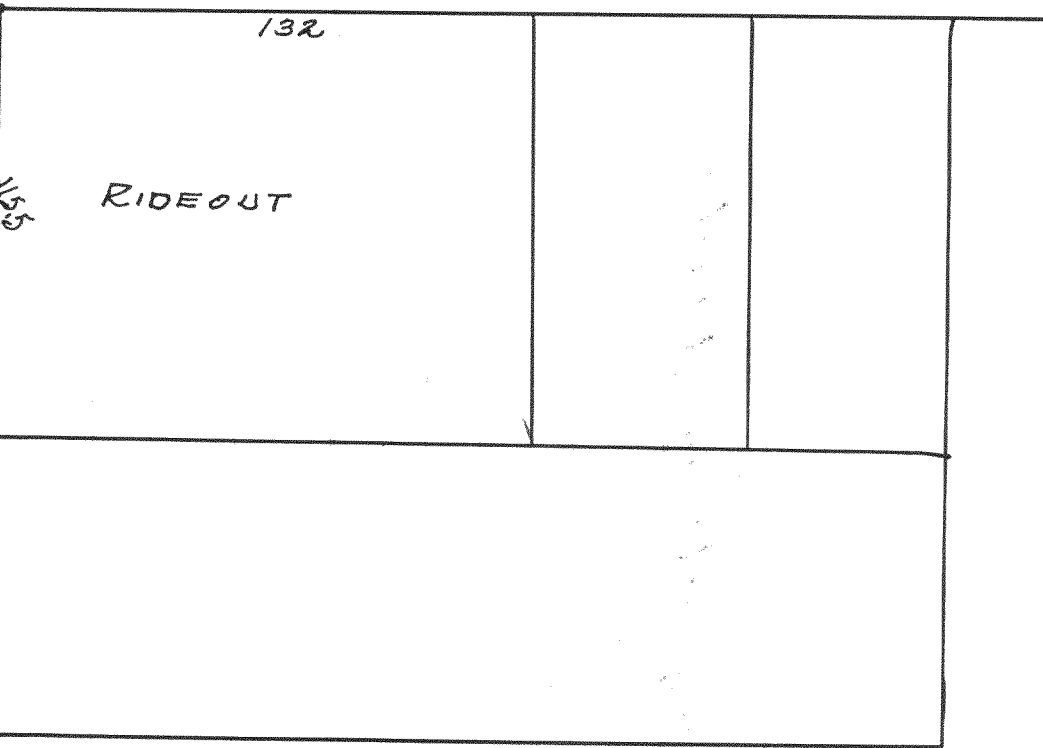

PARK STREET

Plot of survey in the Village of Walworth.
Surveyed by William H. H. H.
Recorded by Lloyd S. Jensen
March 10, 1934

Plat of Section....., Township..... North, Range..... of 4 Principal Meridian Scale
80 chains to 6 inches. The figures in red ink are the lengths of the lines as stated in the field-notes of the Government survey.
Declination of the Magnetic Meridian from the True Meridian.....
Surveyed and sub-divided..... A. D. 1....., in accordance
with the State Laws and Instructions of the Commissioner of the General Land office, and recorded on pages..... of Register in the County Clerk's office.
Witness my hand this..... day of..... A. D. 1.....
..... SURVEYOR.

NAMES OF SWORN ASSISTANTS

FLAGMEN


AXMEN

no 366

NORTH

no 367

11-2-16

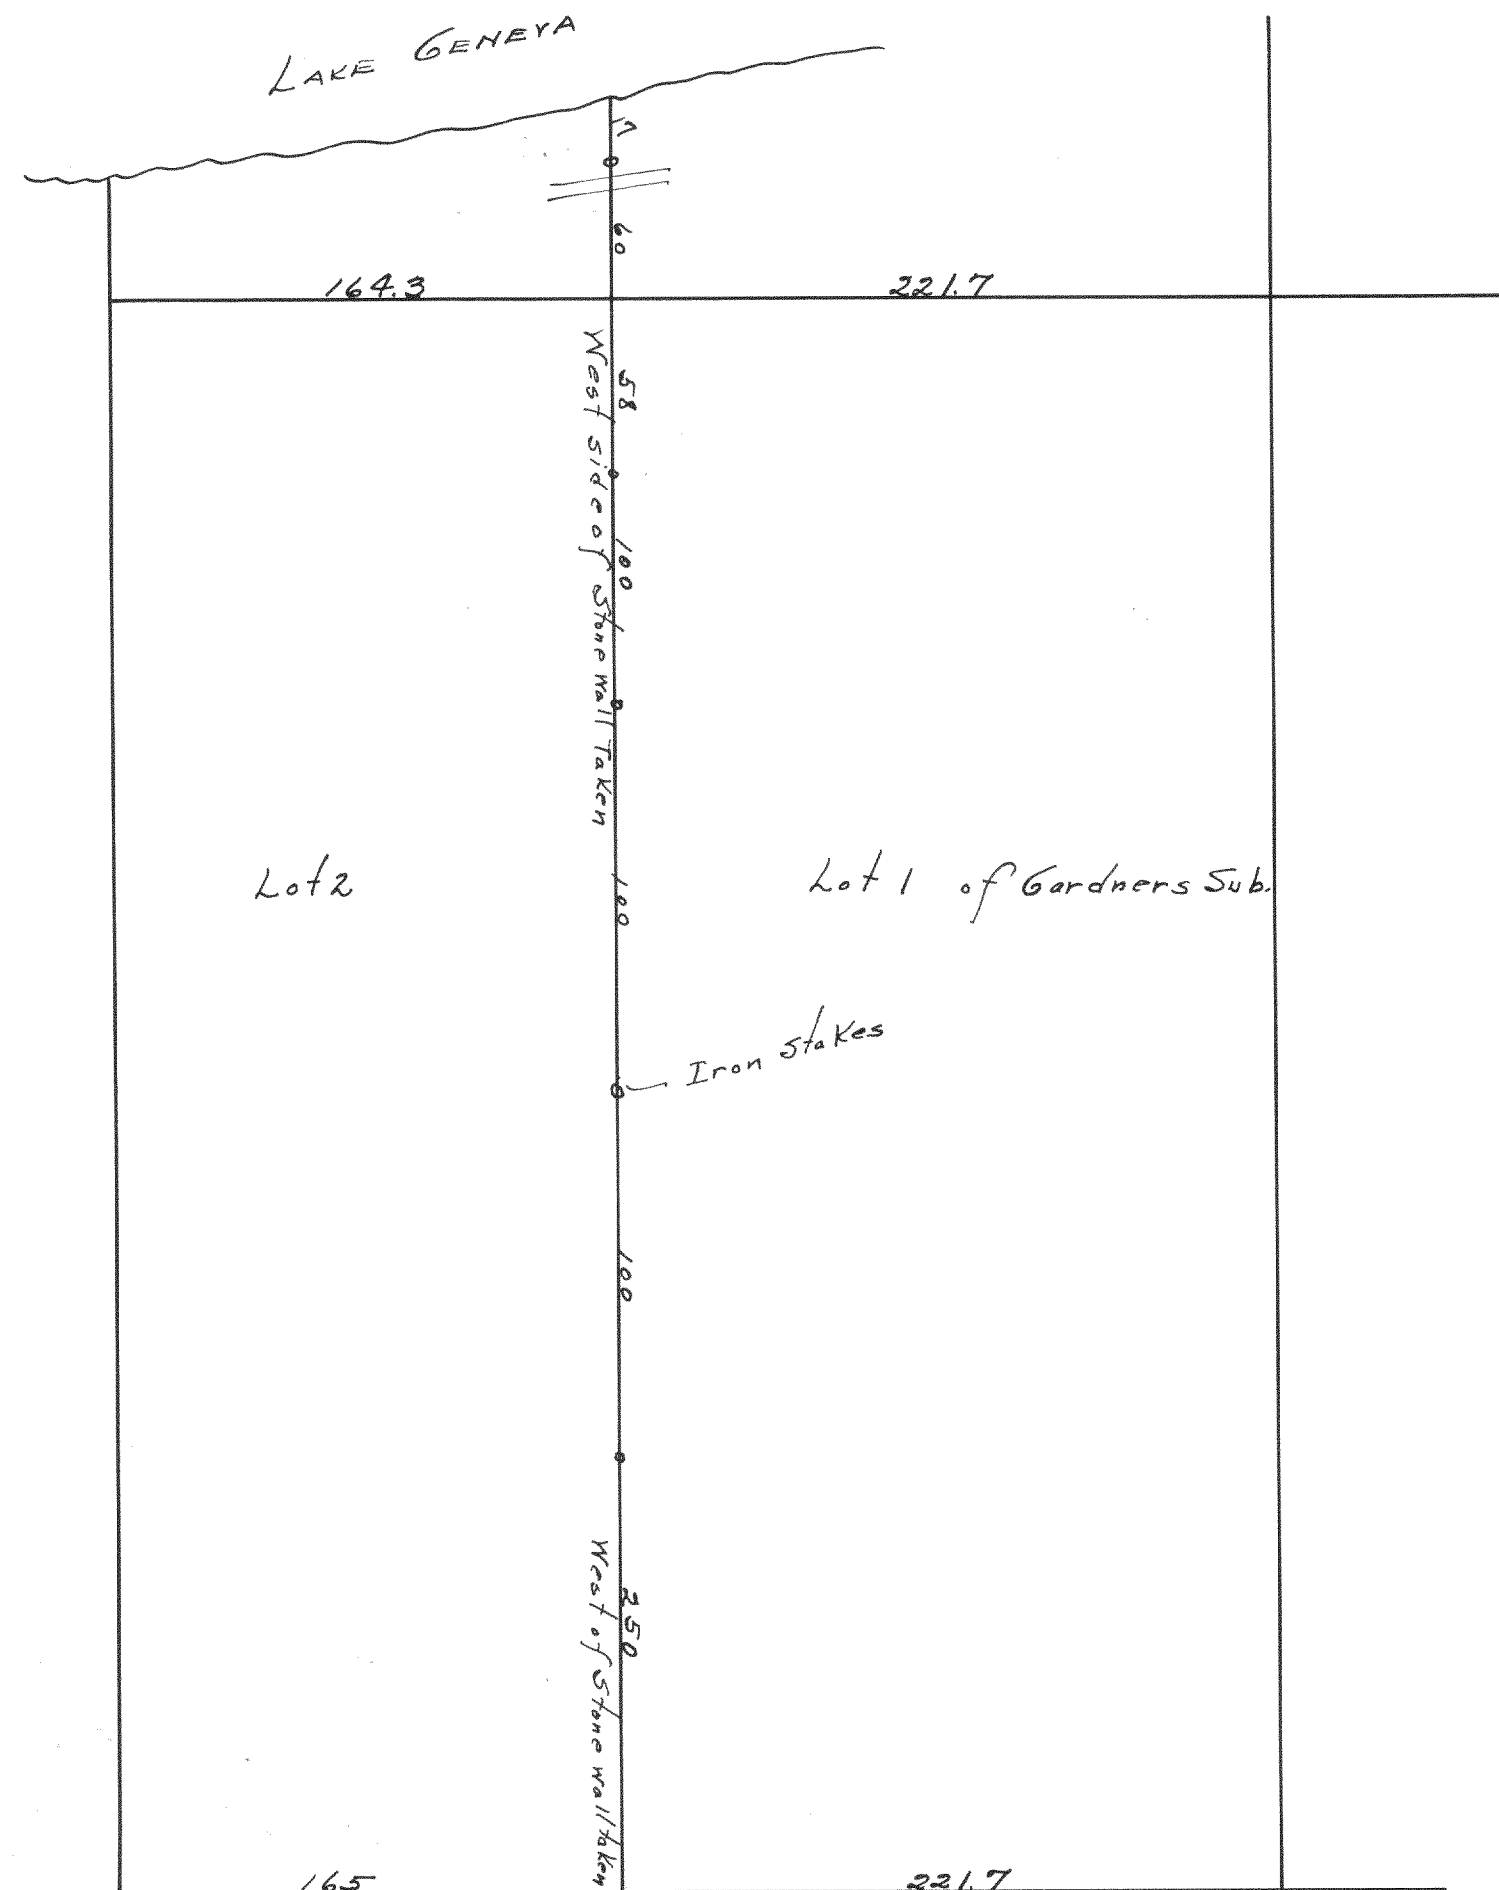

Found stone monument at $\frac{1}{8}$ post on South of Southwest quarter and 9.20 chains = 607.2 feet North being northeast of piece on this line, 200 north of Southeast corner set iron pipe for northeast of piece surveyed. West from $\frac{1}{8}$ post 206 feet find iron stake for corner of lot South and on this line at 150 feet drive stake for Southwest of piece, drive iron pipe 150 feet west and 200 North for northwest corner of piece.

Surveyed by W^m Child
C.S.
Oct 3, 1914

Recorded by Lloyd S. Jensen
C.S.
March 10, 1934

Plat of survey in Gardner's Subd. located in Section 13, T1N, R16E.

Surveyed by W^m Child
C.S.

Recorded by Lloyd S. Jensen
C.S.
March 10, 1934