


# Record of Survey.

4-1-16

no 368

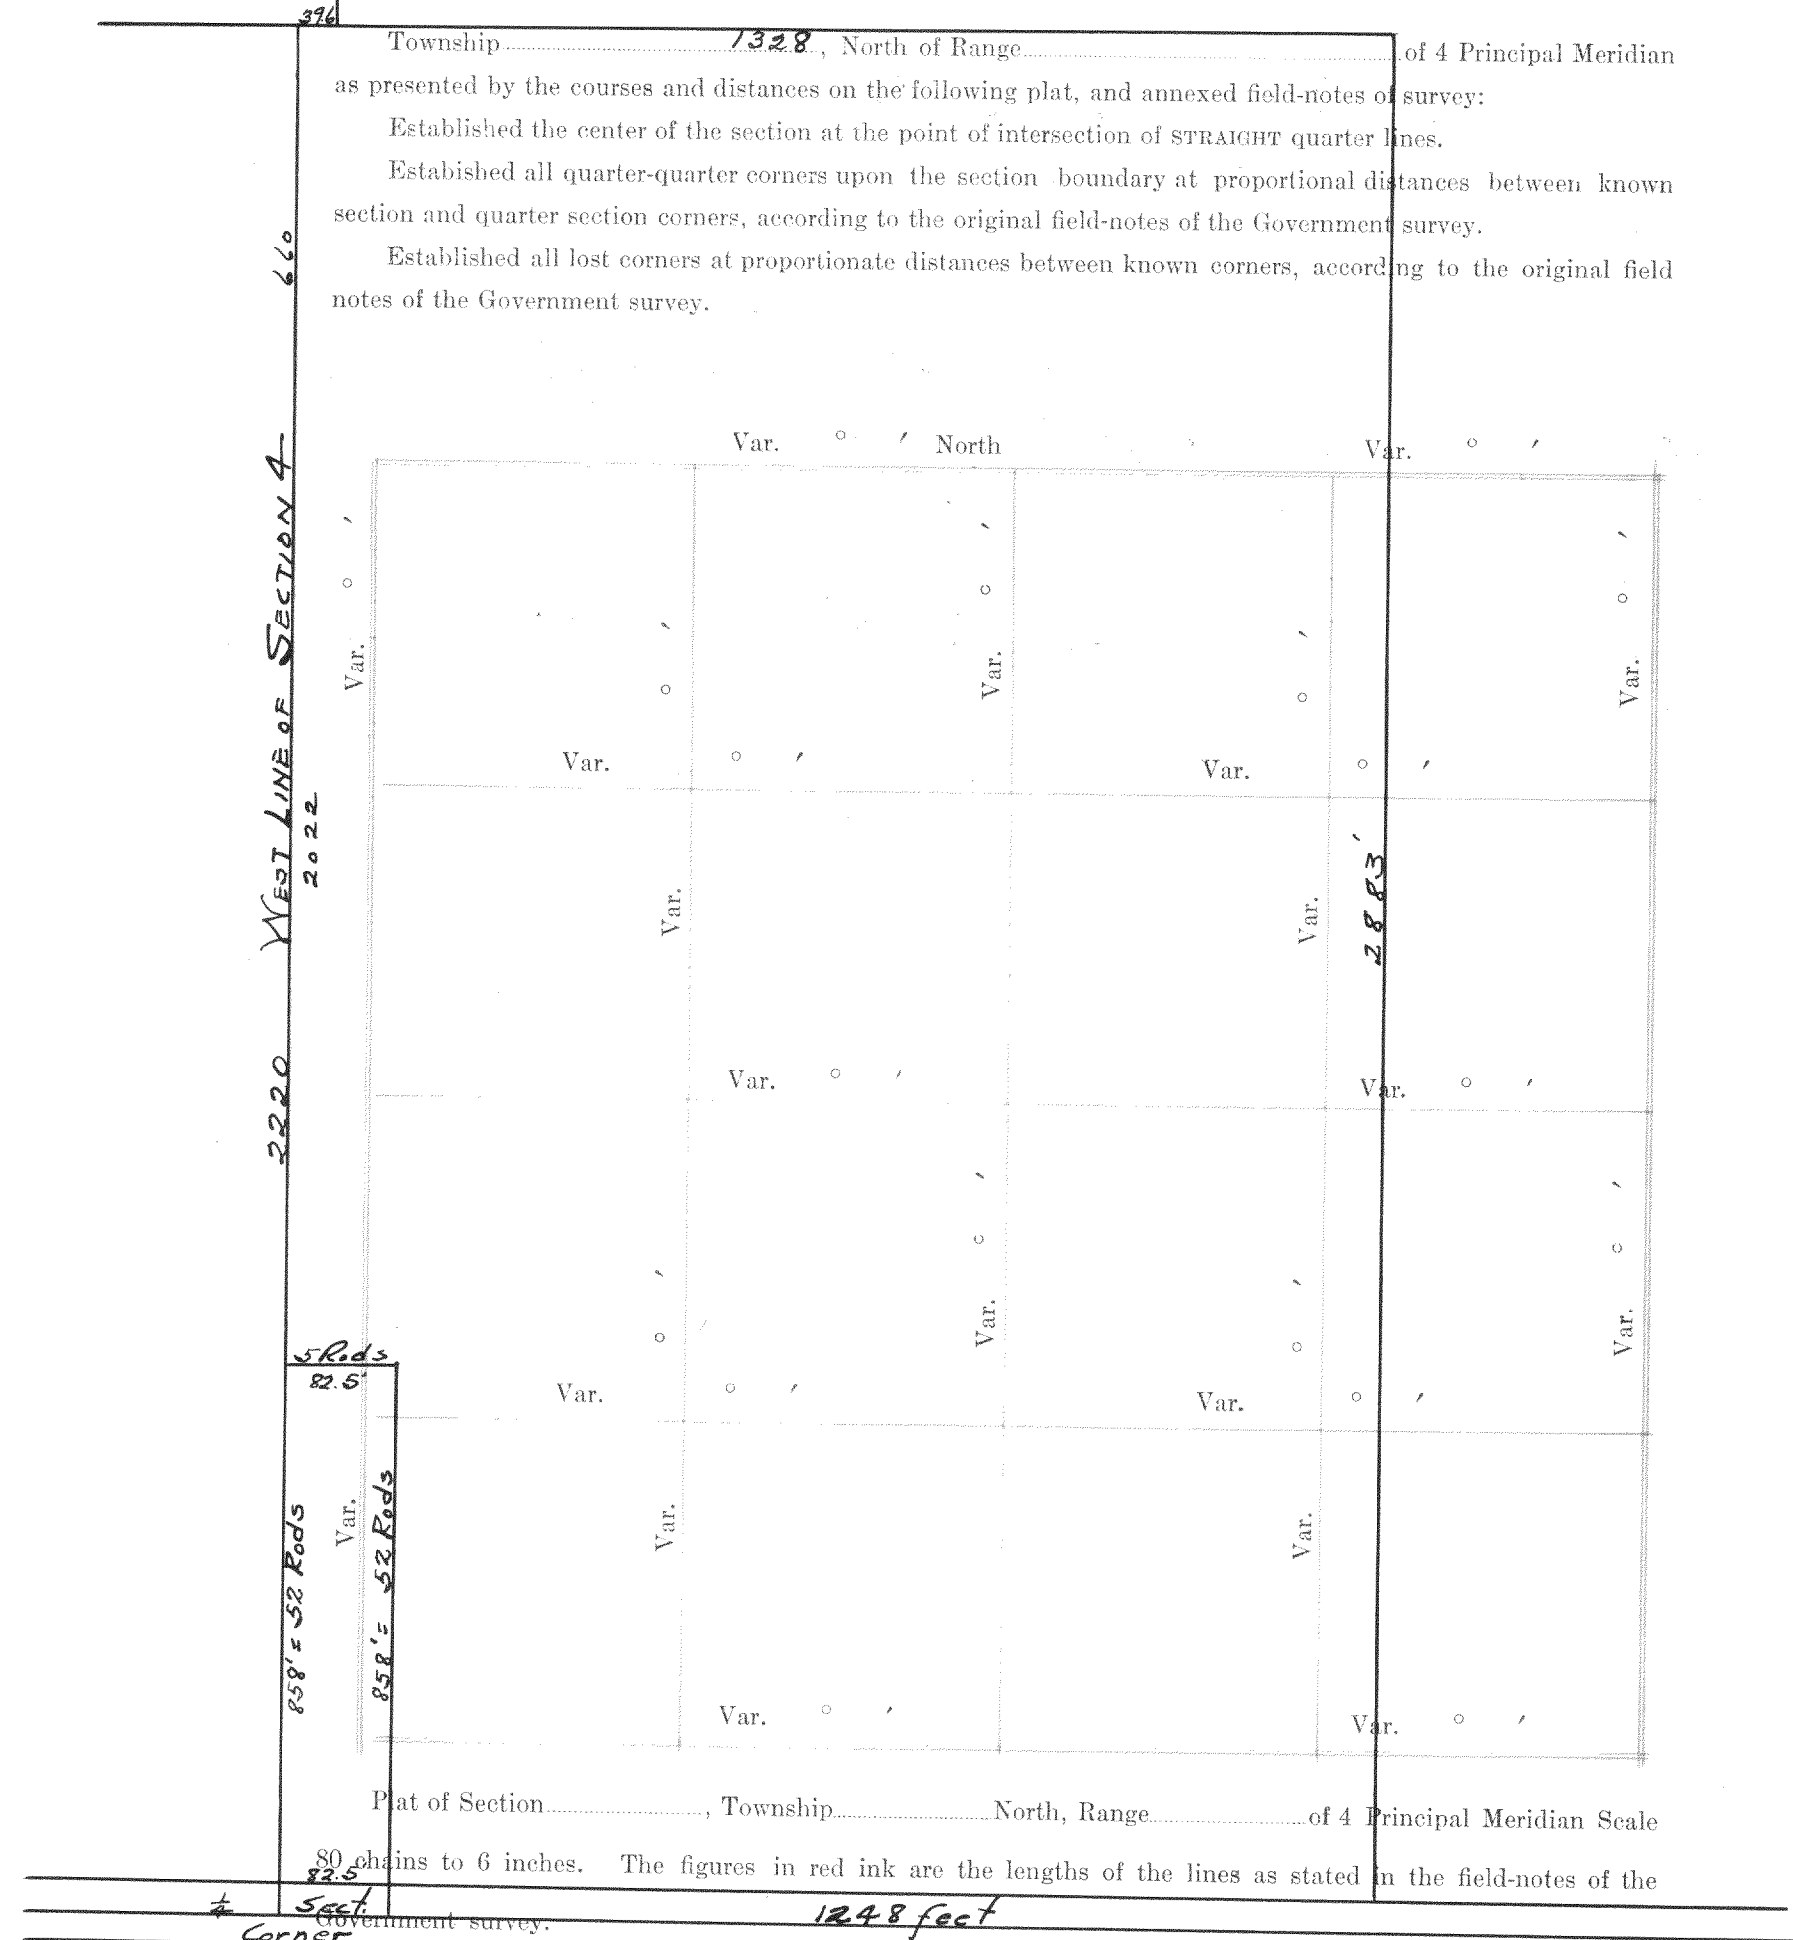

Declination of the Magnetic Meridian from the True Meridian

Surveyed and sub-divided *Survey of Klode farm in Section 4-1-16*

with the State Laws and Instructions of the Commissioner of the General Land office, and recorded on pages

of Register in the County Clerk's office.

Witness my hand this day of

*Surveyed by W. M. Child*  
*Recorded by Lloyd S. Jensen*  
*March 10, 1934*

SURVEYOR.

# DESCRIPTION

121

OF SECTION, QUARTER SECTION AND QUARTER QUARTER SECTION CORNERS

GOVERNMENT CORNERS

1. N. W. Sec. Cor. identified,
2. N. E. Sec. Cor. identified,
3. S. E. Sec. Cor. identified,
4. S. W. Sec. Cor. identified,
5. N. 1/4 Sec. Cor. identified,
6. E. 1/4 Sec. Cor. identified,
7. S. 1/4 Sec. Cor. identified,
8. W. 1/4 Sec. Cor. identified,


Subdivision Corners

1. Center 1/4 Sec. Cor.
2. North 1/4-1/4s N. W. qr.,
3. East 1/4-1/4s N. W. qr.,
4. South 1/4-1/4s N. W. qr.,
5. West 1/4-1/4s N. W. qr.,
6. Center 1/4-1/4s N. W. qr.,
7. North 1/4-1/4s N. E. qr.,
8. East 1/4-1/4s N. E. qr.,
9. South 1/4-1/4s N. E. qr.,
10. Center 1/4-1/4s N. E. qr.,
11. East 1/4-1/4s S. E. qr.,
12. South 1/4-1/4s S. E. qr.,
13. West 1/4-1/4s S. E. qr.,
14. Center 1/4-1/4s S. E. qr.,
15. South 1/4-1/4s S. W. qr.,
16. West 1/4-1/4s S. W. qr.,
17. Center 1/4-1/4s S. W. qr.

no 369

BUENA VISTA

FONTANA

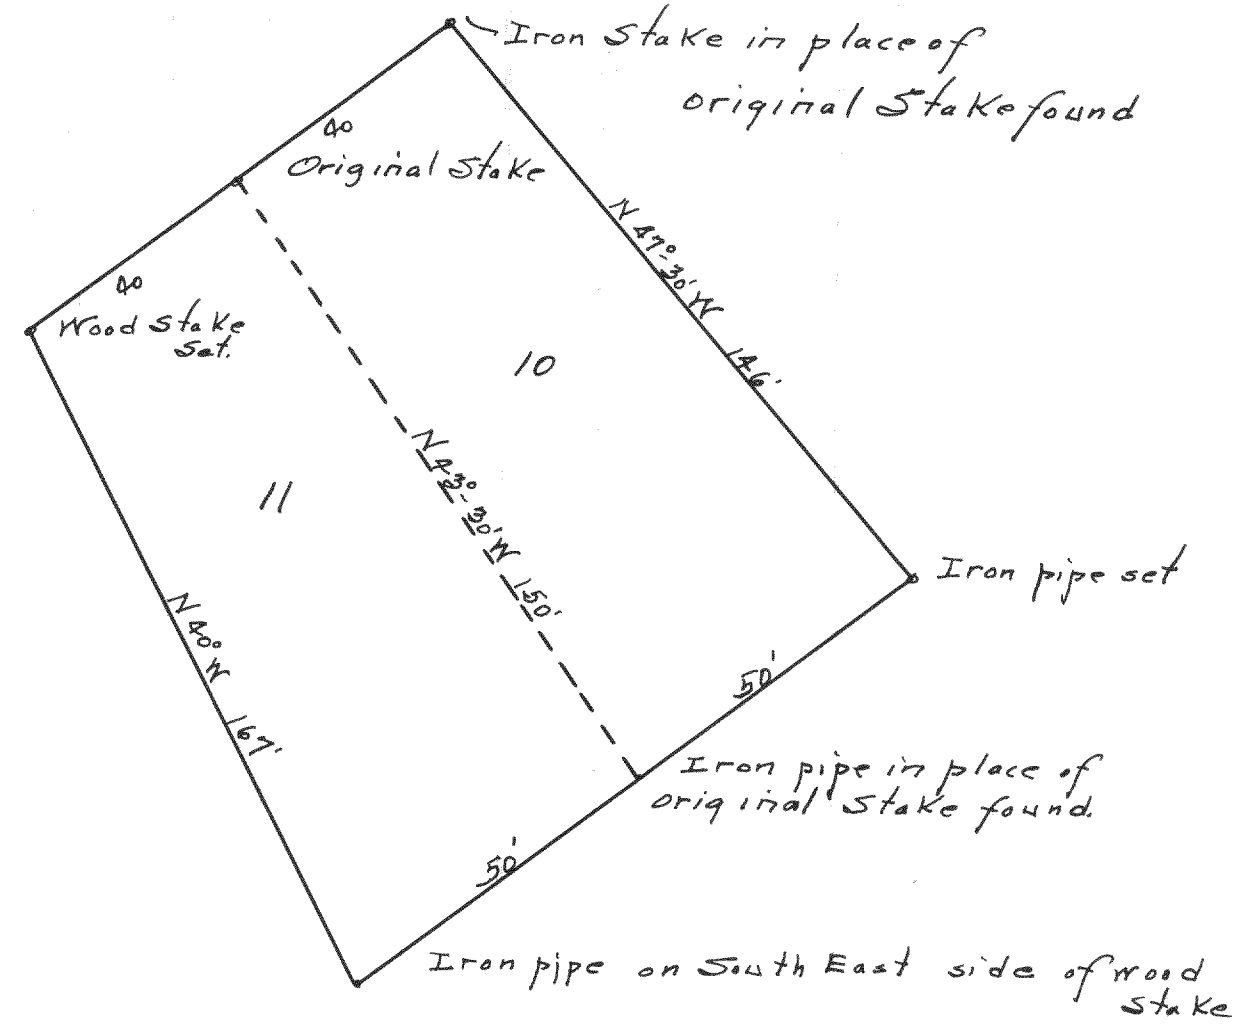

Plot of a survey for C. J. Stubbs of lots 10 & 11 in Buena Vista Subd. in the Village of Fontana, Walworth Co., Wisconsin.

Surveyed by *Lloyd W. Child*

June 1912

Recorded by *Lloyd S. Jensen*

March 10, 1934

NAMES OF SWORN ASSISTANTS

CHAINMEN

FLAGMEN

AXMEN

10 &amp; 11 - 1-16

no 370 -

State of Wisconsin ) ss.  
County of Walworth )

I, William Child, County Surveyor of Walworth County, Wis., do hereby certify that I did on the 28th of Dec., 1911, make a survey for the purpose of locating and establishing that portion of the section line between Sections 10 & 11 in T1N, R16E, between the northwest corner and the west quarter section corner of said section 11, and that I did at that time find an iron stake driven for the NW corner of said section 11 and which stake was proven to be the said NW corner by the government witness tree which is still standing; That at the West  $\frac{1}{4}$  section corner of said section 11 I found an old stake which I had proven correct in a former survey. I further certify that the line of stakes shown me by A.S. Rosing chief engineer, of the Lake Monona and Lake Kalamoon Electric Railway Company, as being the E of said railway right of way are one & one half ( $1\frac{1}{2}$ ) rods east of the west line of said section 11.

I further certify that I find the paper relating to a highway known as the Elkhorn Bigfoot Highway, on file in the office of the County Clerk for Walworth County and a record thereof in the records of roads in said office on page 29 of said record; That the report of the viewers of said road was accepted, and ordered recorded Jan. 8, 1840, and the said road extends in a southerly and southwesterly direction until it reaches the northwest corner of said section 11 and thence South 40 chains to the  $\frac{1}{4}$  section corner, thence south etc.

Wm Child  
Dec. 10, 1911

Recorded by Lloyd S. Jensen

no 371

15-1-16 FONTANA  
Carl Street

Beginning 9.50 chains north of  $\frac{1}{4}$  corner on East of 15-1-16, north  $82^{\circ} 30' W$  167.5 to center of Street and stake north in center of Street 340 feet to stake found ~~found~~ for corner of lots. East at 166.5 set for Southeast corner of lots 88 from stake found 5368 to beginning

Surveyed by Wm Child  
CS.

Recorded by Lloyd S. Jensen  
March 10, 1934