


Record of Survey.

DESCRIPTION

OF SECTION, QUARTER SECTION AND QUARTER QUARTER SECTION CORNERS

Township....., North of Range.....of 4 Principal Meridian
as presented by the courses and distances on the following plat, and annexed field-notes of survey:
Established the center of the section at the point of intersection of STRAIGHT quarter lines.
Established all quarter-quarter corners upon the section boundary at proportional distances between known section and quarter section corners, according to the original field-notes of the Government survey.
Established all lost corners at proportionate distances between known corners, according to the original field notes of the Government survey.

no. 30

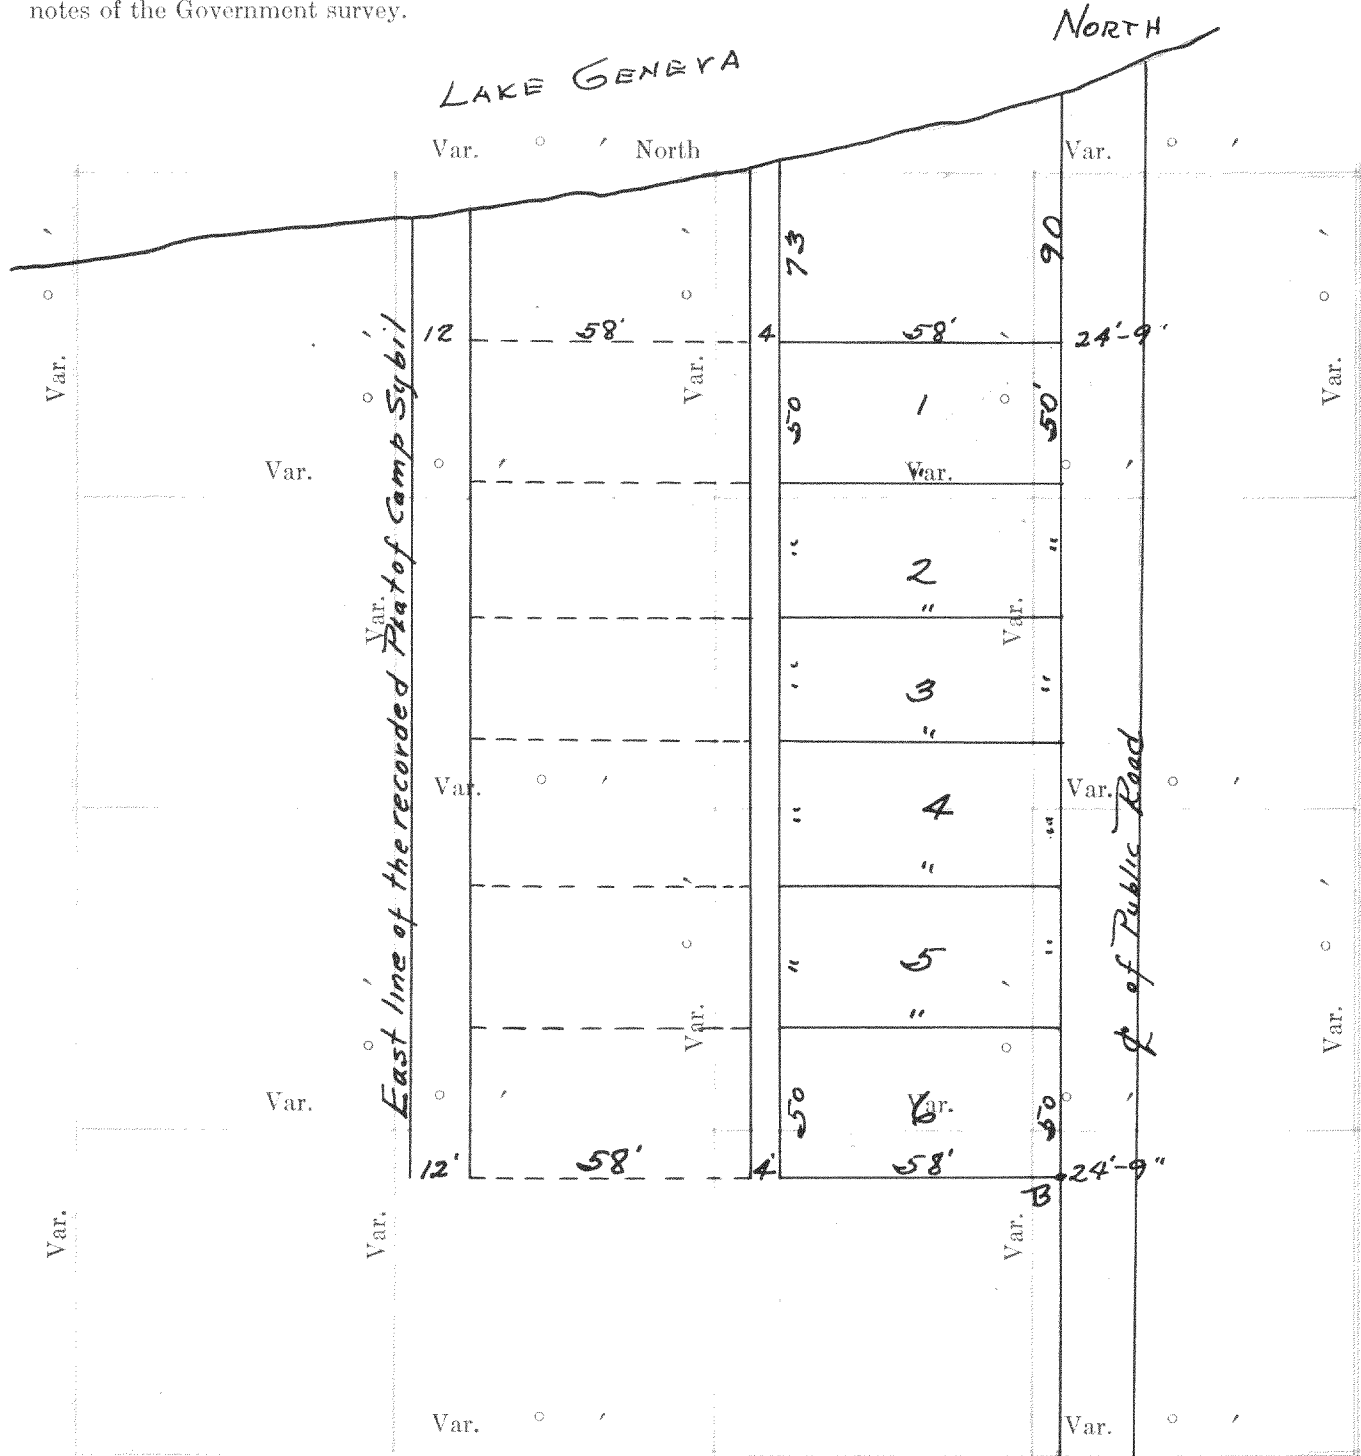

Plat of Section....., Township.....North, Range.....of 4 Principal Meridian Scale
80 chains to 6 inches. The figures in red ink are the lengths of the lines as stated in the field-notes of the
Government survey.
Declination of the Magnetic Meridian from the True Meridian.....
Surveyed and sub-divided.....A. D. I....., in accordance
with the State Laws and Instructions of the Commissioner of the General Land office, and recorded on pages
.....of Register in the County Clerk's office.

To Walworth
and Fontana

Witness my hand

South line of Government Lot 2 A. D. 1 A

To Genera
and Zenda

SURVEYOR.

H. C. MILLER CO., MFG. STATIONERS, MILWAUKEE WISCONSIN															
GOVERNMENT CORNERS															
No.	Bearing	In.	Courses	Links	Bearing	In.	Courses	Links	Bearing	In.	Courses	Links	Bearing	In.	Courses
1.	N. W. Sec. Cor.	identif.													
2.	N. E. Sec. Cor.	identif.													
3.	S. E. Sec. Cor.	identif.													
4.	S. W. Sec. Cor.	identif.													
5.	N. 1/4 Sec. Cor.	identif.													
6.	E. 1/4 Sec. Cor.	identif.													
7.	S. 1/4 Sec. Cor.	identif.													
8.	W. 1/4 Sec. Cor.	identif.													
Subdivision Corners															
1.	Center 1/4 Sec. Cor.														
2.	North 1/4-1/4s N. W. qr.														
3.	East 1/4-1/4s N. W. qr.														
4.	South 1/4-1/4s N. W. qr.														
5.	West 1/4-1/4s N. W. qr.														
6.	Center 1/4-1/4s N. W. qr.														
7.	North 1/4-1/4s N. E. qr.														
8.	East 1/4-1/4s N. E. qr.														
9.	South 1/4-1/4s N. E. qr.														
10.	Center 1/4-1/4s N. E. qr.														
11.	East 1/4-1/4s S. E. qr.														
12.	South 1/4-1/4s S. E. qr.														
13.	West 1/4-1/4s S. E. qr.														
14.	Center 1/4-1/4s S. E. qr.														
15.	South 1/4-1/4s S. W. qr.														
16.	West 1/4-1/4s S. W. qr.														
17.	Center 1/4-1/4s S. W. qr.														

Plat of a survey made for Jerome Ingalls in Piece
no. 4 of Government lot no. 2 in the West half
of the North East Quarter of section no. 18. Township
no. 1 North Range no. 17 East lying the town of Linn.
Walworth County, Wisconsin.

A. is a point 383.8 feet west of the South East
corner of Government Lot no. 2 and B is a stake
1233 feet north of A.

Elkhorn July 20th 1924

Wm Child

County Surveyor

Recorded Feb. 23, 1933 by
Lloyd S. Jensen
County Surveyor

NAMES OF SWORN ASSISTANTS

CHAINMEN

FLAGMEN

AXMEN

No 31 Plat of a survey made by the direction of Ralph T. Leach for the purpose of ascertaining the number of square yards of surface in one certain marsh or slough located in the West half of section No 17, Town 4 North, Range 18 East being the Town of East Troy, Walworth County, Wisconsin. And lying in front of lots 25 to 64 inclusive of the Plat of Wilmer Grove Beach which plat is on record in the Register of Deeds office in and for the said County in Volume 8 of Plats on Page 92. In figuring yards a strip .7. feet in width along the entire front of the said lots being 1604 feet in length is to be taken out as hard land. The lines on Plat marked "A" are lines that were measured. Scale of Plat 50' = 1" (original not this drawing)