


Record of Survey.

DESCRIPTION

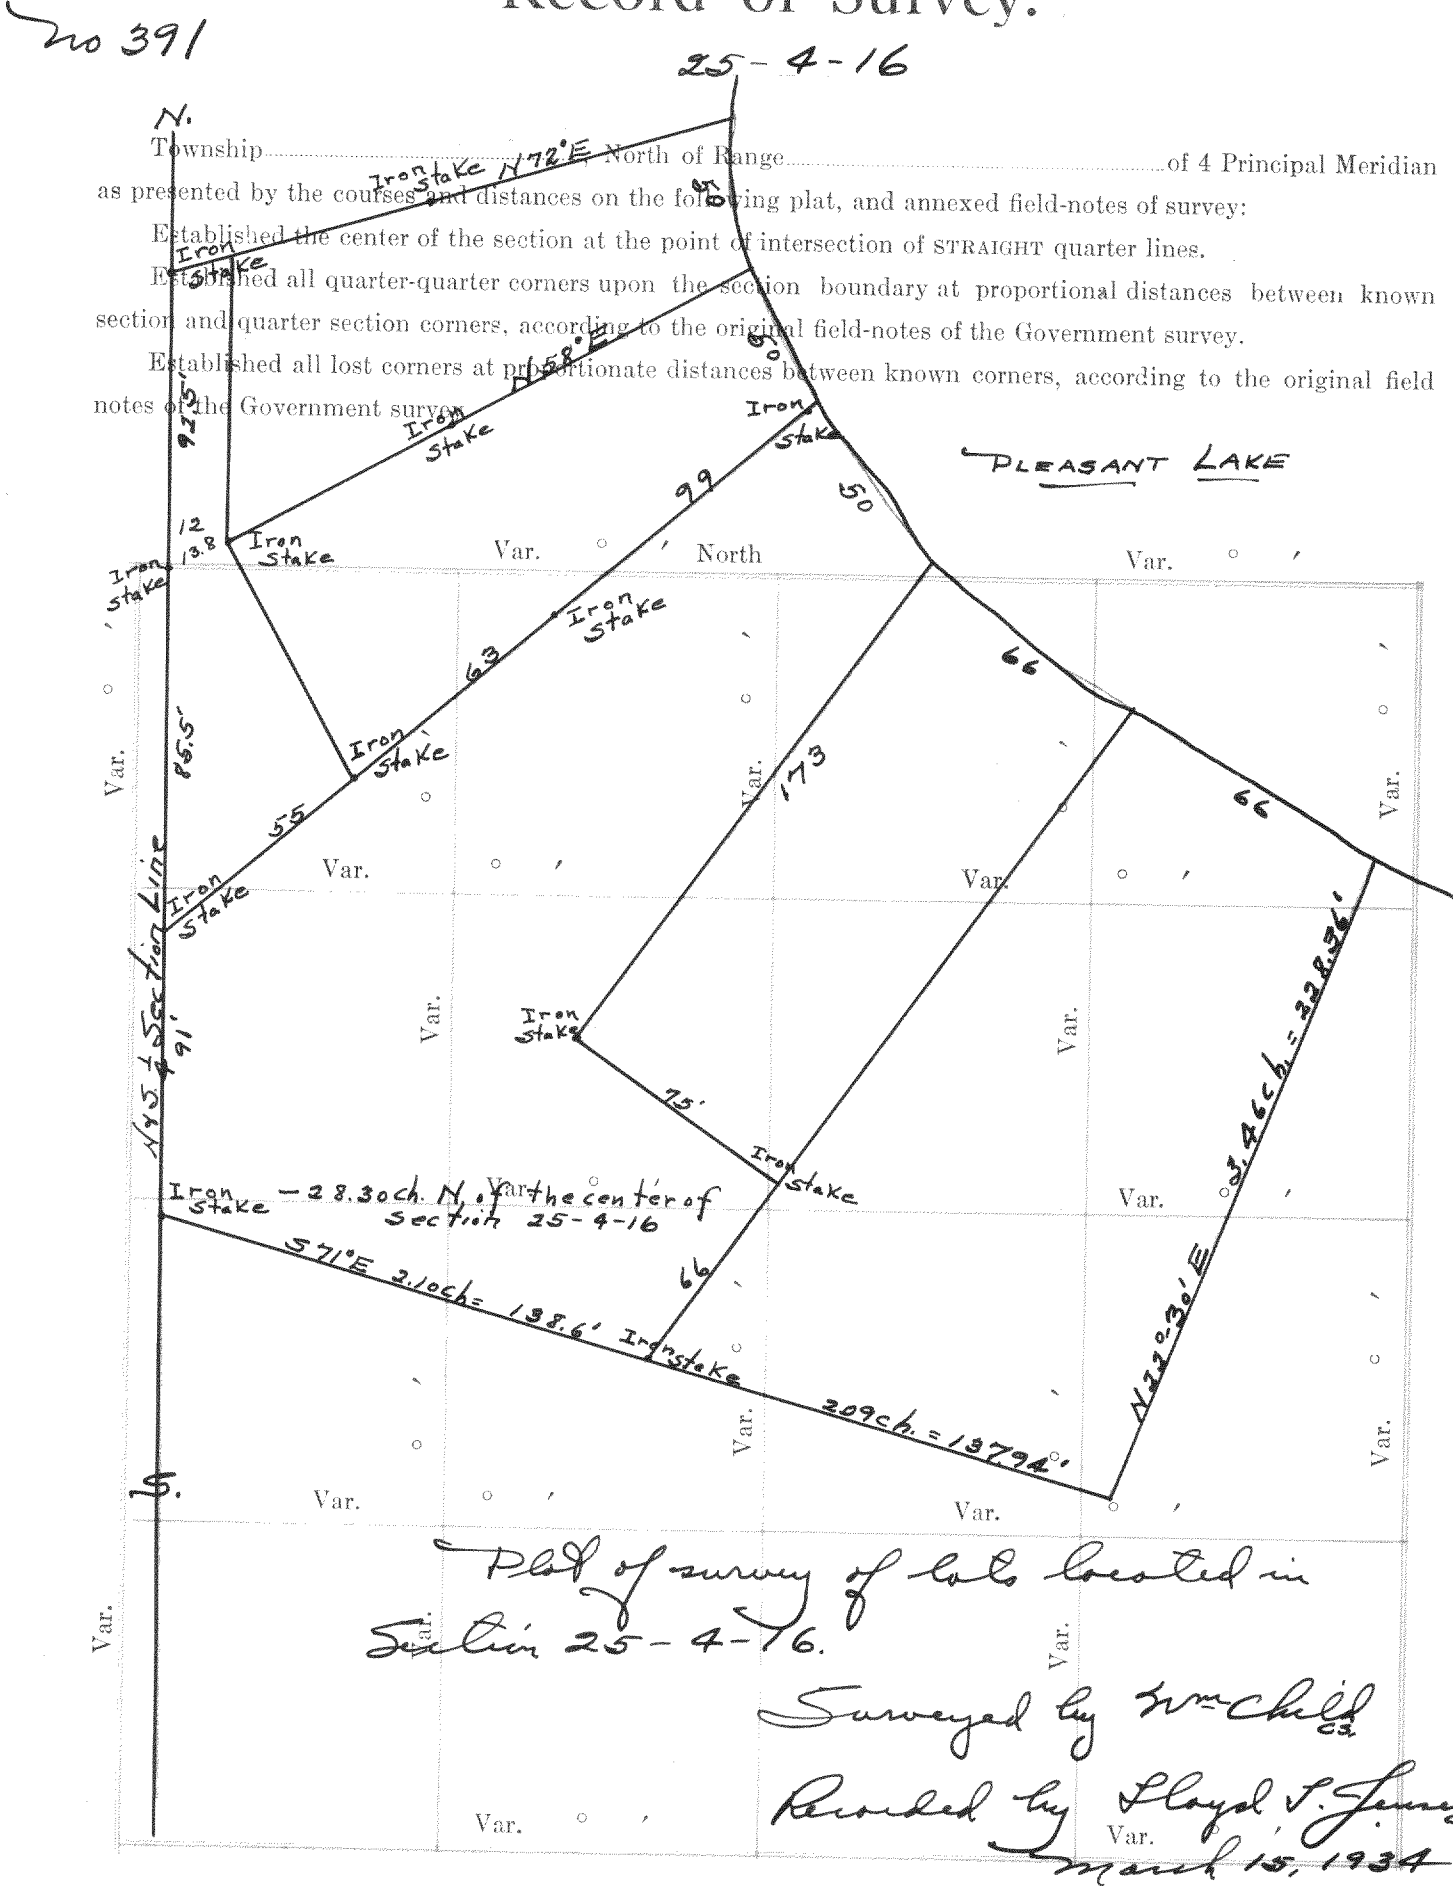

OF SECTION, QUARTER SECTION AND QUARTER QUARTER SECTION CORNERS

GOVERNMENT CORNERS				H. C. MILLER CO. MFG. STATIONERS, MILWAUKEE WISCONSIN				
No.	Bearing Trees	In. Dia.	Courses they bear	Links Distant	Bearing Trees	In. Dia.	Courses they bear	Links Distant
1.	N. W. Sec. Cor. identified,							
2.	N. E. Sec. Cor. identified,							
3.	S. E. Sec. Cor. identified,							
4.	S. W. Sec. Cor. identified,							
5.	N. 1/4 Sec. Cor. identified,							
6.	E. 1/4 Sec. Cor. identified,							
7.	S. 1/4 Sec. Cor. identified,							
8.	W. 1/4 Sec. Cor. identified,							
Subdivision Corners								
No.	Bearing	In. Dia.	Courses they bear	Links Distant	Bearing	In. Dia.	Courses they bear	Links Distant
1.	Center 1/4 Sec. Cor.							
2.	North 1/4-1/4s N. W. qr.,							
3.	East 1/4-1/4s N. W. qr.,							
4.	South 1/4-1/4s N. W. qr.,							
5.	West 1/4-1/4s N. W. qr.,							
6.	Center 1/4-1/4s N. W. qr.,							
7.	North 1/4-1/4s N. E. qr.,							
8.	East 1/4-1/4s N. E. qr.,							
9.	South 1/4-1/4s N. E. qr.,							
10.	Center 1/4-1/4s N. E. qr.,							
11.	East 1/4-1/4s S. E. qr.,							
12.	South 1/4-1/4s S. E. qr.,							
13.	West 1/4-1/4s S. E. qr.,							
14.	Center 1/4-1/4s S. E. qr.,							
15.	South 1/4-1/4s S. W. qr.,							
16.	West 1/4-1/4s S. W. qr.,							
17.	Center 1/4-1/4s S. W. qr.,							

No. 392

Description of lands surveyed for Fred W. ...

Beginning at an iron stake and which iron stake is the northeast corner of lot number fourteen (14), in a plat of land known as Pleasant Point. Located in section number 36, in the Town of La Grange, Walworth County, Wisconsin, and a plat of said land, being on record in the Register of Deeds Office in and for said Walworth County, in Volume 5 of plots on page 67. Thence S 32°-30' E, 66.8 feet to an iron stake (being 6/10 of a foot northeast of one certain white oak tree known to both parties of this instrument) and producing said line of S 32°-30' E, 11 feet more (more or less) to the shore of Landerdale Lake at low water line; thence starting in a southwesterly direction and following along the shore of said lake at low water line 130 feet (more or less) to the southeast corner of said lot fourteen (14). Thence N 42°-15' E along the side of said lot 117 feet (more or less) to the place of beginning.

Surveyed by Wm Child

Recorded to Lloyd S. L.

no 392

Description of lands surveyed for Fred Wolf

Beginning at an iron stake and which iron stake is the northeast corner of lot number fourteen (14), in a plat of land known as Pleasant Point. Located in section number 36, in the town of La Grange, Walworth County, Wisconsin, and a plat of said land, being on record in the Register of Deeds Office in and for said Walworth County, in Volume 5 of plats on page 67. Thence S 32°-30' E, 66.8 feet to an iron stake (being 1/10 of a foot northeast of one certain white oak tree known to both parties of this instrument) and producing said line of S 32°-30' E, 11 feet more (more or less) to the shore of Landerdale Lake at low water line; Thence starting in a southwesterly direction and following along the shore of said lake at low water line 130 feet (more or less) to the southeast corner of said lot fourteen (14). Thence N 42°-15' E along the side of said lot 117 feet (more or less) to the place of beginning.

Surveyed by Wm Child

Recorded by Lloyd S. Jensen

March 15, 1934

NAMES OF SWORN ASSISTANTS

CHAINMEN	FLAGMEN	AXMEN
----------	---------	-------

Plat of Section....., Township.....North, Range.....of 4 Principal Meridian Scale 80 chains to 6 inches. The figures in red ink are the lengths of the lines as stated in the field-notes of the Government survey.

Declination of the Magnetic Meridian from the True Meridian.....

Surveyed and sub-divided.....A. D. 1....., in accordance with the State Laws and Instructions of the Commissioner of the General Land office, and recorded on pages.....of Register in the County Clerk's office.

Witness my hand this.....day of.....A. D. 1.....

.....SURVEYOR.

