


Record of Survey.

DESCRIPTION

OF SECTION, QUARTER SECTION AND QUARTER QUARTER SECTION CORNERS

no 415

Township _____, North of Range _____ of 4 Principal Meridian
as presented by the courses and distances on the following plat, and annexed field-notes of survey:
Established the center of the section at the point of intersection of STRAIGHT quarter lines
Established all quarter-quarter corners upon the section boundary at proportional distances between known section and quarter section corners, according to the original field-notes of the Government survey.
Established all lost corners at proportionate distances between known corners, according to the original field notes of the Government survey.

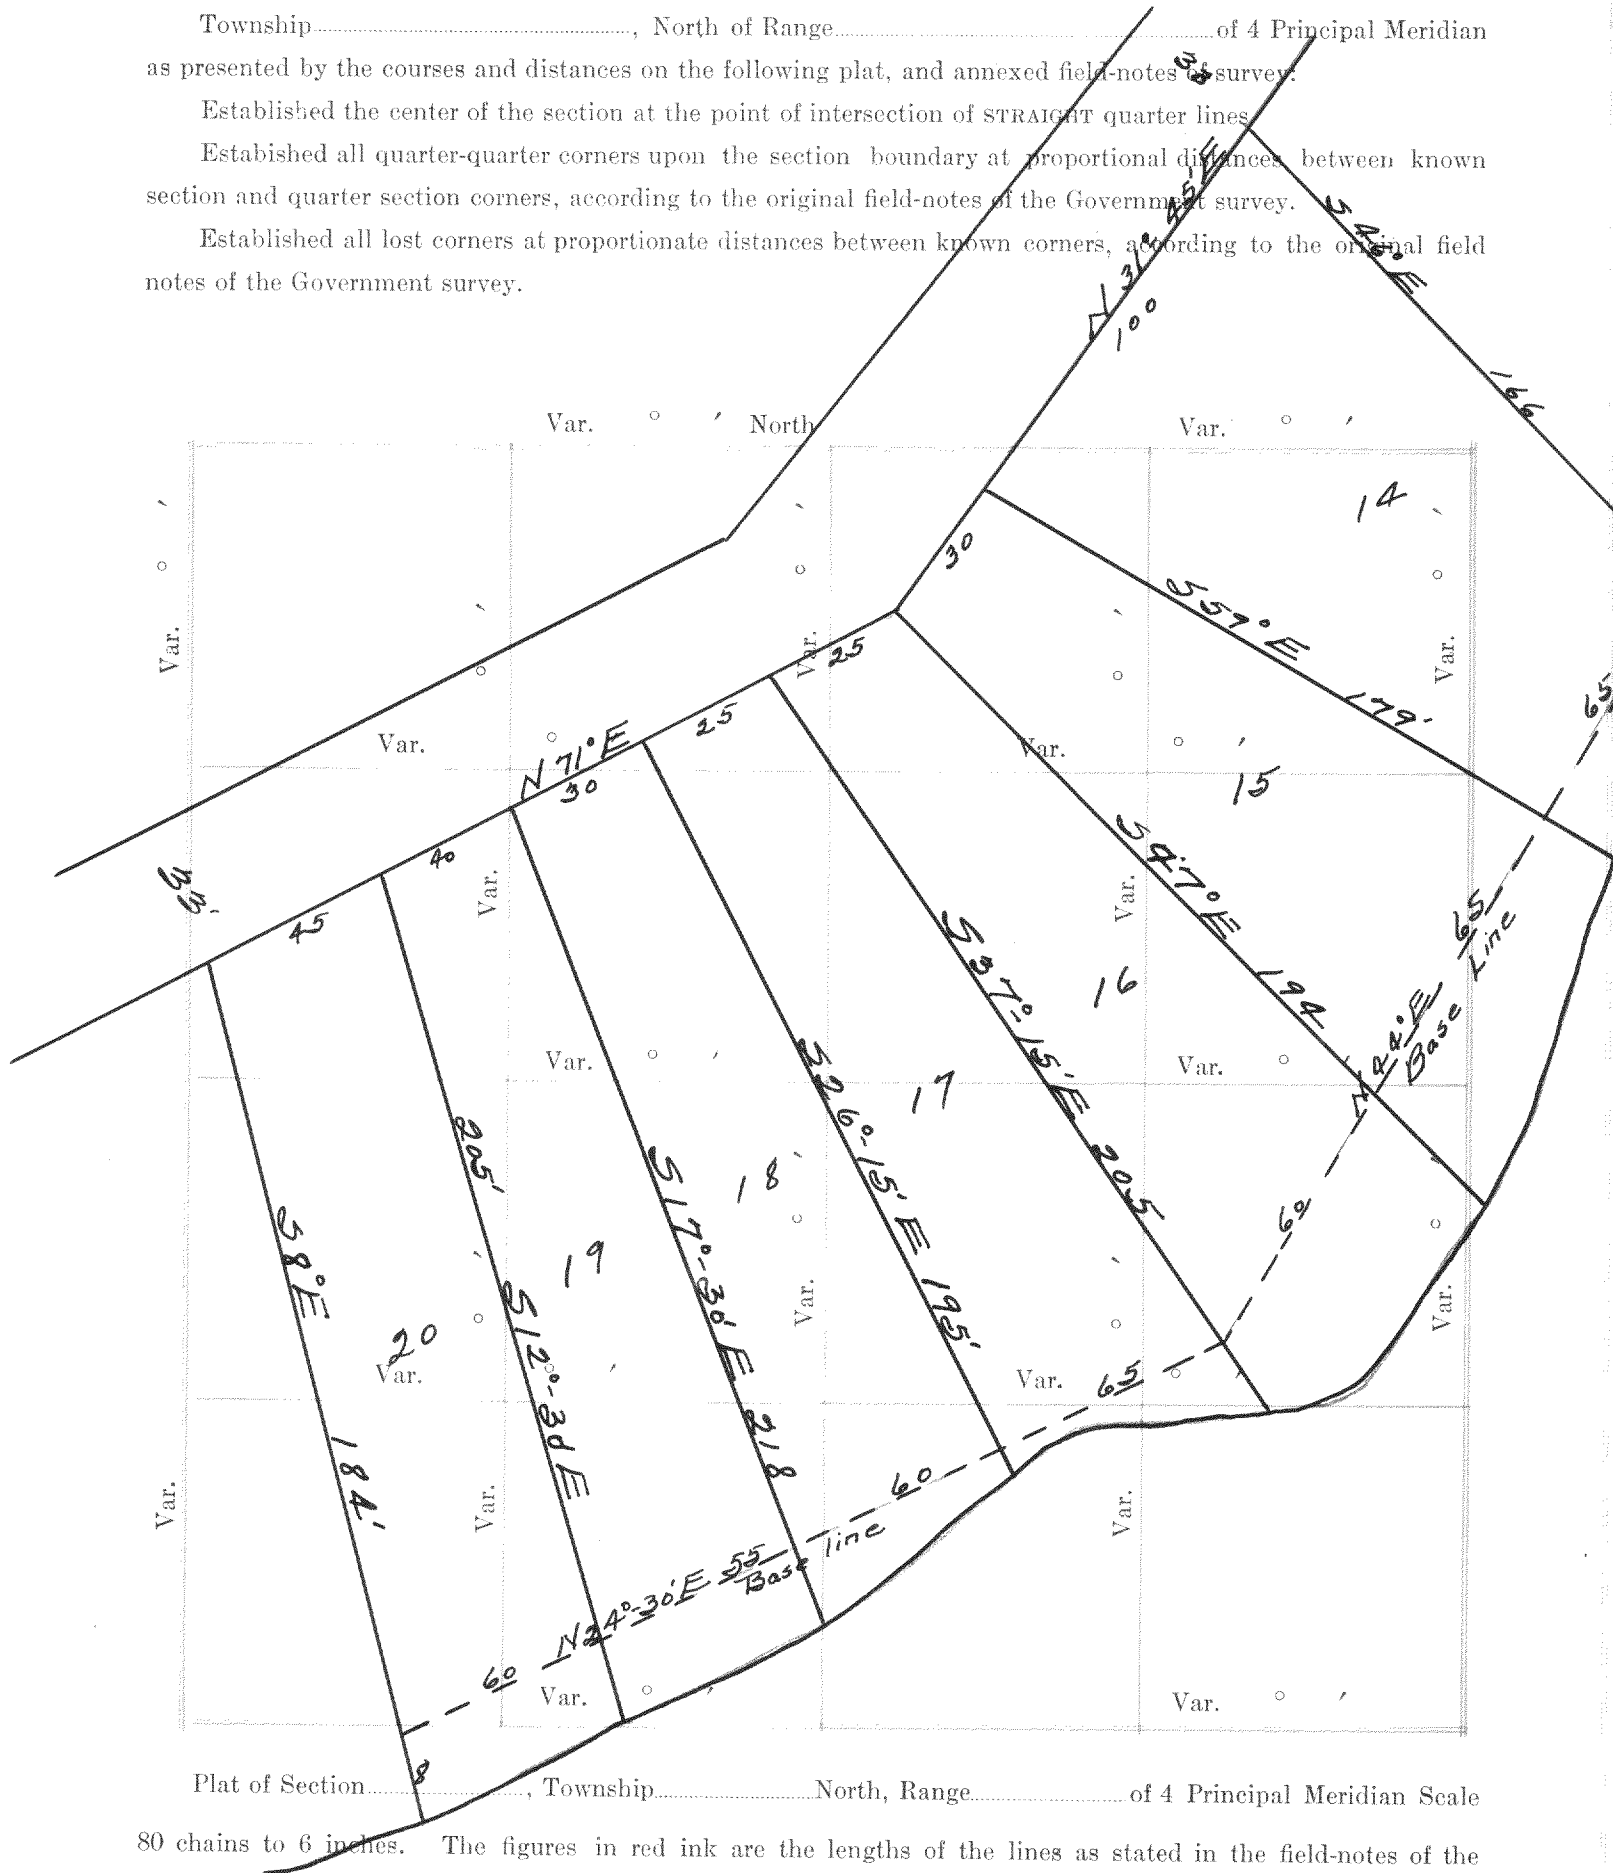

Plat of Section _____, Township _____ North, Range _____ of 4 Principal Meridian Scale
80 chains to 6 inches. The figures in red ink are the lengths of the lines as stated in the field-notes of the Government survey.

Declination of the Magnetic Meridian from the True Meridian _____
Surveyed and sub-divided _____ A. D. 1 _____, in accordance
with the State Laws and Instructions of the Commissioner of the General Land office, and recorded on pages
_____ of Register in the County Clerk's office.

Witness my hand this _____ day of _____ A. D. 1 _____

SURVEYOR.

GOVERNMENT CORNERS				H. C. MILLER CO., MFG. STATIONERS, MILWAUKEE WISCONSIN								
No.	Bearing	In.	Courses	Links	Bearing	In.	Courses	Links	Bearing	In.	Courses	Links
1.	N. W. Sec. Cor. identified,											
2.	N. E. Sec. Cor. identified,											
3.	S. E. Sec. Cor. identified,											
4.	S. W. Sec. Cor. identified,											
5.	N. 1/4 Sec. Cor. identified,											
6.	E. 1/4 Sec. Cor. identified,											
7.	S. 1/4 Sec. Cor. identified,											
8.	W. 1/4 Sec. Cor. identified,											
Subdivision Corners												
1.	Center 1/4 Sec. Cor.											
2.	North 1/4-1/4s N. W. qr.,											
3.	East 1/4-1/4s N. W. qr.,											
4.	South 1/4-1/4s N. W. qr.,											
5.	West 1/4-1/4s N. W. qr.,											
6.	Center 1/4-1/4s N. W. qr.,											
7.	North 1/4-1/4s N. E. qr.,											
8.	East 1/4-1/4s N. E. qr.,											
9.	South 1/4-1/4s N. E. qr.,											
10.	Center 1/4-1/4s N. E. qr.,											
11.	East 1/4-1/4s S. E. qr.,											
12.	South 1/4-1/4s S. E. qr.,											
13.	West 1/4-1/4s S. E. qr.,											
14.	Center 1/4-1/4s S. E. qr.,											
15.	South 1/4-1/4s S. W. qr.,											
16.	West 1/4-1/4s S. W. qr.,											
17.	Center 1/4-1/4s S. W. qr.,											

Plat of a survey made for A. G. Arras of Mil. to locate the boundary lines of certain pieces of land contracted by said Arras to be conveyed to parties, said lots being parts of lots of the recorded plat of Oak Park, 30 which plat is on rec. in the Register of Deeds office in and for Walworth County, Wisconsin, in Vol. 6 of plats on page 18, and said land being in the S.E. q. of Section 26, T. R. 16 E., being the Town of La Grange, said tr. and state.

The lines & figures in black are correct copies of the recorded plat. The lines & figures in red pertain to the lots purchased. The dashed black line is the base line on which the original lot stakes were set. The dashed red line is the line on which stakes were set for the purchase. The figures in red between the dashed black line show the distance the purchased lot line is from the true line. Stakes are on the base line on sides of the original lots and also of those purchased.

Ekham July 3, 1920
G. M. Child

Note: Red Lines do not show up on blue print,

Recorded by Lloyd S. Jensen

Plat of a survey made for A. G. Arras of Mil. to locate the boundary lines of certain pieces of land contracted by said Arras to be conveyed to parties, said lots being parts of lots of the recorded plat of Oak Park, 70 which plat is on record in the Register of Deeds office in and for Walworth County, Wisconsin, in Vol. 6 of plats on page 18, and said land being in the S.E. qr. of section 26, T4N. R. 16E, being the Town of La Grange, said to and state.

The lines & figures in black are correct copies of the recorded plat. The lines & figures in red pertain to the lots purchased. The dashed black line is the base line on which the original lot stakes were set. The dashed red line is the line on which stakes were set for the purchase. The figures in red below the dashed black line show the distance the purchase lot line is from the true line. Stakes are on the base line on sides of the original lots and also of those purchased.


Attest July 3, 1920
G. M. Child

Recorded by Lloyd L. Jensen
March 19, 1934

NAMES OF SWORN ASSISTANTS

CHAINMEN FLAGMEN AXMEN

no. 416

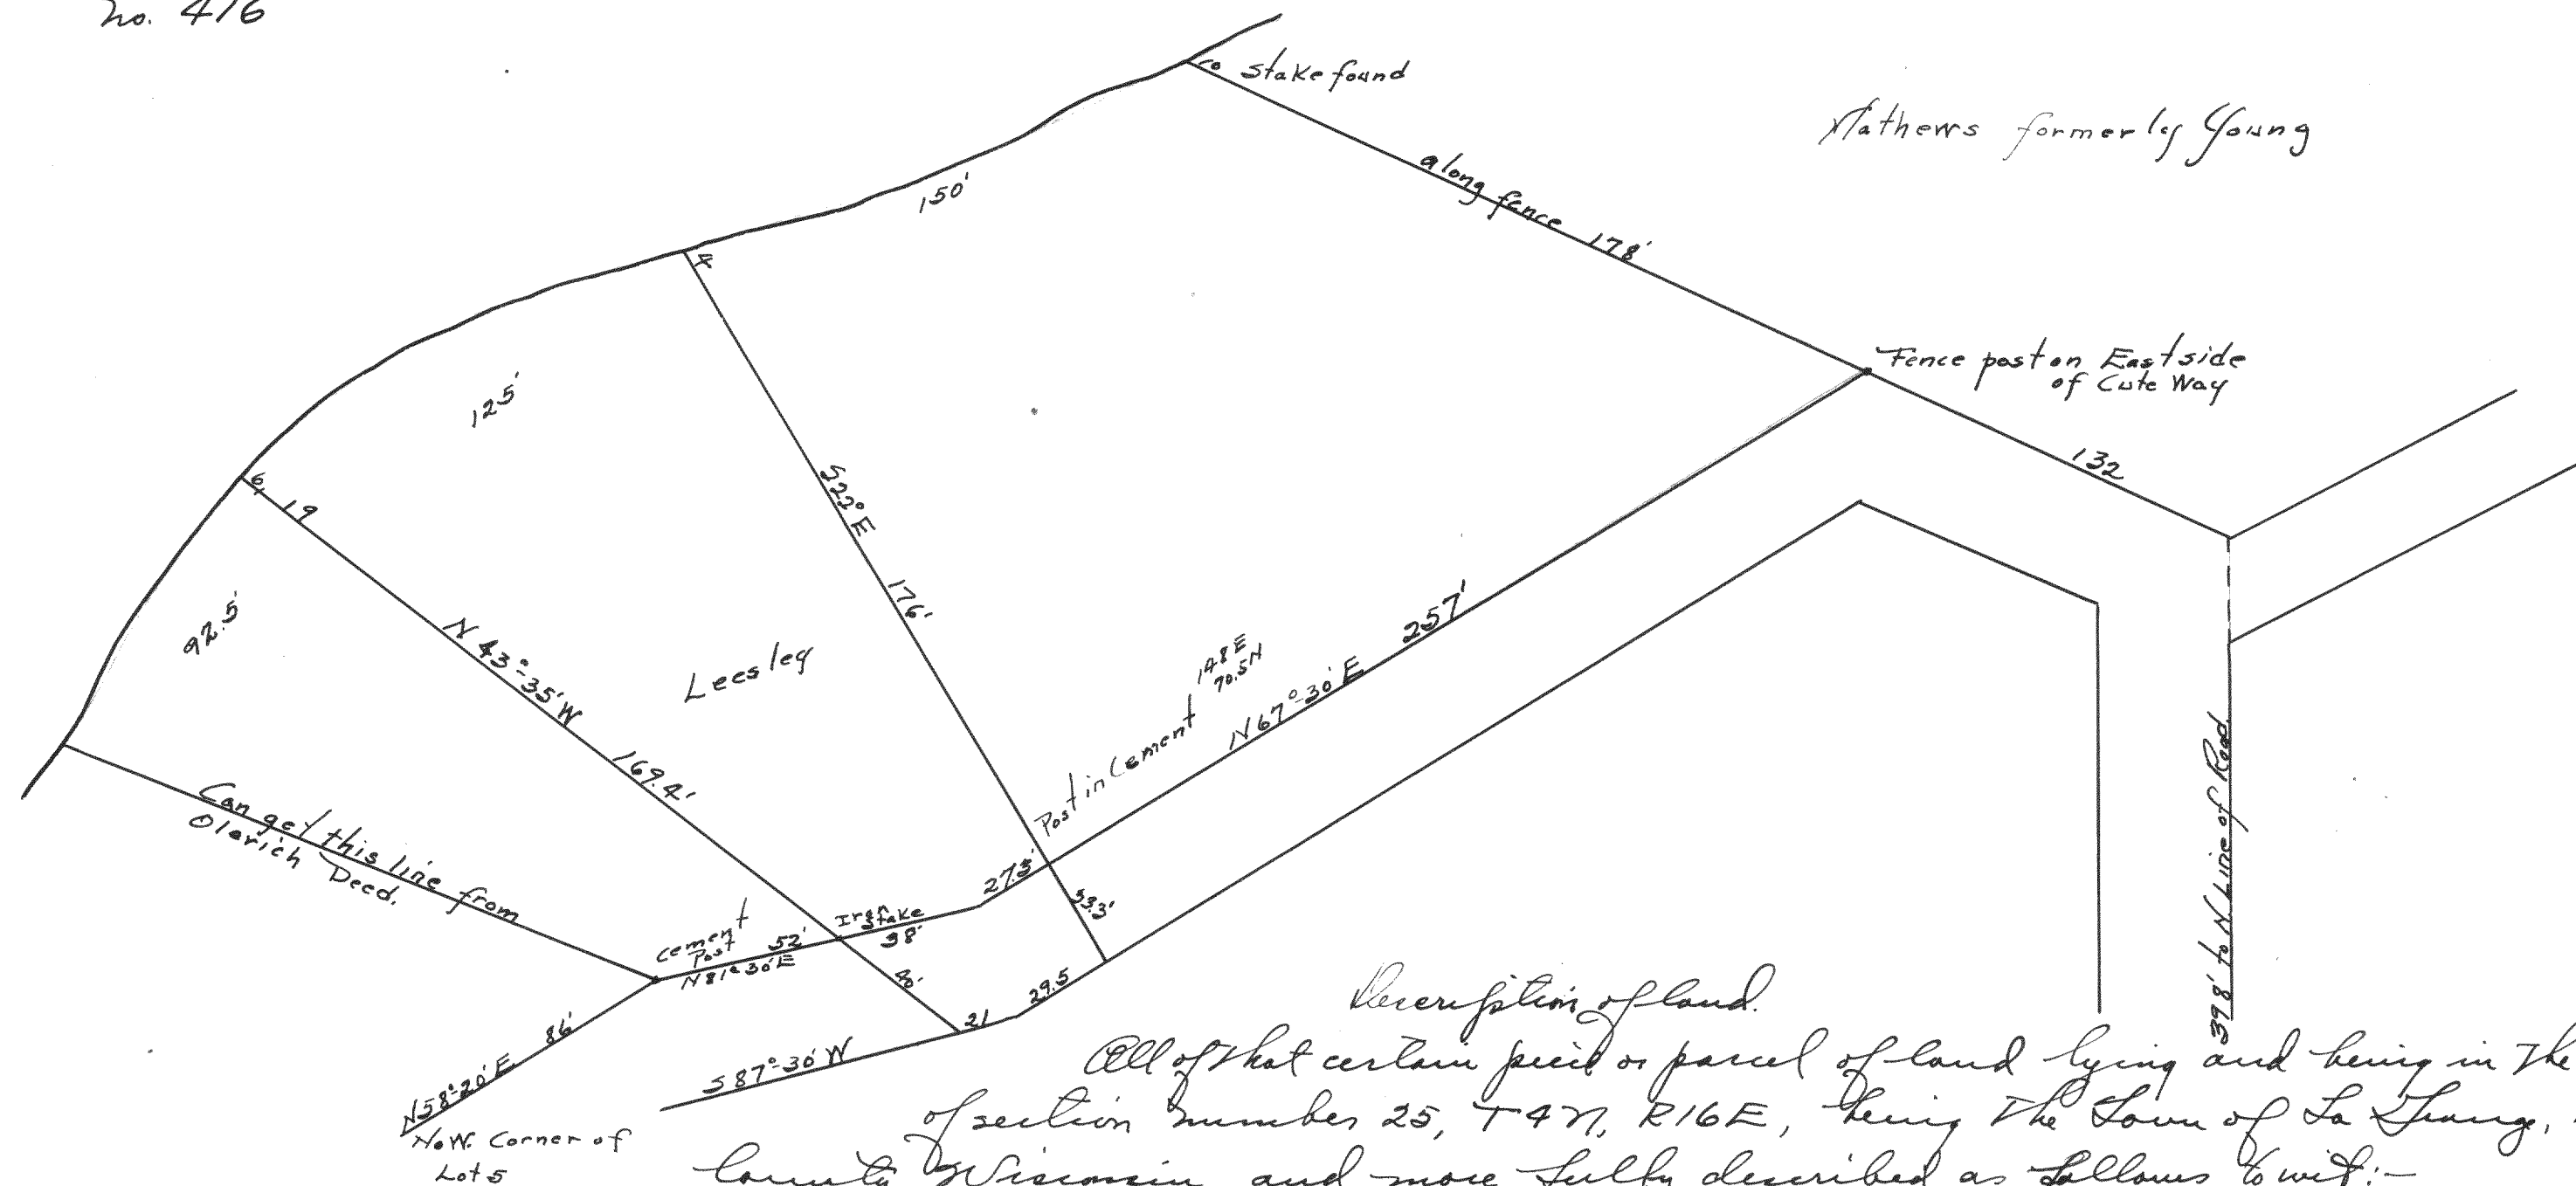

Description of land.

All of that certain piece or parcel of land lying and being in the S.W. quarter of section number 25, T47N, R16E, being the Town of La Grange, Walworth County, Wisconsin, and more fully described as follows to wit:-

Beginning at an iron stake and which iron stake may be found as follows; from the northwesterly corner of lot No. 5 of the plot of Straightville Park (which plot is recorded in the Register of Deeds office in and for said Walworth Co., in Vol. 5 of plots on page 145) N 58° 20' E 86 feet to a cement monument, and N 81° 30' E 52' to the said iron stake the place of beginning; Thence N 43° 35' W 184.4 feet to an iron stake and producing and extending said line of N 43° 35' W 6' more ± to the shore of Middle Lake at low water mark; Thence starting in a northeasterly direction and following the shore of said lake at low water line 150 feet more or less to a point; Thence S 22° E 4 feet more or less to an iron stake, and which iron stake is N 43° 35' W 169.4' & N 62° 00' E 125 feet from the place of beginning, and continuing on said line of S 22° E 176 feet more to a fence post in cement; Thence S 61° W 27.3 feet to an iron stake; Thence S 81° 30' W 38 feet to the place of beginning.

Surveyed by Wm Child

Recorded by Lloyd S. Jensen
March 19, 1934