

Record of Survey.

32-2-16

no 464

Township....., North of Range.....of 4 Principal Meridian

as presented by the courses and distances on the following plat, and annexed field-notes of survey:

Established the center of the section at the point of intersection of STRAIGHT quarter lines.

Established all quarter-quarter corners upon the section boundary at proportional distances between known section and quarter section corners, according to the original field-notes of the Government survey.

Established all lost corners at proportional distances between known corners, according to the original field-notes of the Government survey.

Being a part of Lot no. 3 of the Southwest fractional quarter of section 32, T. 2 N., R. 16 E., being the then of Delavan, Walworth Co., Wisconsin, described as follows, to wit:— from a pt. 6.125 chains East and 809.5 feet north, of the South West corner of said lot 3, go east 132 feet for the place of beginning, it being the north-east corner of the lot formerly owned by J. B. Kimball as shown by deed recorded in Vol. 180 of deeds on page 611. Thence East, being along the South line of a drive 14.5 feet to an iron stake, Thence South 50 feet to an iron stake; Thence west 14.5 feet more or less, to the Southeast corner of the Kimball lot, Thence north, being along the East line of said lot 50 feet, to the place of beginning. Together with a right of way in common with the parties of the first part, This heirs assigns, over and along a strip of land 2 rods in width East and West, and extending from the public highway on the South line of said section 32, and running north to the shore of Delavan Lake, also a right of way 25 feet wide running east and west from the first mentioned right of way along the front of the lot hereby conveyed.

Surveyed by Wm Child
cs.
Recorded by Lloyd S. Jensen
March 28, 1934

Plat of Section....., Township.....North, Range.....of 4 Principal Meridian Scale

80 chains to 6 inches. The figures in red ink are the lengths of the lines as stated in the field-notes of the Government survey.

Declination of the Magnetic Meridian from the True Meridian.....

Surveyed and sub-divided.....A. D. 1, in accordance

with the State Laws and Instructions of the Commissioner of the General Land office, and recorded on pages

.....of Register in the County Clerk's office.

Witness my hand this.....day of.....A. D. 1

SURVEYOR.

OF SECTION, QUARTER SECTION AND QUARTER QUARTER SECTION CORNERS

H. C. MILLER CO. MFG. STATIONERS, MILWAUKEE WISCONSIN															
GOVERNMENT CORNERS				Bearing				In.				Courses			
				Trees				Dia.				they bear			
				Links				Distant							
No.															
1.	N. W. Sec. Cor. identified,														
2.	N. E. Sec. Cor. identified,														
3.	S. E. Sec. Cor. identified,														
4.	S. W. Sec. Cor. identified,														
5.	N. ¼ Sec. Cor. identified,														
6.	E. ¼ Sec. Cor. identified,														
7.	S. ¼ Sec. Cor. identified,														
8.	W. ¼ Sec. Cor. identified,														
Subdivision Corners															
No.															
1.	Center ¼ Sec. Cor.														
2.	North ¼-¼s N. W. qr.,														
3.	East ¼-¼s N. W. qr.,														
4.	South ¼-¼s N. W. qr.,														
5.	West ¼-¼s N. W. qr.,														
6.	Center ¼-¼s N. W. qr.,														
7.	North ¼-¼s N. E. qr.,														
8.	East ¼-¼s N. E. qr.,														
9.	South ¼-¼s N. E. qr.,														
10.	Center ¼-¼s N. E. qr.,														
11.	East ¼-¼s S. E. qr.,														
12.	South ¼-¼s S. E. qr.,														
13.	West ¼-¼s S. E. qr.,														
14.	Center ¼-¼s S. E. qr.,														
15.	South ¼-¼s S. W. qr.,														
16.	West ¼-¼s S. W. qr.,														
17.	Center ¼-¼s S. W. qr.														

No. 465 Rockford Colony C. H. Lodgery

28-2-16

Found iron stake at southeast corner of lot 6, also at N.E. corner found wooden stake and at N.E. corner of lot 8 found iron stakes by Tubbs according to W. C. Privy legs statement West 168 feet from This line and set stake to site. Near S.W. corner of lot 11 found stake hole 42 ft. from fence but only 167 feet from C. line. At S.E. corner of 9 found stake and stake hole at S.E. corner of 543 which are in line from S.E. of 5, West 67½ ft. and find slight evidence of stake. Set new stake and from This ran line North to point 168 feet West of East line as established and on This line set stakes 42-84-126 ft. North which comes to line of old stake found. Leaving 4 ft. more to fence. From first stake set on This line South 42 ft. set iron stake that is 27½ Northwest of N.W. corner of house S.E. and 27½ feet N.E. from N.E. corner of house S.W. This line hits cherry tree at North end. Made mark on tree.

Surveyed by Wm Child
Oct. 1903
Recorded by Lloyd J. Jensen

CHAINMEN

NAMES OF SWORN ASSISTANTS

FLAGMEN


AXMEN

no 465
Rockford Colony
28-2-16
C. H. Lodgney
Found iron stake at southeast corner of lot 6, also at N. E. corner found wooden stake and at N. E. corner of lot 8 found iron stake set by Tubbs according to W. C. Quigley's statement. West 168 feet from this line and set stake to site. Near S. W. corner of lot 11 found stake hole 42 ft. from fence but only 167 feet from C. line. At S. E. corner of 9 found stake and stake hole at S. E. corner of 543 which are in line from S. E. of 5, West 67½ ft. and find slight evidence of stake. Set new stake and from this ran line north to point 168 ft. West of East line as established and on this line set stakes 42-84-126 ft. north which comes to line of old stake found. Leaving 42 ft. more to fence. From first stake set on this line South 42 ft. set iron stake that is 27 ft. northwest of N. W. corner of house S. E. and 27½ feet N. E. from N. E. corner of house S. W. This line hits cherry tree at north end. Made mark on tree.

Surveyed by Wm Child
cs.
Oct. 1903
Recorded by Lloyd S. Jensen
March 28, 1934

29-2-16

Willow Point Park

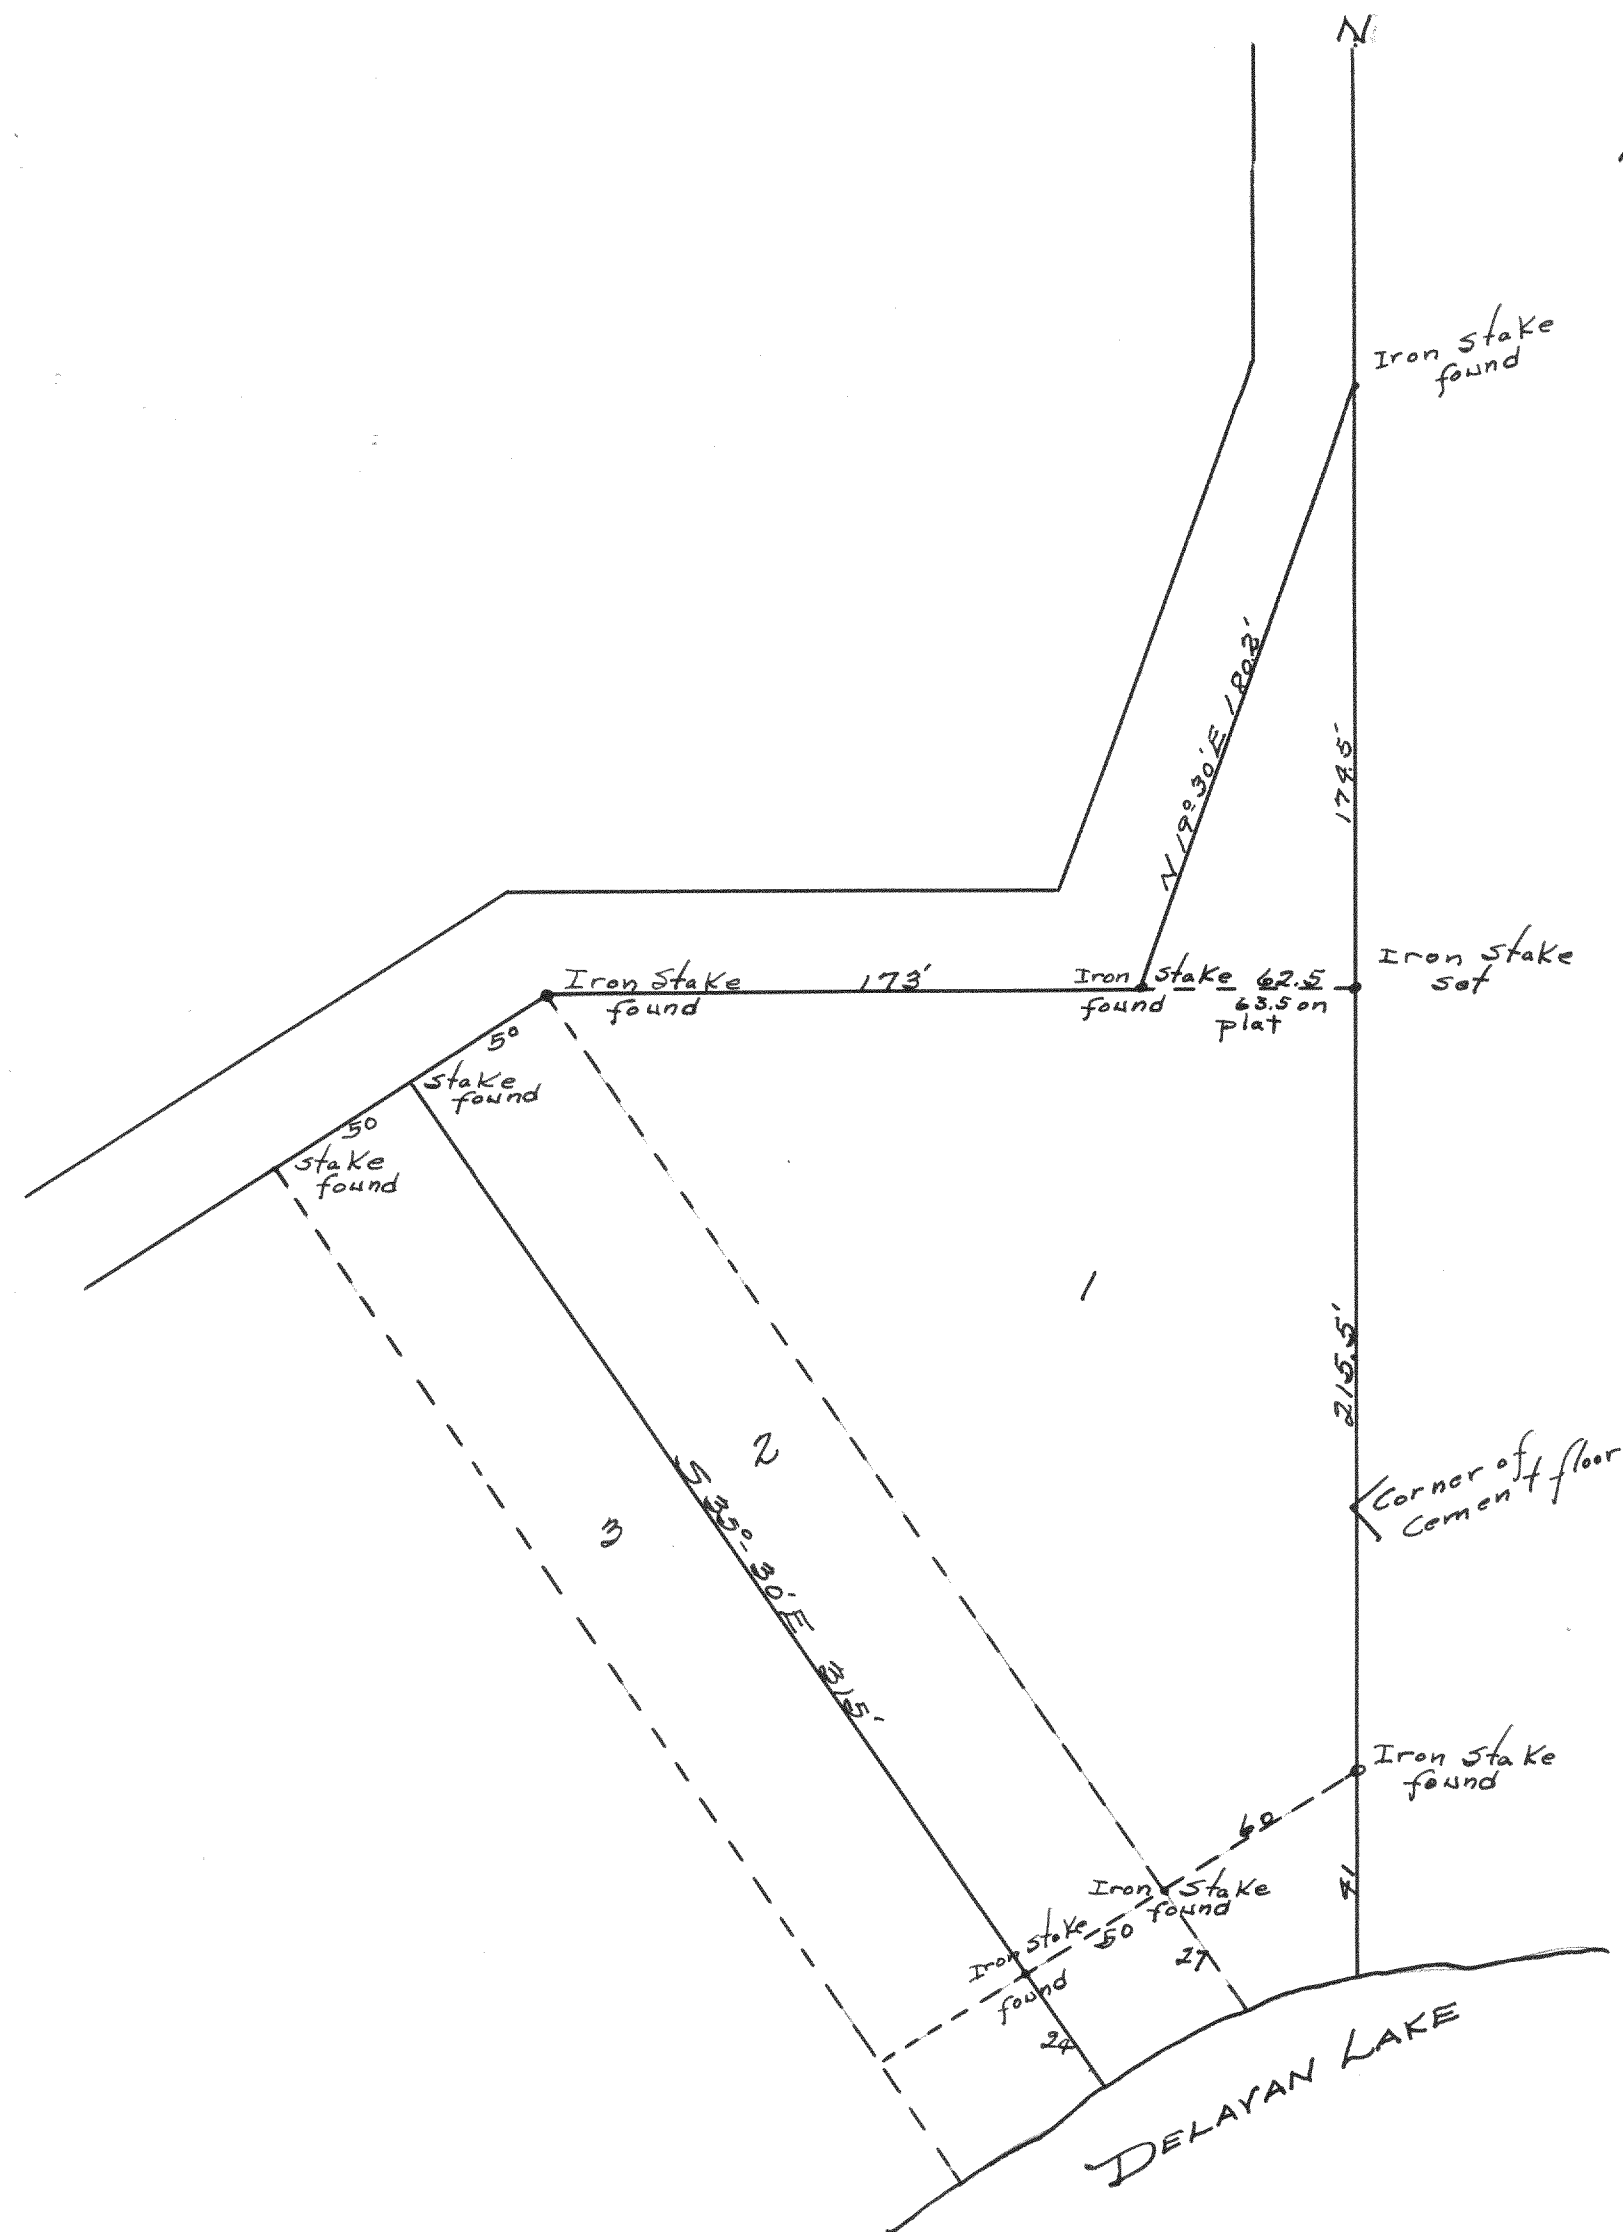

Plot of a survey made for C. J. Biggott Jr. of St. Louis to relocate the corners and lines of lots no. 1 & 2 of the plot of Willow Point. Which plot is on record in the Register of Deeds office in and for Walworth County, Wisconsin in Volume 7 of plots on page 28 and being located on Delavan Lake in the Town of Delavan in the said County of Walworth.

Elkhorn July 7, 1924

Wm. Child
cs

Reviewed by Lloyd S. Jensen
March 28, 1934