

DESCRIPTION

Record of Survey.

OF SECTION, QUARTER SECTION AND QUARTER QUARTER SECTION CORNERS

No 467

25-4-16

Township....., North of Range..... of 4 Principal Meridian

as presented by the courses and distances on the following plat, and annexed field-notes of survey:

Established the center of the section at the point of intersection of STRAIGHT quarter lines.

Established all quarter-quarter corners upon the section boundary at proportional distances between known

section and quarter section corners, according to the original field-notes of the Government survey.

Established the east corners at the intersection of the section and township lines, according to the original field

notes of the Government survey.

Description of South piece
All of that certain piece or parcel of land lying and being in the northeast quarter of section 25 T 4 N. R 16 E, being the Township of La Crosse, Walworth County, Wisconsin, described as follows to wit:-

Beginning at an iron stake, on the Easterly shore of Pleasant Lake, That is $525^{\circ}-15'W$ 60 feet from an iron stake, at the point where the north line of said section 25 intersects the said lake shore, and the said stake being witnessed by, a cotton wood tree southerly 15.5 feet, and an oak tree, Easterly, 17 feet; Thence $578^{\circ}-00'E$ 105 feet, to a stake; Thence $543^{\circ}-30'W$ 90 feet to a stake; Thence $763^{\circ}-00'W$ 73.5 feet to a stake on the shore of said lake; Thence $725^{\circ}-15'E$ Easterly along the said shore 60 feet to the place of beginning, excepting and reserving, for a right of way to be used in common with others, a strip of land, 10 feet in width off of the southeasterly side of the above described piece.

Surveyed by Wm Child
CS.

Recorded by Lloyd L. Jensen
CS.

Plat of Section....., Township..... North, Range..... of 4 Principal Meridian

80 chains to 6 inches. The figures in red ink are the lengths of the lines as stated in the field-notes of the

Government survey.

Declination of the Magnetic Meridian from the True Meridian.....

Surveyed and sub-divided..... A. D. 1....., in accordance

with the State Laws and Instructions of the Commissioner of the General Land office, and recorded on pages

..... of Register in the County Clerk's office.

Witness my hand this..... day of..... A. D. 1.....

SURVEYOR.

GOVERNMENT CORNERS

No.

1. N. W. Sec. Cor. identified,

2. N. E. Sec. Cor. identified,

3. S. E. Sec. Cor. identified,

4. W. Sec. Cor. identified,

5. N. $\frac{1}{4}$ Sec. Cor. identified,

6. E. $\frac{1}{4}$ Sec. Cor. identified,

7. S. $\frac{1}{4}$ Sec. Cor. identified,

8. W. $\frac{1}{4}$ Sec. Cor. identified,

Subdivision Corners

No.

1. Center $\frac{1}{4}$ Sec. Cor.

2. North $\frac{1}{4}-\frac{1}{4}$ s N. W. qr.,

3. East $\frac{1}{4}-\frac{1}{4}$ s N. W. qr.,

4. South $\frac{1}{4}-\frac{1}{4}$ s N. W. qr.,

5. West $\frac{1}{4}-\frac{1}{4}$ s N. W. qr.,

6. Center $\frac{1}{4}-\frac{1}{4}$ s N. E. qr.,

7. North $\frac{1}{4}-\frac{1}{4}$ s N. E. qr.,

8. East $\frac{1}{4}-\frac{1}{4}$ s N. E. qr.,

9. South $\frac{1}{4}-\frac{1}{4}$ s N. E. qr.,

10. Center $\frac{1}{4}-\frac{1}{4}$ s S. E. qr.,

11. East $\frac{1}{4}-\frac{1}{4}$ s S. E. qr.,

12. South $\frac{1}{4}-\frac{1}{4}$ s S. E. qr.,

13. West $\frac{1}{4}-\frac{1}{4}$ s S. E. qr.,

14. Center $\frac{1}{4}-\frac{1}{4}$ s S. W. qr.,


15. South $\frac{1}{4}-\frac{1}{4}$ s S. W. qr.,

16. West $\frac{1}{4}-\frac{1}{4}$ s S. W. qr.,

17. Center $\frac{1}{4}-\frac{1}{4}$ s S. W. qr.

No 468

DELAYAN LAKE

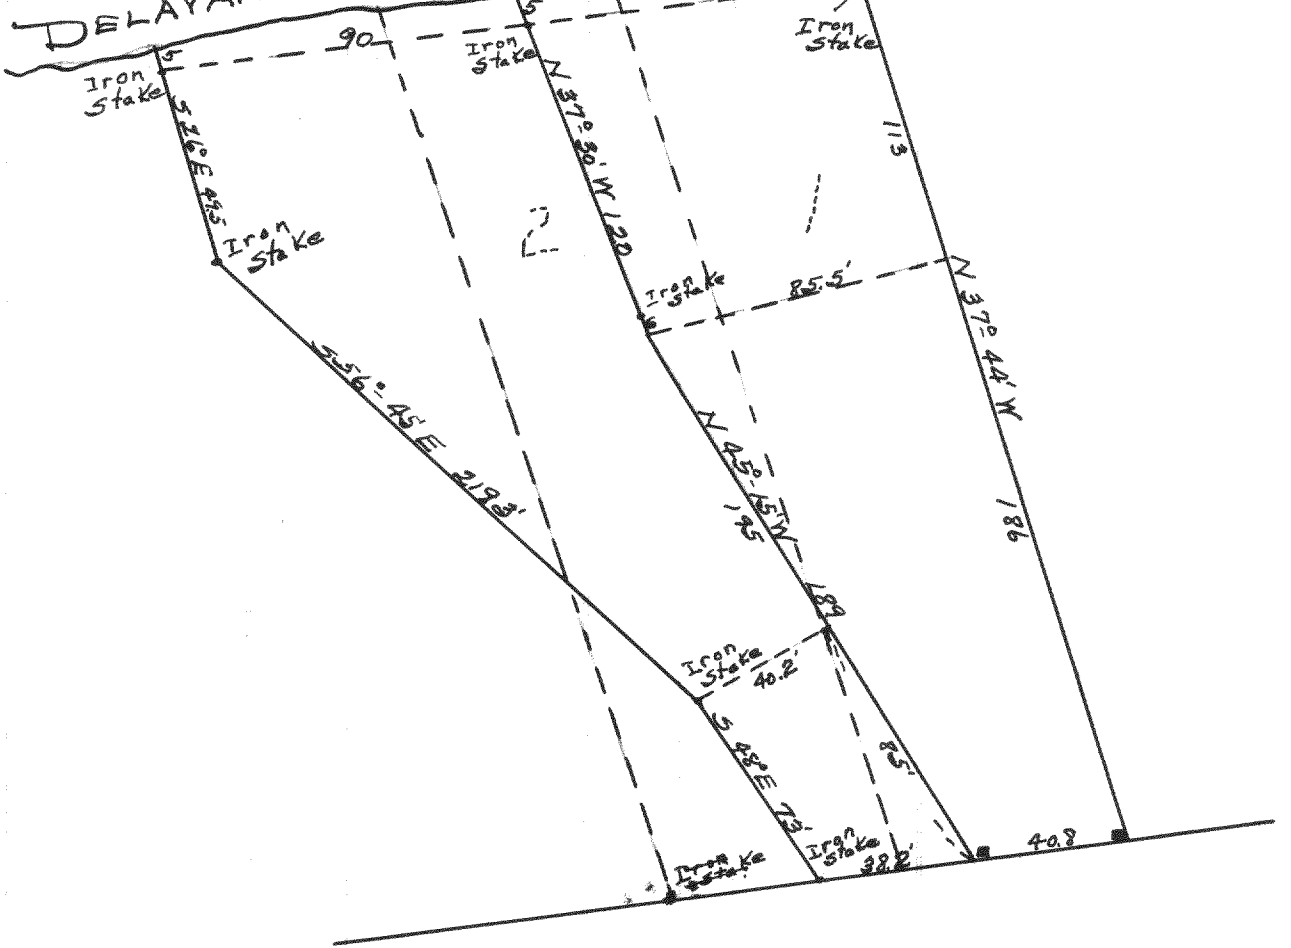

Plat of a survey made for Charles Lutz of Chicago in lots 1-293 of the plat of Sans Souci, which Plat is on record in the Register of Deeds office in and for Walworth County, Wisconsin, in Vol. 5 of Plats on page 62

Attest June 9, 1924
Wm Child
CS.

Recorded by Lloyd L. Jensen
CS.
March 29, 1934

NAMES OF SWORN ASSISTANTS


CHAINMEN

FLAGMEN

AXMEN

no 469

18-2-16

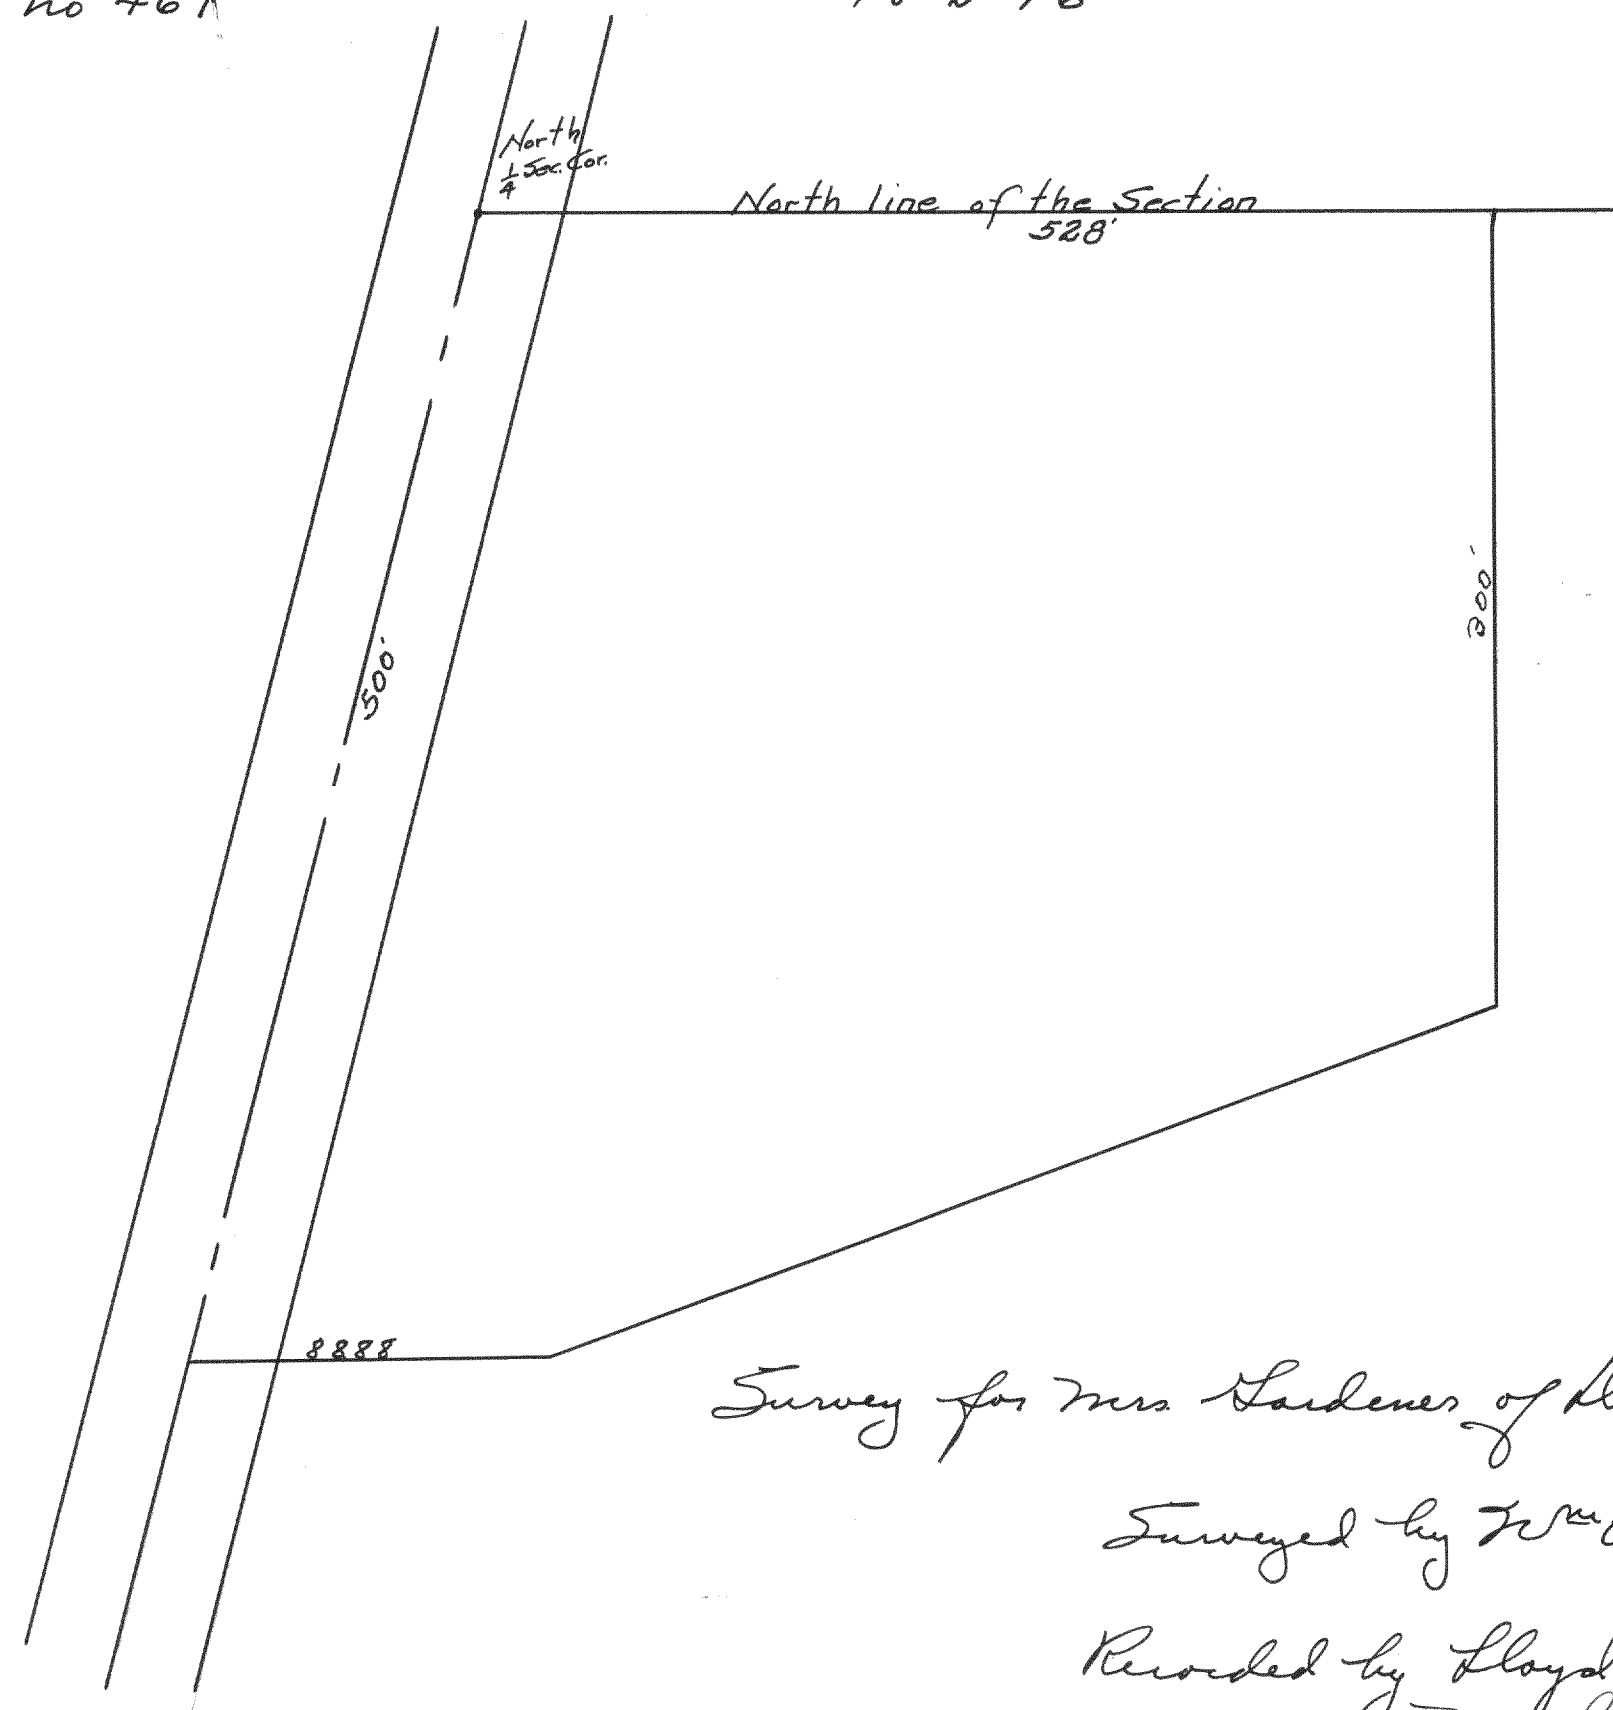

Survey for Mrs. Sanderus of Delavan

Surveyed by W^m Child
CSRecorded by Lloyd S. Jensen
CS
March 29, 1934

no 470

28-2-16

That certain piece or parcel of land lying and being in the northwest quarter of Section no. 28, T2N, R16E, being the Town of Delavan, Walworth County, Wisconsin, described as follows to wit: Beginning at a point $1\frac{1}{2}$ rods south and 7 rods $5\frac{1}{2}$ ft. West of the Northeast corner of the said quarter section, being also the center of the road; thence south on a line parallel with the East line of said q. section 466.09 feet to an iron stake; thence Westerly 375.7 feet to a stake; thence north parallel with the East line of said quarter section 461.39 feet to a point $1\frac{1}{2}$ rods South of the North line of the said quarter section, being the center of the road; thence East being along the center of said road 375.7 feet to the place of beginning containing four (4) acres of land.

Surveyed by W^m Child
CSRecorded by Lloyd S. Jensen
CS
March 29, 1934