

DESCRIPTION

Record of Survey.

29432-2-16

OF SECTION, QUARTER SECTION AND QUARTER QUARTER SECTION CORNERS

no 479


Township..... North of Range..... of 4 Principal Meridian

as presented by the courses and distances on the following plat, and annexed field-notes of survey:

Established the center of the section at the point of intersection of STRAIGHT quarter lines. *Road*

Established all quarter-quarter corners upon the section boundary at proportional distances between known section and quarter section corners, according to the original field-notes of the Government survey.

Established all lost corners at proportionate distances between known corners, according to the original field notes of the Government survey.

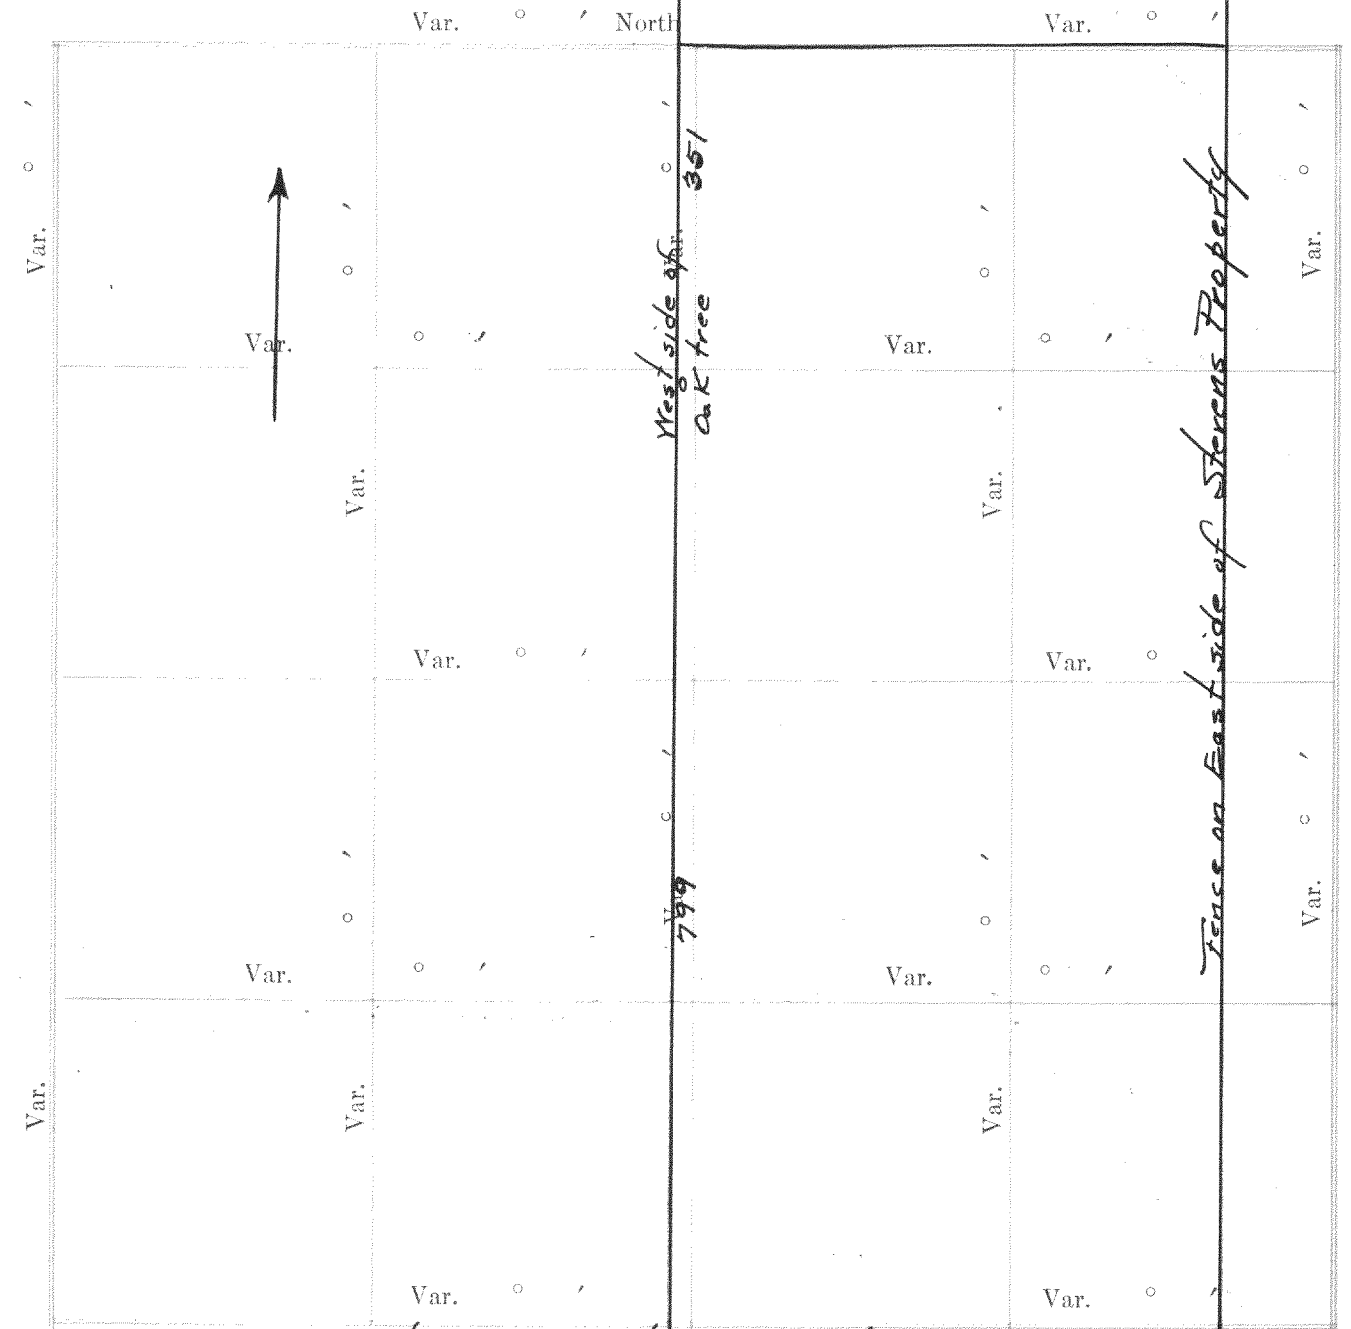

Plat of Section..... Township..... North, Range..... of 4 Principal Meridian Scale

80 chains to 6 inches. The figures in red ink are the lengths of the lines as stated in the field-notes of the Government survey.

Declination of the Magnetic Meridian from the True Meridian.....

Surveyed and sub-divided..... A. D. 1....., in accordance

with the State Laws and Instructions of the Commissioner of the General Land office, and recorded on pages

..... of Register in the County Clerk's office.

Witness my hand this..... day of..... A. D. 1

..... SURVEYOR.

GOVERNMENT CORNERS

No.

1. N. W. Sec. Cor. identified,

2. N. E. Sec. Cor. identified,

3. S. E. Sec. Cor. identified,

4. S. W. Sec. Cor. identified,

5. N. 1/4 Sec. Cor. identified,

6. E. 1/4 Sec. Cor. identified,

7. S. 1/4 Sec. Cor. identified,

8. W. 1/4 Sec. Cor. identified,

Subdivision Corners

No.

1. Center 1/4 Sec. Cor.

2. North 1/4-1/4s N. W. qr.,

3. East 1/4-1/4s N. W. qr.,

4. South 1/4-1/4s N. W. qr.,

5. West 1/4-1/4s N. W. qr.,

6. Center 1/4-1/4s N. W. qr.,

7. North 1/4-1/4s N. E. qr.,

8. East 1/4-1/4s N. E. qr.,

9. South 1/4-1/4s N. E. qr.,

10. Center 1/4-1/4s N. E. qr.,

11. East 1/4-1/4s S. E. qr.,

12. South 1/4-1/4s S. E. qr.,

13. West 1/4-1/4s S. E. qr.,

14. Center 1/4-1/4s S. E. qr.,

15. South 1/4-1/4s S. W. qr.,

16. West 1/4-1/4s S. W. qr.,

17. Center 1/4-1/4s S. W. qr.

Bearing	In.	Courses	Links	Bearing	In.	Courses	Links	Bearing	In.	Courses	Links	Bearing	In.	Courses	Links
Trees	Dia.	they bear	Distant	Trees	Dia.	they bear	Distant	Trees	Dia.	they bear	Distant	Trees	Dia.	they bear	Distant

*Plat of survey of part of what was formerly
The Chad. Stevens farm now owned by Jane T.
Moulding.
Surveyed by Wm Child
Recorded by Lloyd S. Jensen
March 30, 1934*

NAMES OF SWORN ASSISTANTS

CHAINMEN

FLAGMEN

AXMEN

22-2-16

Part of Block 2 of San Sauer


Descriptions from surveys.

Commencing at The N.W. corner of Ernest C. Smith's land, Thence E. along said Smith's N. line 104 ft. to an iron stake; Thence NWly 110 feet to an iron stake at the S. side of the road; Thence SWly along the south side of said road, 91.4 ft. more or less to an iron stake on the Ely side of road 58 ft. 9 inches N. of the NW. corner of said Smith's land, Thence South 58 ft. 9 inches to the place of beginning. Also beginning at the iron fence post at the S.E. corner of the above described lot; Thence west being along the south line of said lot, 37 ft. to the N.E. corner of the lot owned by one Smith, Thence South being along the E. line of said Smith lot and the E. line of the lot owned by Mr. Andrus 95 ft. to the S.E. corner of said Andrus lot, it being on the N. line of the lot owned by one Liffenhagen, Thence E. being along the N. line of said Liffenhagen lot 121.5 ft. to a fence post on the W. line of a lot owned by A. Blodgett; Thence North being along the W. line of said Blodgett's lot and the West line of a portion of the lot owned by Mrs. Anderson 101.5 ft. to a fence post, Thence West being along the S. line of a portion of the lot owned by said Anderson 34.5 ft. to an iron stake at the S.W. corner thereof and continuing NWly 36.5 ft. to the place of beginning. All in Sec. 22, T2N, R16E of the 4th T. M. Walworth County, Wisconsin.

Surveyed by Wm Child

Recorded by Lloyd S. Jensen
March 30, 1934

22-2-16

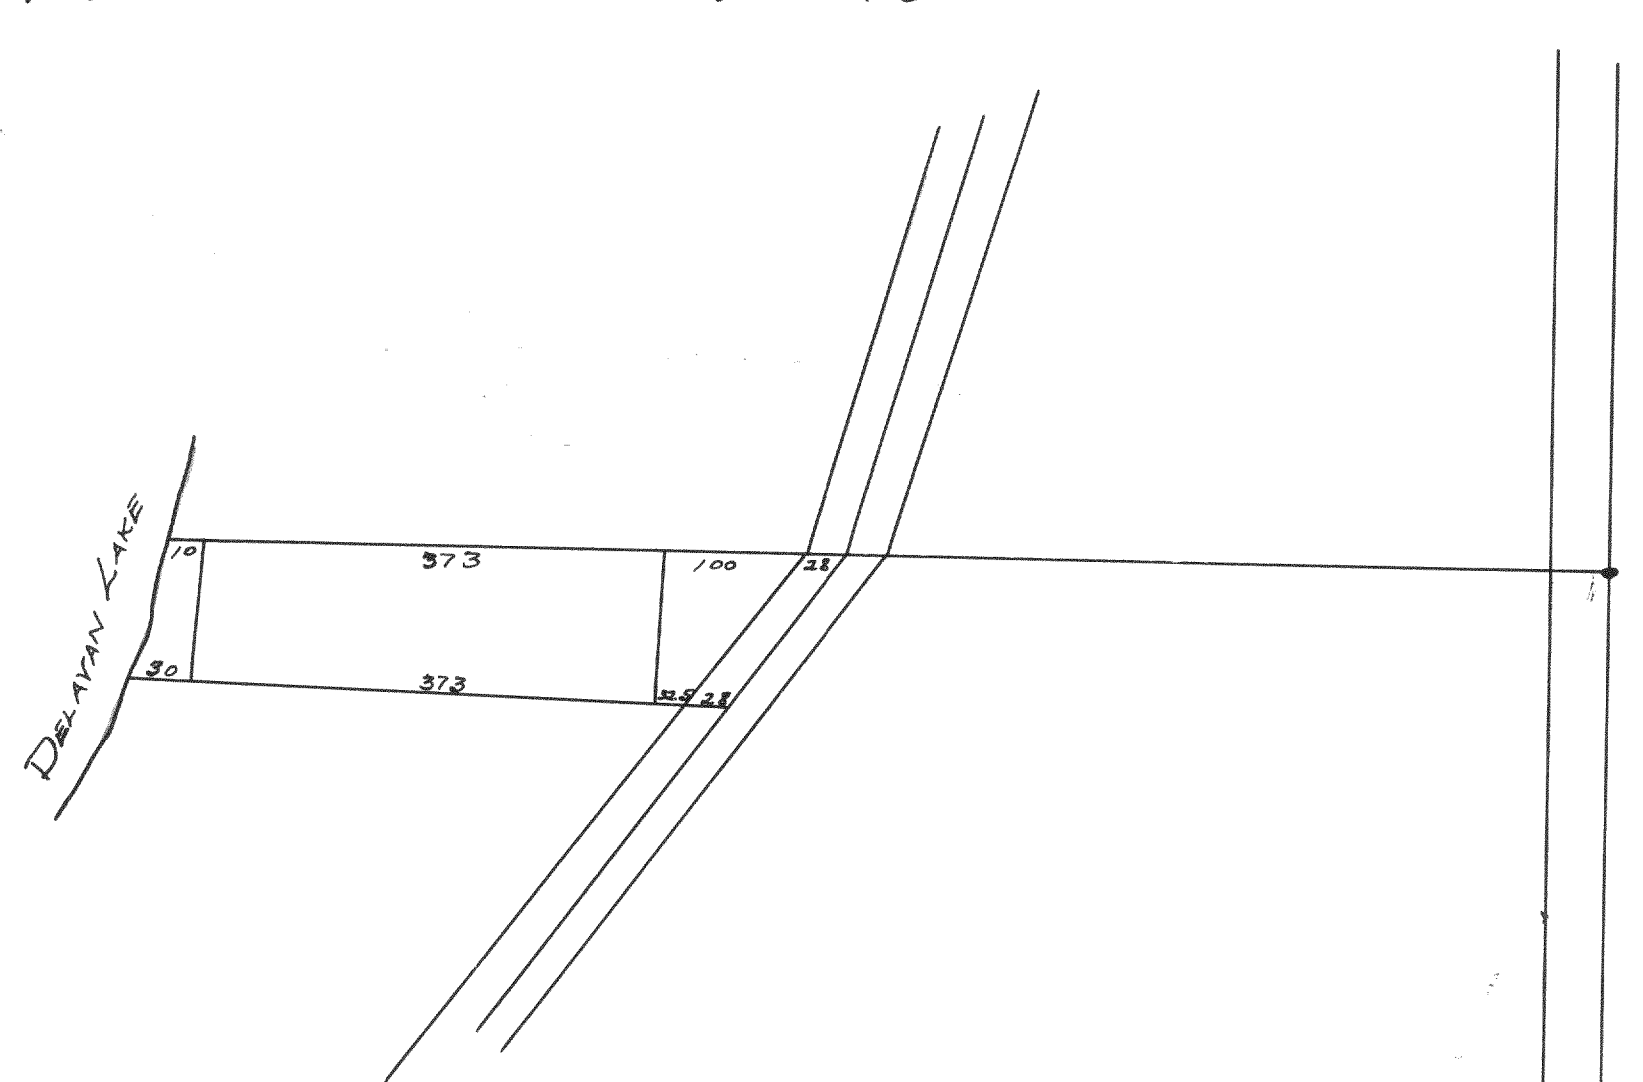

Plot of survey of Mrs. Mervens lot in
Section 22, T2N, R16E.

Surveyed by Wm Child

Recorded by Lloyd S. Jensen
March 30, 1934