


DESCRIPTION

Record of Survey.

no 488

33-2-16

Township..... North of Range..... of 4 Principal Meridian
as presented by the courses and distances on the following plat, and annexed field-notes of survey:
Established the center of the section at the point of intersection of STRAIGHT quarter lines.
Established all quarter-quarter corners on the section boundary at proportional distances between known section and quarter section corners according to the original field-notes of the Government survey.
Established all quarter corners at proportional distances between known corners, according to the original field notes of the Government survey.

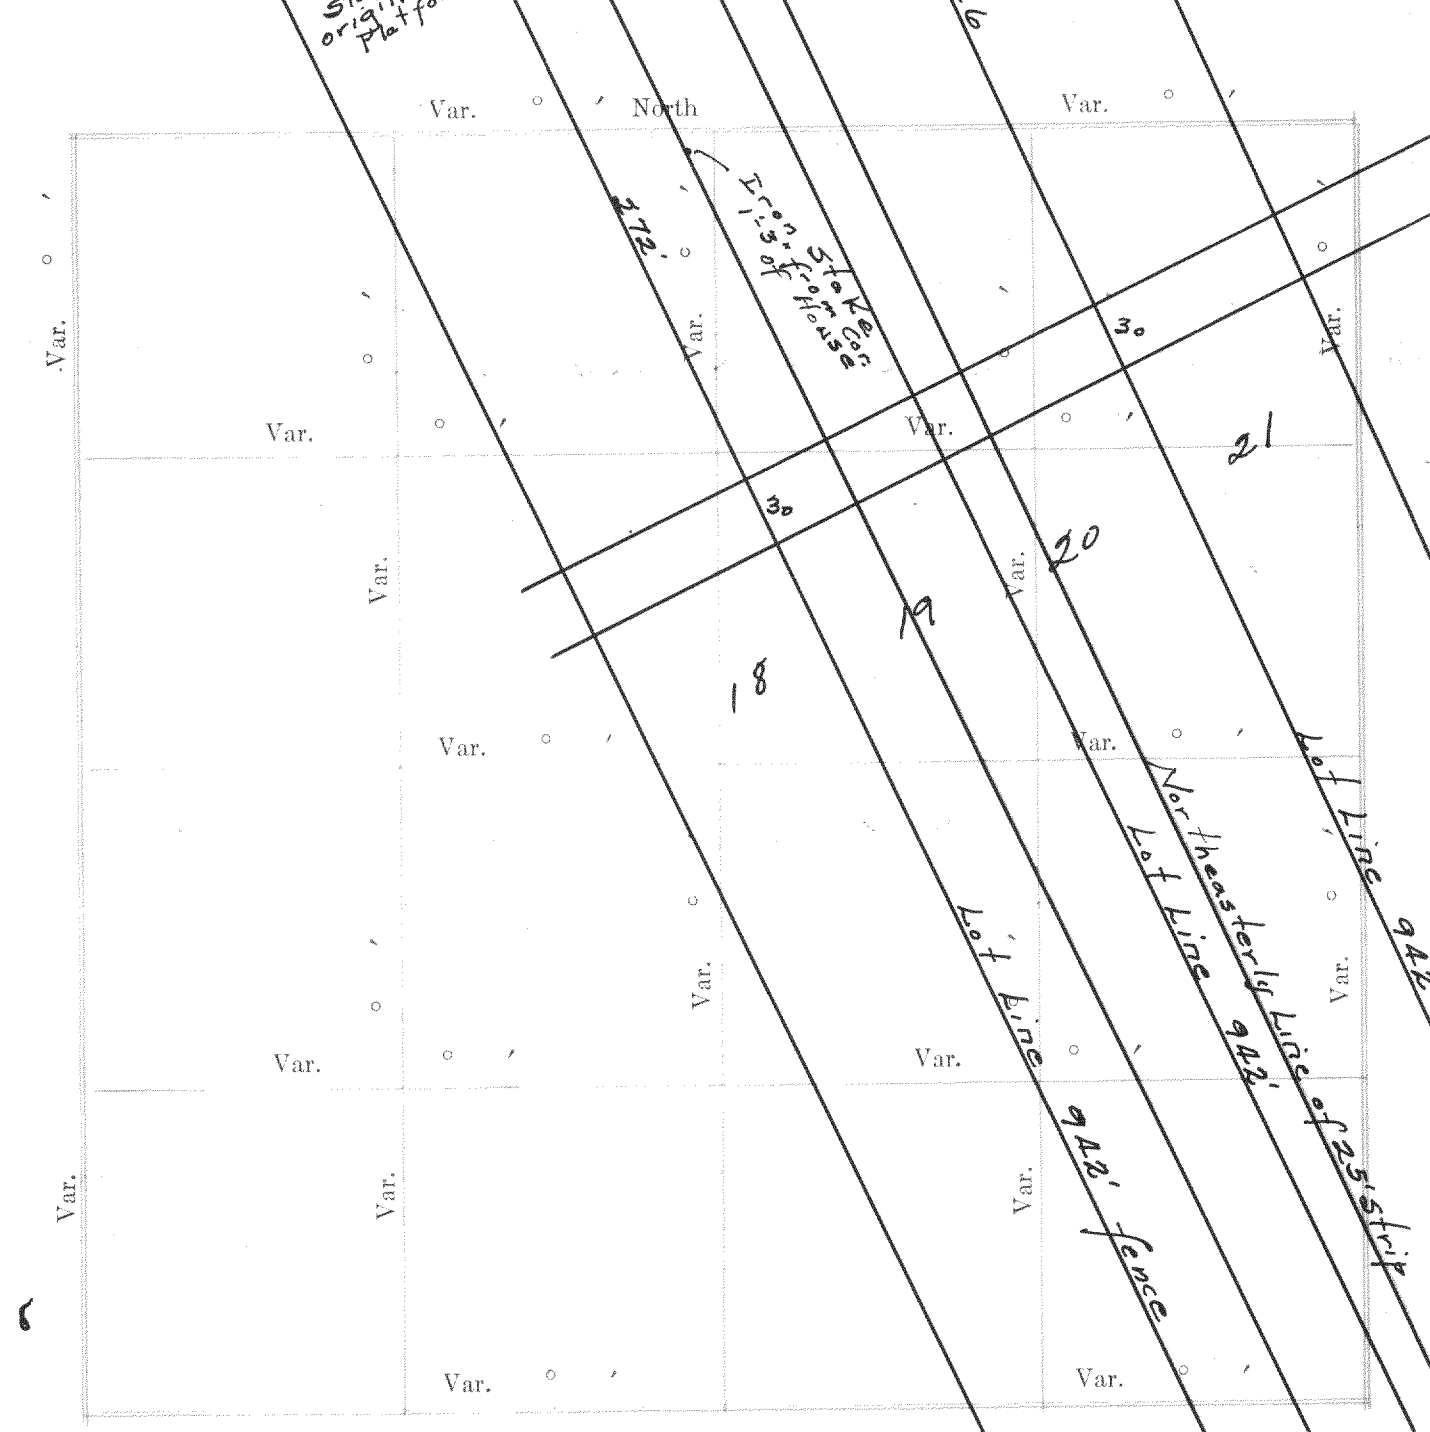

Plat of Section..... Township..... North, Range..... of 4 Principal Meridian Scale
80 chains to 6 inches. The figures in red ink are the lengths of the lines as stated in the field-notes of the
Government survey.

Declination of the Magnetic Meridian from the True Meridian.....
Surveyed and sub-divided..... A. D. 1..... in accordance
with the State Laws and Instructions of the Commissioner of the General Land office, and recorded on pages
..... of Register in the County Clerk's office.

Witness my hand this..... day of..... A. D. 1.....
..... SURVEYOR.

OF SECTION, QUARTER SECTION AND QUARTER QUARTER SECTION CORNERS

GOVERNMENT CORNERS				H. C. MILLER CO., MFG. STATIONERS, MILWAUKEE WISCONSIN							
Bearing	In.	Courses	Links	Bearing	In.	Courses	Links	Bearing	In.	Courses	Links
Trees	Dia.	they bear	Distant	Trees	Dia.	they bear	Distant	Trees	Dia.	they bear	Distant

- No.
1. N. W. Sec. Cor. identified,
2. N. E. Sec. Cor. identified,
3. S. E. Sec. Cor. identified,
4. S. W. Sec. Cor. identified,
5. N. 1/4 Sec. Cor. identified,
6. E. 1/4 Sec. Cor. identified,
7. S. 1/4 Sec. Cor. identified,
8. W. 1/4 Sec. Cor. identified,
Subdivision Corners

- No.
1. Center 1/4 Sec. Cor.
2. North 1/4-1/4s N. W. qr.,
3. East 1/4-1/4s N. W. qr.,
4. South 1/4-1/4s N. W. qr.,
5. West 1/4-1/4s N. W. qr.,
6. Center 1/4-1/4s N. W. qr.,
7. North 1/4-1/4s N. E. qr.,
8. East 1/4-1/4s N. E. qr.,
9. South 1/4-1/4s N. E. qr.,
10. Center 1/4-1/4s N. E. qr.,
11. East 1/4-1/4s S. E. qr.,
12. South 1/4-1/4s S. E. qr.,
13. West 1/4-1/4s S. E. qr.,
14. Center 1/4-1/4s S. E. qr.,
15. South 1/4-1/4s S. W. qr.,
16. West 1/4-1/4s S. W. qr.,
17. Center 1/4-1/4s S. W. qr.

Plat of survey in the subdivision of
Mellower in Section 33, T27N, R16E.


Surveyed by Wm Child Es.

Recorded by Lloyd S. Jensen
March 31, 1934

Public Road

NAMES OF SWORN ASSISTANTS


FLAGMEN AXMEN

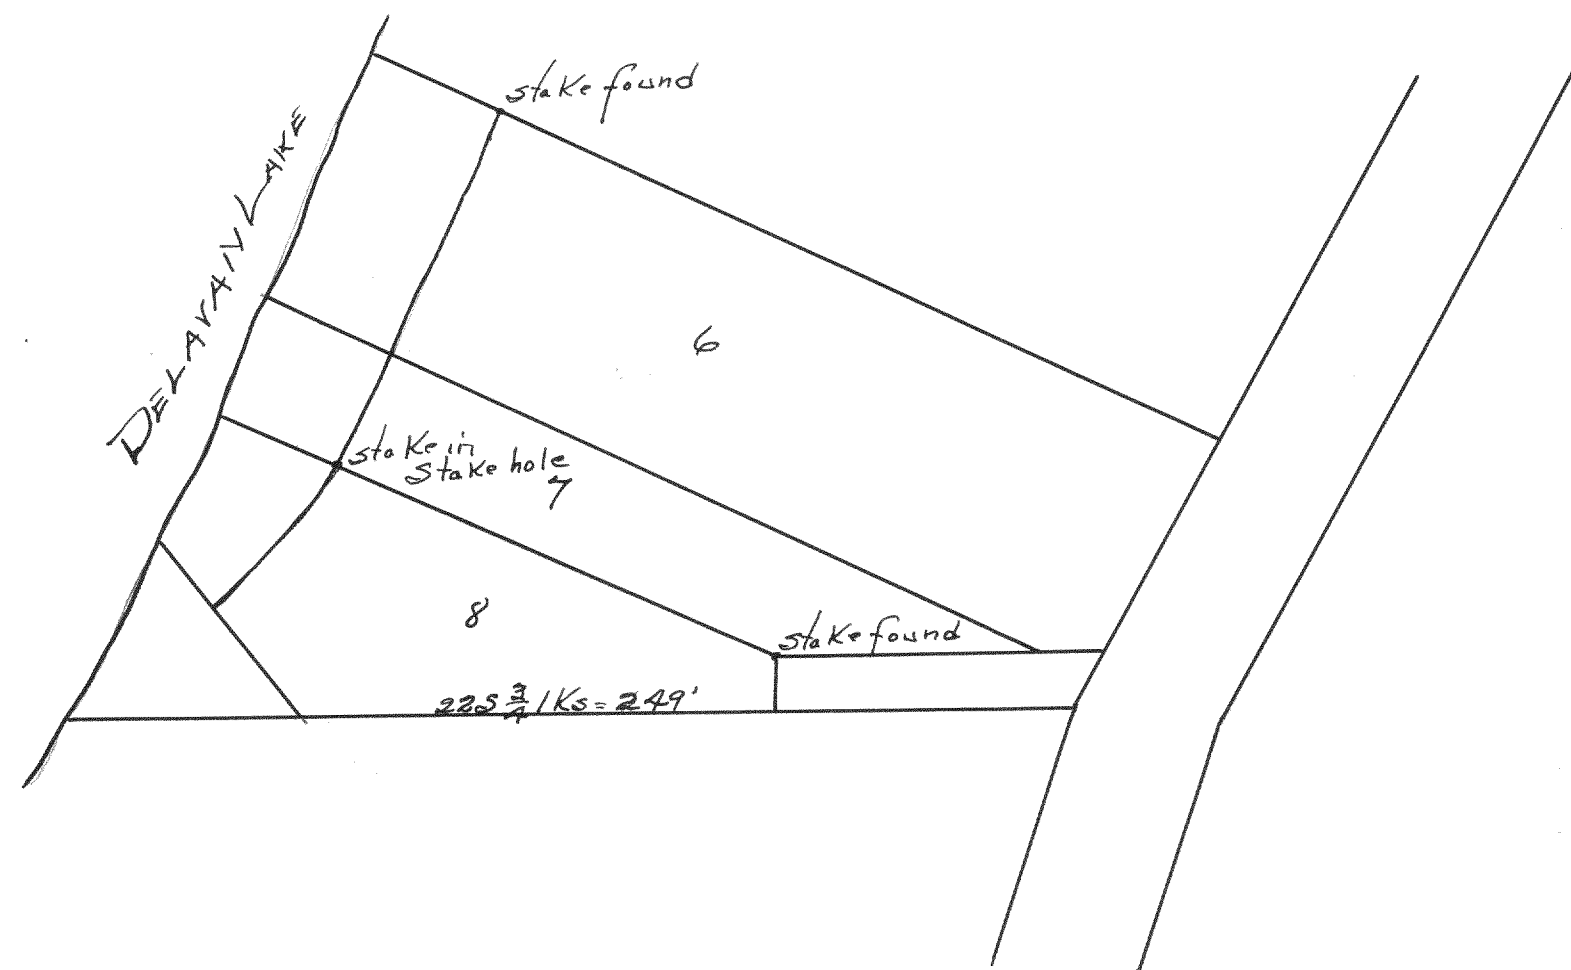

Plot of survey of lots in Merchants Park.
Located on Delavan Lake in Section 27, T2N, R16E.

Surveyed by Wm Child^{CS}

Recorded by Lloyd S. Jensen^{CS}
March 31, 1934

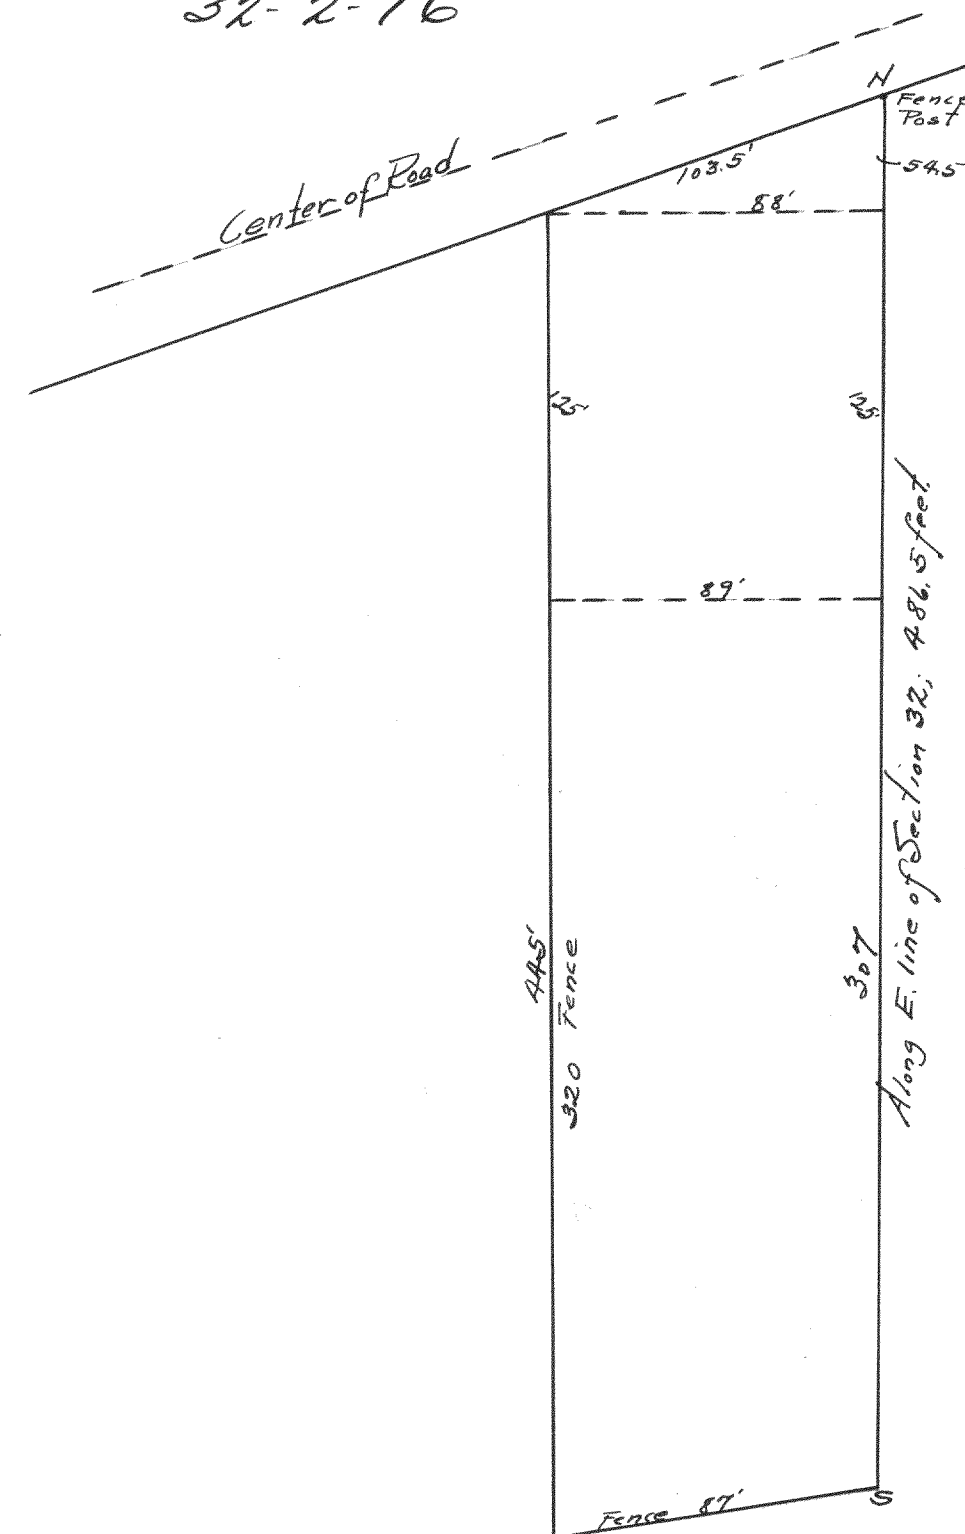

Plot of a survey made by direction of
Adelia D. Shultz of Walworth to show the
boundary of land occupied by C. B. Laves Jr., located
in the east half of Section 32, T2N, R16E, being
the Town of Delavan, Walworth County, Wisconsin.
The description of the land is in deed recorded in the
Register of Deeds' office in and for the said County
in Volume 189 of Deeds on page 538. Elkhorst Oct 13, 1927
Wm Child^{CS}

Recorded by Lloyd S. Jensen^{CS}
March 31, 1934