


OF SECTION, QUARTER SECTION AND QUARTER QUARTER SECTION CORNERS

No. 37

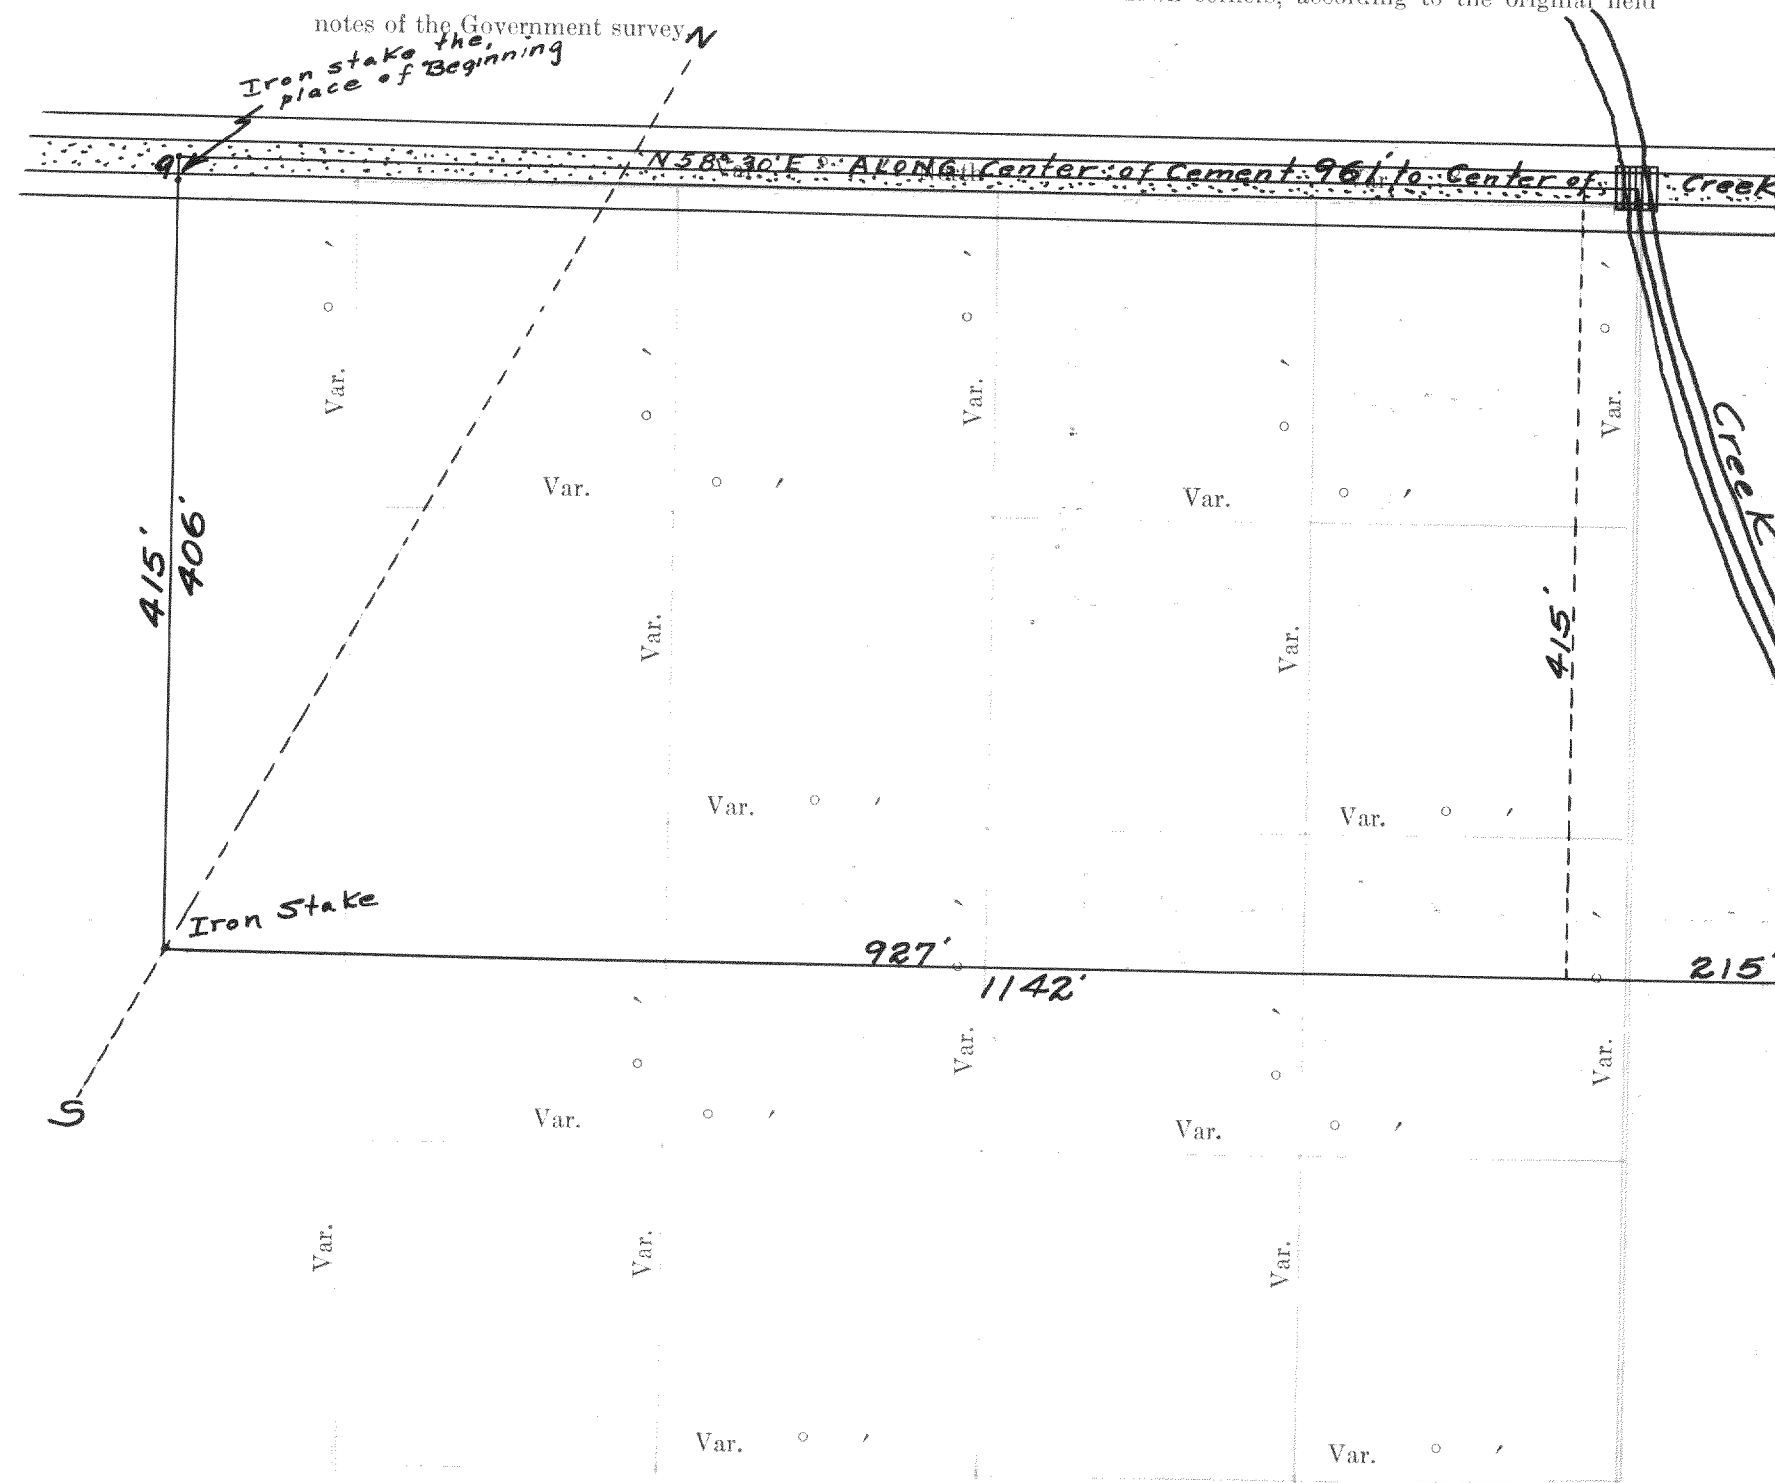

Declination of the Magnetic Meridian from the True Meridian.....

Surveyed and sub-divided.....A. D. 1 , in accordance

with the State Laws and Instructions of the Commissioner of the General Land office, and recorded on pages

.....of Register in the County Clerk's office.

....SURVEYOR.

- No.
1. Center $\frac{1}{4}$ Sec. Cor.
2. North $\frac{1}{4}$ - $\frac{1}{4}$ s N. W. qr.,
3. East $\frac{1}{4}$ - $\frac{1}{4}$ s N. E. qr.,
4. South $\frac{1}{4}$ - $\frac{1}{4}$ s N. W. qr.,
5. West $\frac{1}{4}$ - $\frac{1}{4}$ s N. W. qr.,
6. Center $\frac{1}{4}$ - $\frac{1}{4}$ s N. W. qr.,
7. North $\frac{1}{4}$ - $\frac{1}{4}$ s N. E. qr.,
8. East $\frac{1}{4}$ - $\frac{1}{4}$ s N. E. qr.,
9. South $\frac{1}{4}$ - $\frac{1}{4}$ s N. E. qr.,
10. Center $\frac{1}{4}$ - $\frac{1}{4}$ s N. E. qr.,
11. East $\frac{1}{4}$ - $\frac{1}{4}$ s S. E. qr.,
12. South $\frac{1}{4}$ - $\frac{1}{4}$ s S. E. qr.,
13. West $\frac{1}{4}$ - $\frac{1}{4}$ s S. E. qr.,
14. Center $\frac{1}{4}$ - $\frac{1}{4}$ s S. E. qr.,
15. South $\frac{1}{4}$ - $\frac{1}{4}$ s S. W. qr.,
16. West $\frac{1}{4}$ - $\frac{1}{4}$ s S. W. qr.,
17. Center $\frac{1}{4}$ - $\frac{1}{4}$ s S. W. qr.


Beginning at an iron stake on the south line of the cement on Highway 14. Being about 646 feet North Easterly of the point of intersection of the South line of the said cement with the west line of the ~~South~~ said quarter section and being also 81.5 feet North Westerly of the north west corner of the Brick house now standing on the lot being described. Thence South Easterly being at right angles with the center line of the said road 406 feet to an iron stake. Thence North Easterly being parallel with the centerline of the said Road 1142 feet to the center of Honey Creek. Thence North westerly being along the center line of the said creek to the center line of the cement in the said highway 14. Thence South westerly being along the centerline of the said Cement 961 feet to a point North westerly of (measuring at right angles to the said center line) the place of beginning. Thence South Easterly 9 feet to the place of beginning.

Wm Child, County Surveyor

Recorded March 2, 1933 by
Lloyd S. Jensen, County Surveyor

AXMEN

No. 38

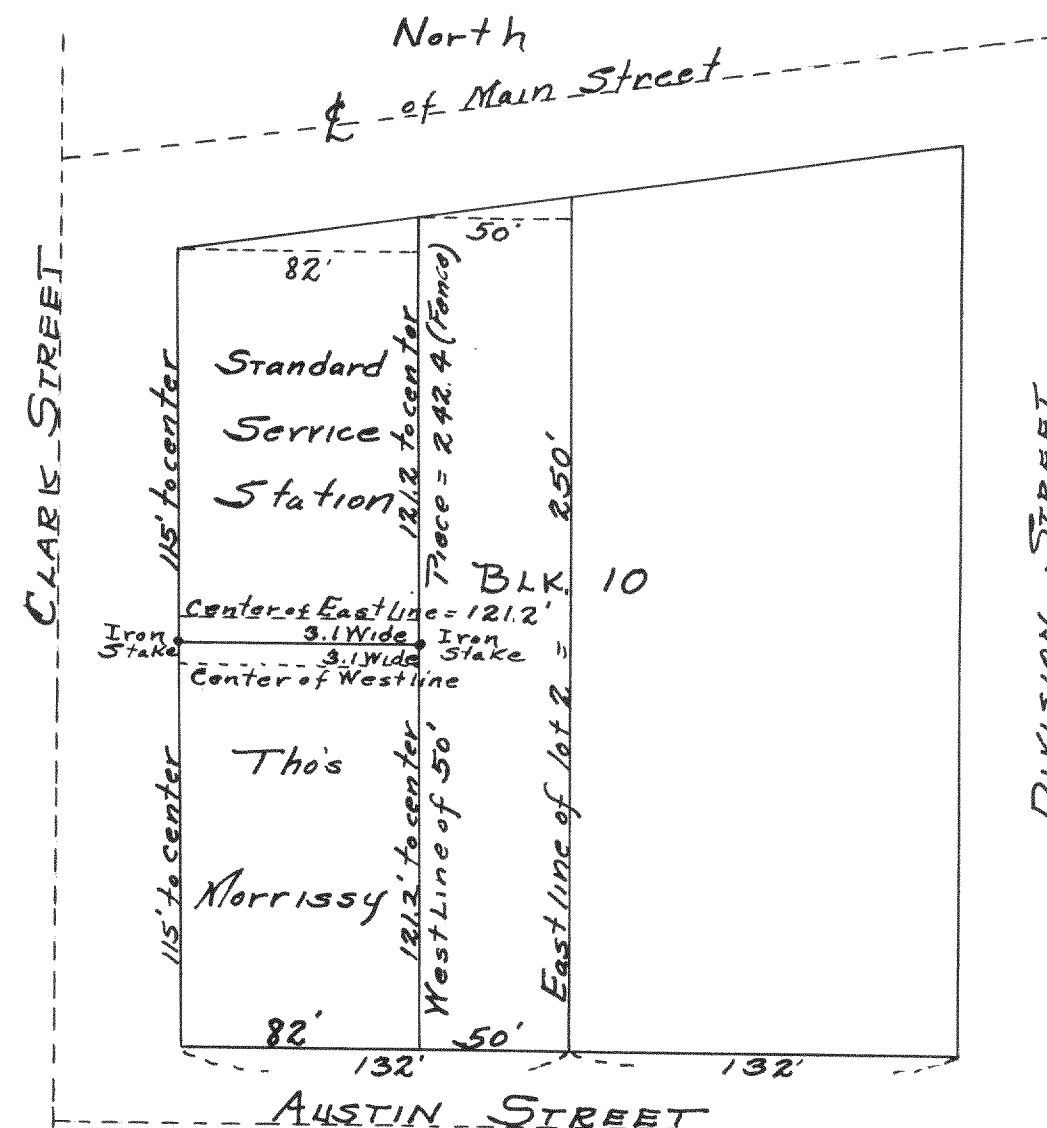


Plot of a Survey made for Thos. Morrissey of East Troy, to divide the West 82 feet of lot 2, of Block No. 10, of the village of East Troy, Walworth County, Wisconsin, in two equal parts, by a line running East and West thru the same, as shown on the Plot.

East Troy Nov. 12th 1932
Wm Child

County Surveyor

Recorded March 2, 1933 by
Lloyd S. Jensen
County Surveyor.

No. 39

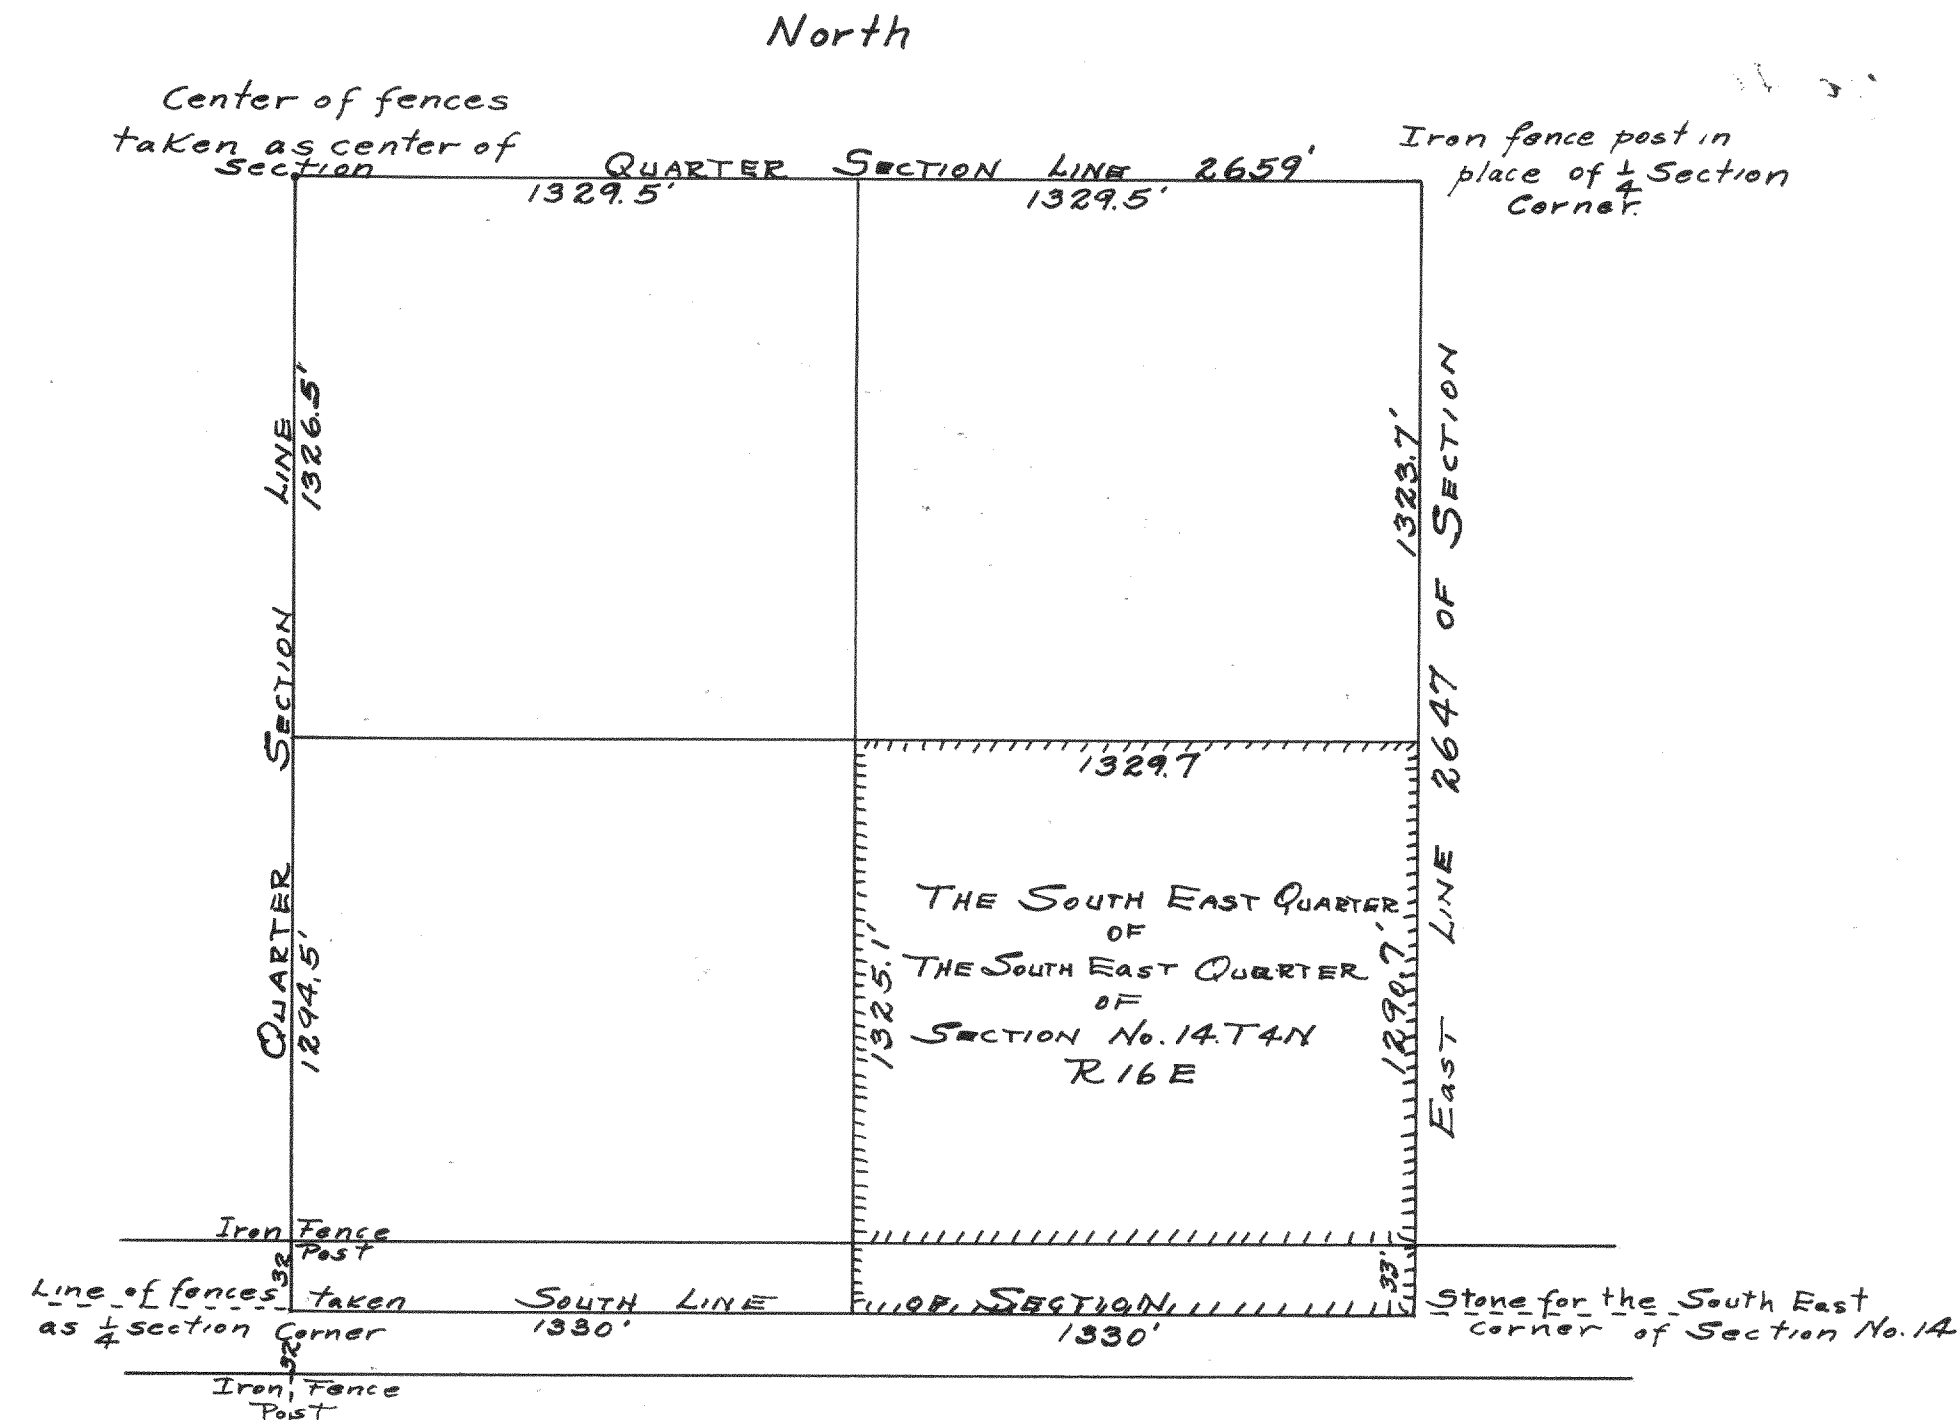

Plot of a survey made for O.C. Haughton on the South East Quarter of section No. 14. Township 4 North Range 16 East being the Town of La Grange, Walworth County, Wisconsin.

Survey made May 10th 1928
Wm Child
County Surveyor

Recorded March 2, 1933 by
Lloyd S. Jensen
County Surveyor