


Record of Survey.

DESCRIPTION

no 537

1-1-16

Township....., North of Range..... of 4 Principal Meridian
as presented by the courses and distances on the following plat, and annexed field-notes of survey:
Established the center of the section at the point of intersection of STRAIGHT quarter lines.
Established all quarter-quarter corners upon the section boundary at proportional distances between known section and quarter section corners, according to the original field-notes of the Government survey.
Established all lost corners at proportionate distances between known corners, according to the original field notes of the Government survey.

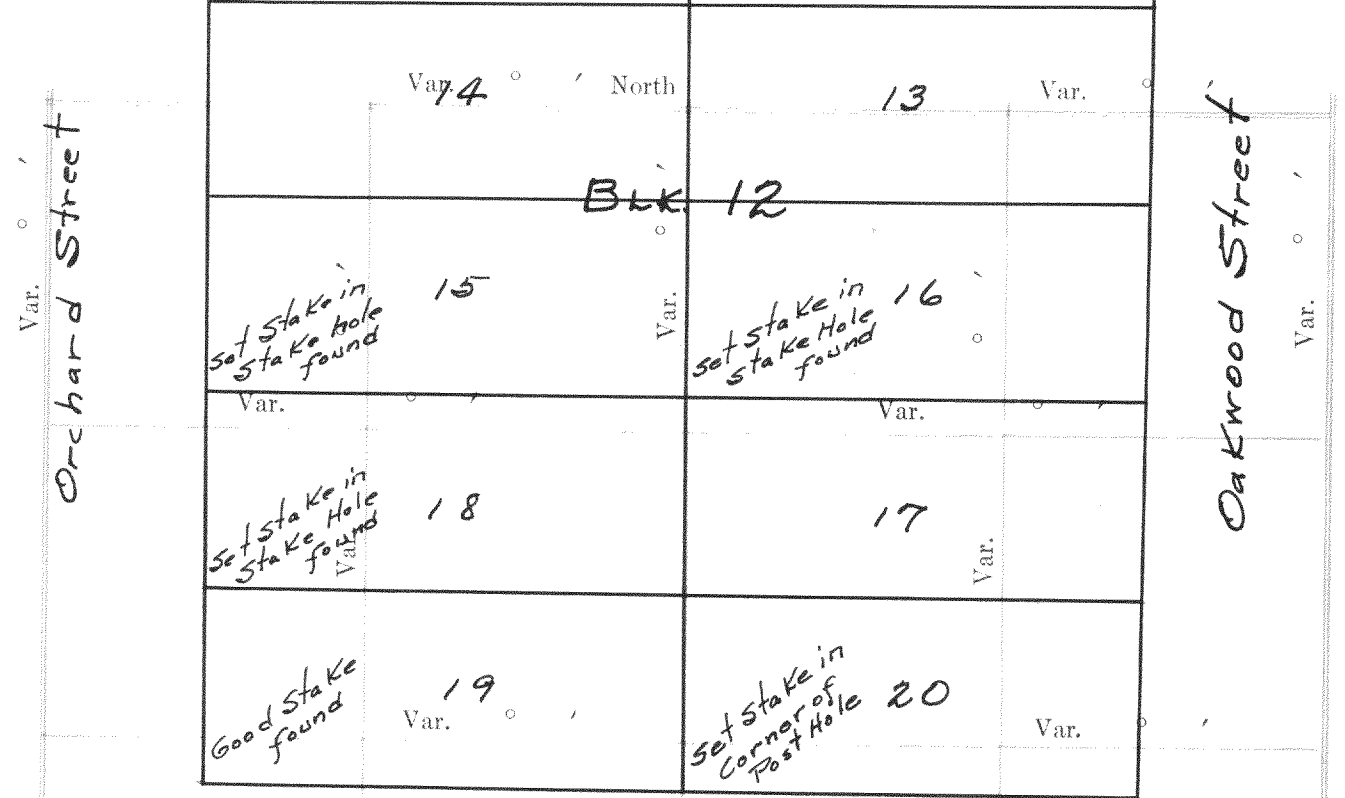

Plat of survey of part of Block 12 of
Williams second Addition to The Village of
Williams Bay.

Surveyed by Wm Child

Plat of Section....., Township....., North Range..... of 4 Principal Meridian Scale
80 chains to 6 inches. The figures in red ink are the lengths of the lines as stated in the field-notes of the
Government survey.
Recorded by Lloyd S. Jensen
April 21, 1934

Declination of the Magnetic Meridian from the True Meridian.....
Surveyed and sub-divided..... A. D. 1....., in accordance
with the State Laws and Instructions of the Commissioner of the General Land office, and recorded on pages
..... of Register in the County Clerk's office.

Witness my hand this..... day of..... A. D. 1.....

SURVEYOR.

OF SECTION, QUARTER SECTION AND QUARTER QUARTER SECTION CORNERS

GOVERNMENT CORNERS				N. C. MILLER CO. MFG. STATIONERS. MILWAUKEE WISCONSIN				
No.	Bearing Trees	In. Dia.	Courses they bear	Links Distant	Bearing Trees	In. Dia.	Courses they bear	Links Distant
1. N. W. Sec. Cor. identified,								
2. N. E. Sec. Cor. identified,								
3. S. E. Sec. Cor. identified,								
4. S. W. Sec. Cor. identified,								
5. N. 1/4 Sec. Cor. identified,								
6. E. 1/4 Sec. Cor. identified,								
7. S. 1/4 Sec. Cor. identified,								
8. W. 1/4 Sec. Cor. identified,								
Subdivision Corners								
No.								
1. Center 1/4 Sec. Cor.								
2. North 1/4-1/4s N. W. qr.,								
3. East 1/4-1/4s N. W. qr.,								
4. South 1/4-1/4s N. W. qr.,								
5. West 1/4-1/4s N. W. qr.,								
6. Center 1/4-1/4s N. W. qr.,								
7. North 1/4-1/4s N. E. qr.,								
8. East 1/4-1/4s N. E. qr.,								
9. South 1/4-1/4s N. E. qr.,								
10. Center 1/4-1/4s N. E. qr.,								
11. East 1/4-1/4s S. E. qr.,								
12. South 1/4-1/4s S. E. qr.,								
13. West 1/4-1/4s S. E. qr.,								
14. Center 1/4-1/4s S. E. qr.,								
15. South 1/4-1/4s S. W. qr.,								
16. West 1/4-1/4s S. W. qr.,								
17. Center 1/4-1/4s S. W. qr.,								

No. 538

ELKHORN

stake

Iron stake

20

82'-6"

19.5

Fence

9

Fence

8

7

63

66

95.5

412.4

82'-8"

20

628.7


END OF WALK

Randal Place or The Avenue

Plot of a survey in Block 1 of Dodge's Add.
to The City of Elkhorn.

Surveyed by Wm Child
CS

Recorded by Lloyd S. Jensen
CS
April 21, 1934

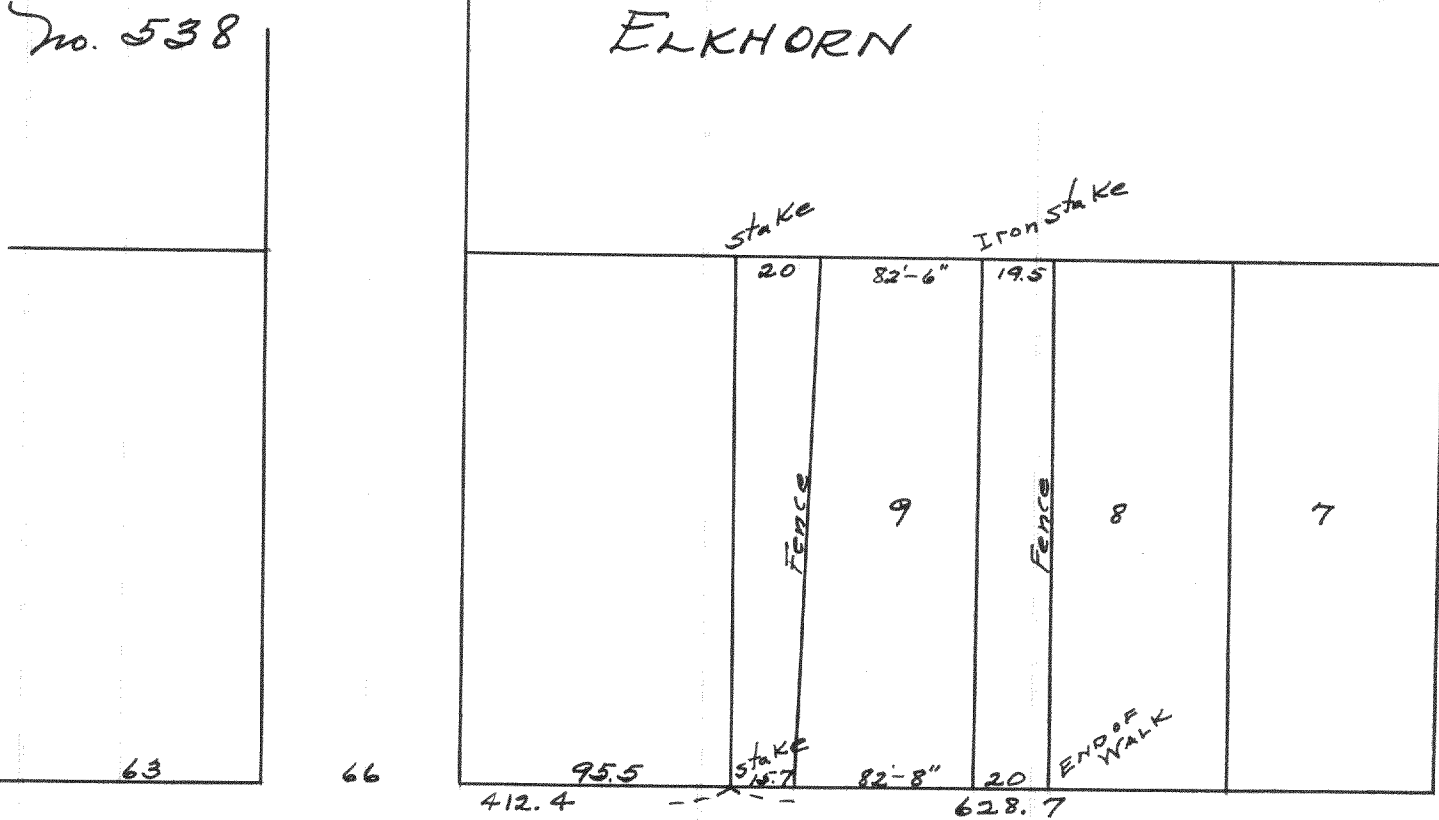

Plat of a survey in Block 1 of Dodge's Add.
to The City of Elkhorn.
Surveyed by Wm Child
Recorded by Lloyd S. Jensen
April 21, 1934



NAMES OF SWORN ASSISTANTS

FLAGMEN AXMEN



178 No 539

1-1-16

WILLIAMS BAY

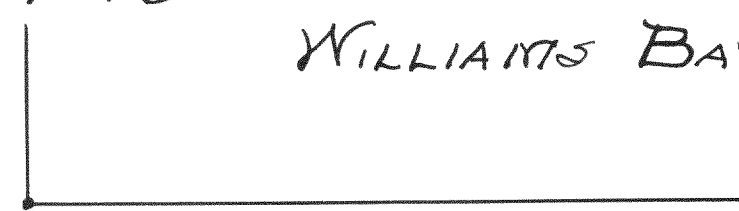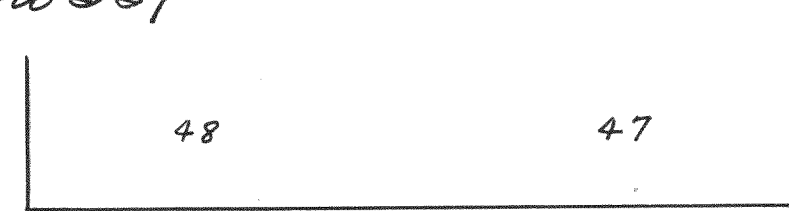

Hickory Str.

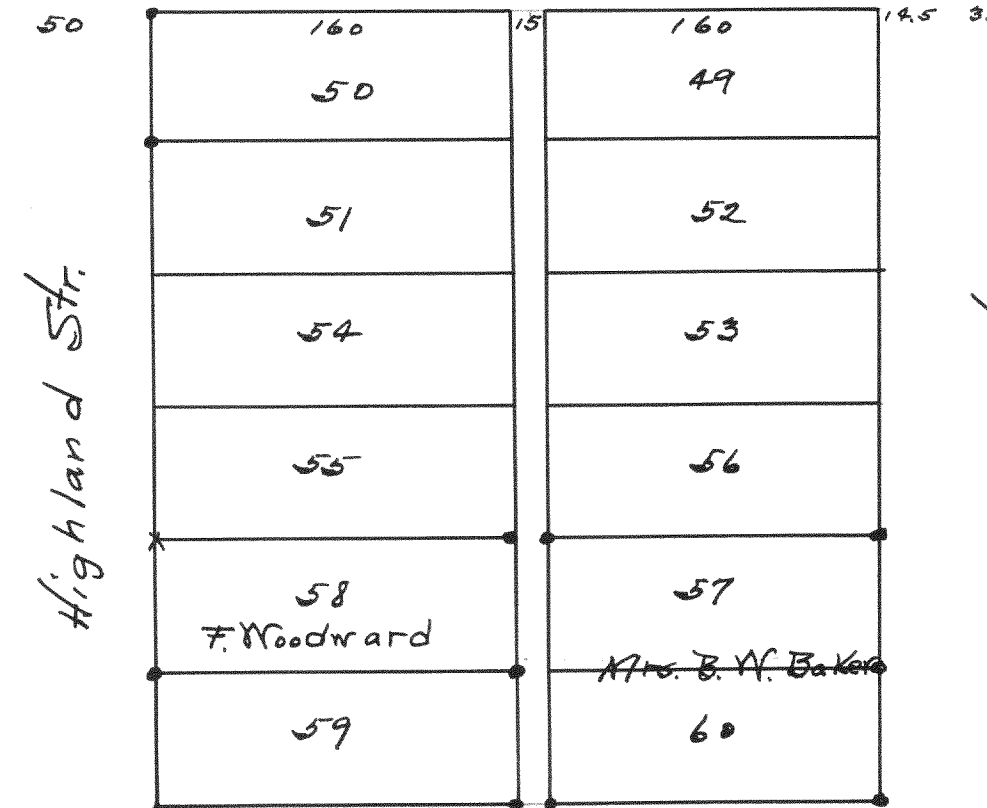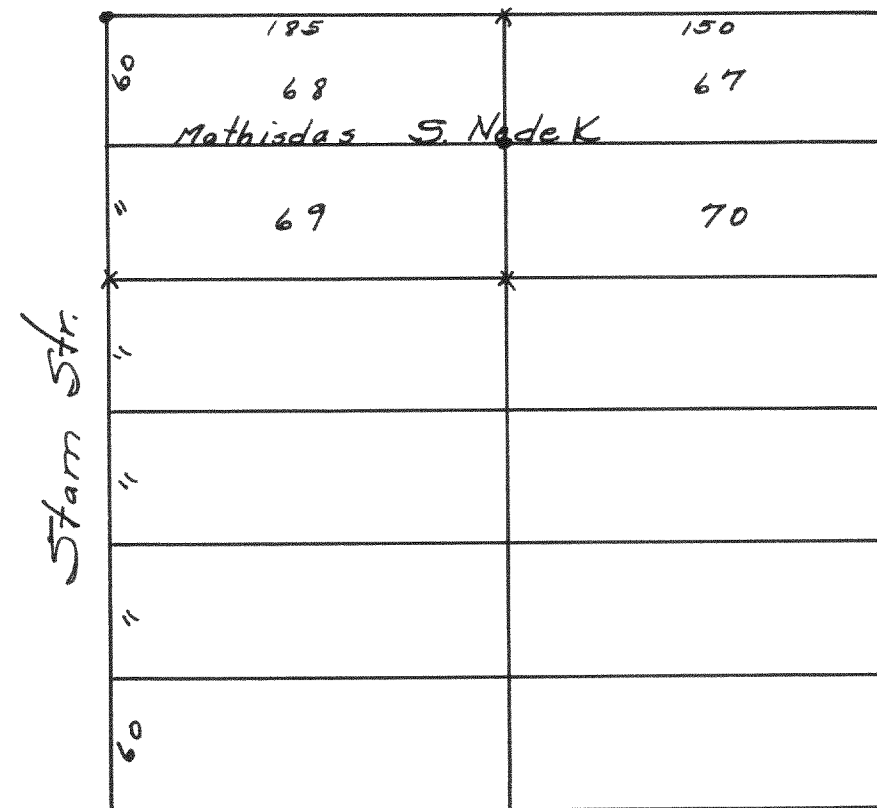

Highland Str.

Collie Str.

Stake holes found - •
Stakes set - x

Plot of a survey in Bay View Subdivision,
located in the Village of Williams Bay.

Surveyed by Wm Child
C.S.

Recorded by Lloyd S. Jensen
C.S.
April 23, 1934