


Record of Survey.

DESCRIPTION

No. 544

Township....., North of Range.....9-4-18.....of 4 Principal Meridian
as presented by the courses and distances on the following plat, and annexed field-notes of survey:
Established the center of the section at the point of intersection of STRAIGHT quarter lines.
Established all quarter-quarter corners upon the section boundary at proportional distances between known section and quarter section corners, according to the original field-notes of the Government survey.
Established all lost corners at proportionate distances between known corners, according to the original field notes of the Government survey.

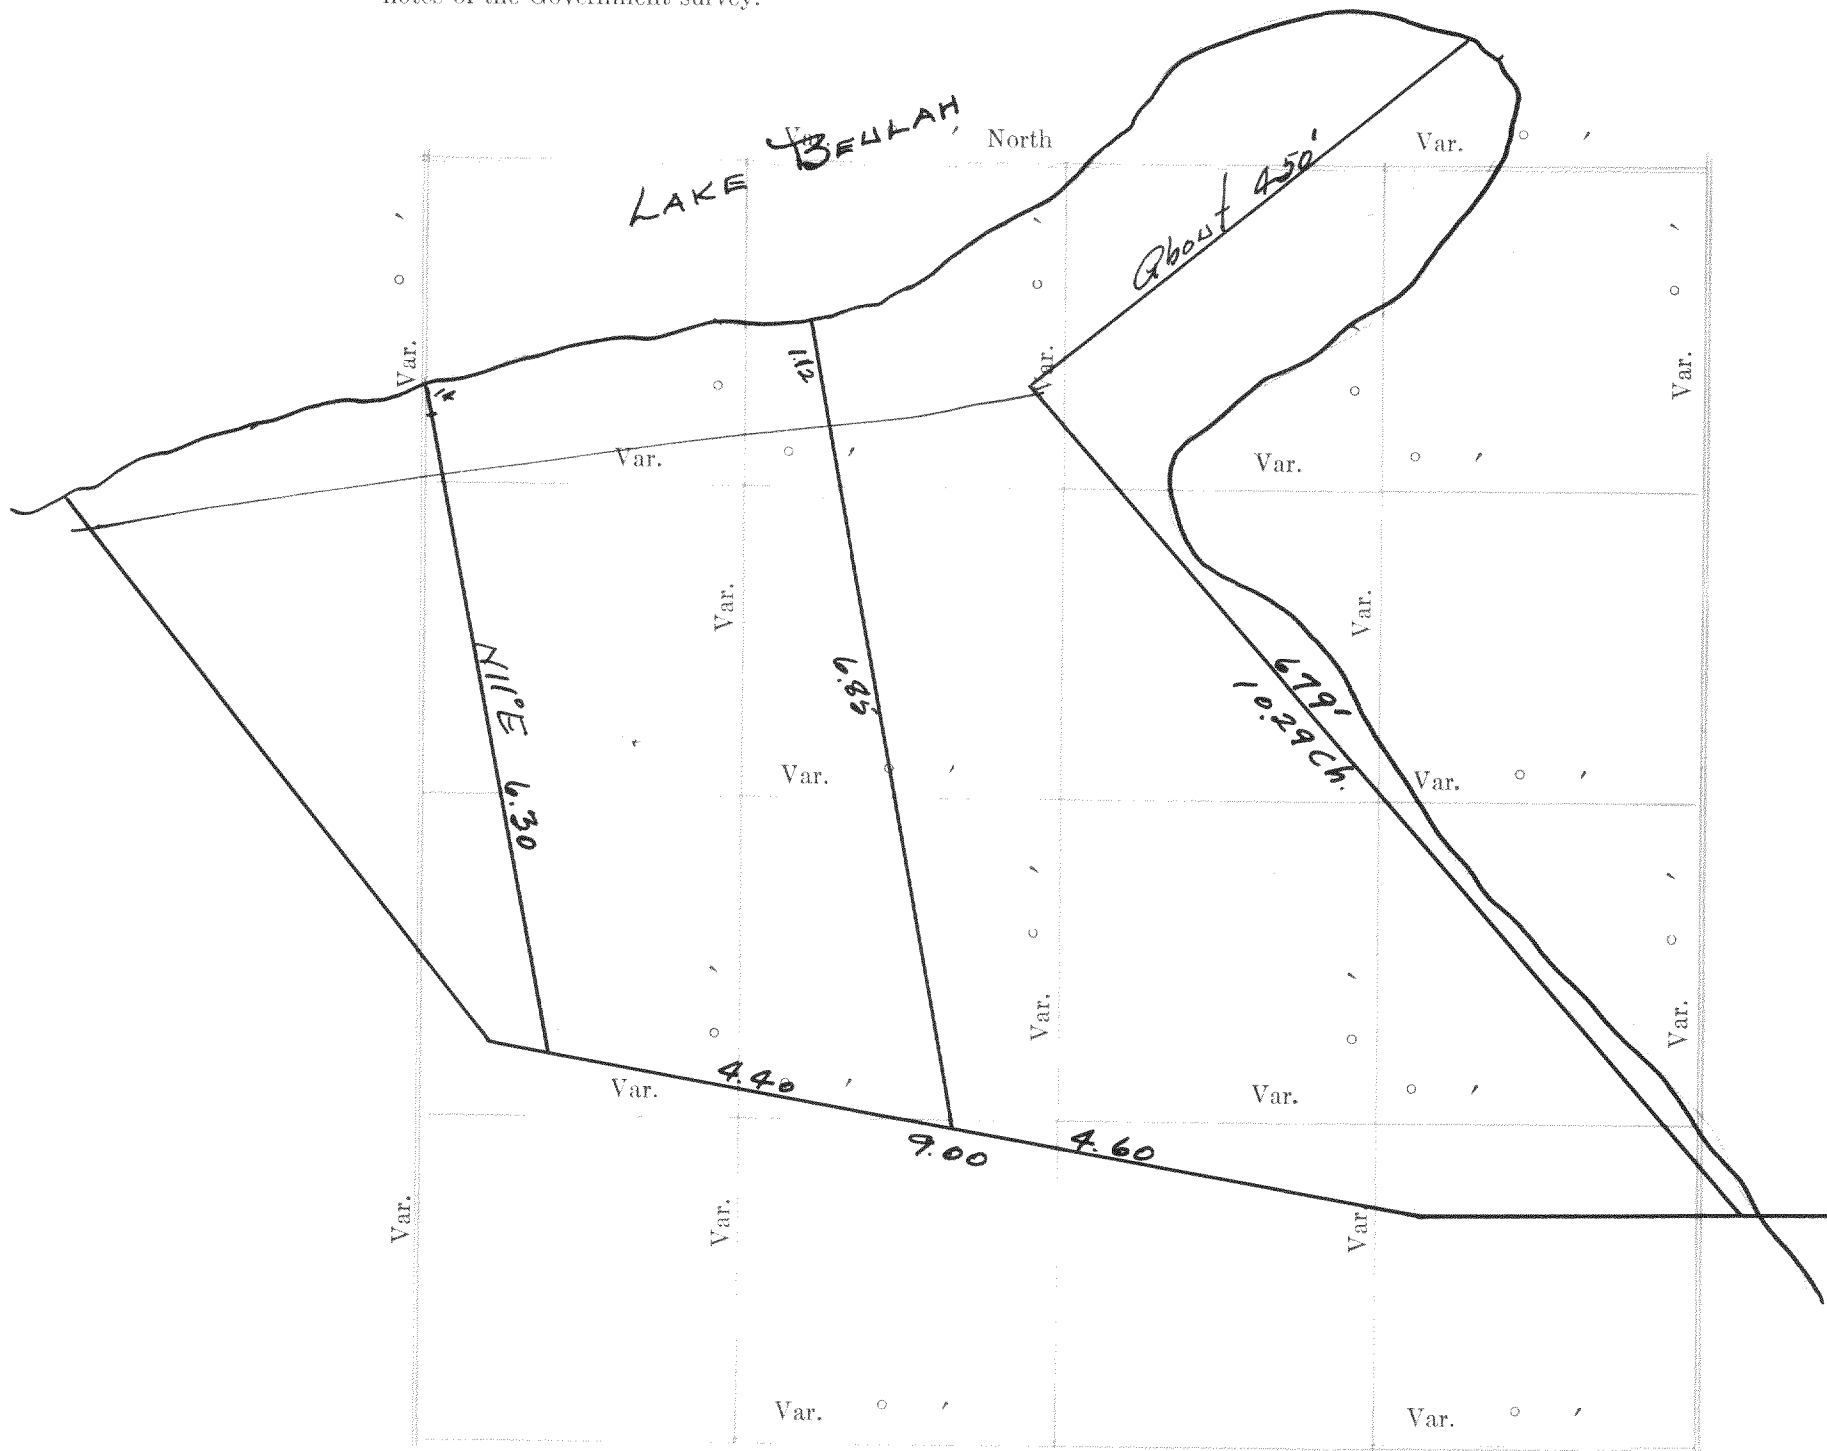

Plat of Section....., Township.....North, Range.....of 4 Principal Meridian Scale
80 chains to 6 inches. The figures in red ink are the lengths of the lines as stated in the field-notes of the
Government survey.

Declination of the Magnetic Meridian from the True Meridian.....
Surveyed and sub-divided.....A. D. 1....., in accordance
with the State Laws and Instructions of the Commissioner of the General Land office, and recorded on pages
.....of Register in the County Clerk's office.

Witness my hand this.....day of.....A. D. 1

.....SURVEYOR.

OF SECTION, QUARTER SECTION AND QUARTER QUARTER SECTION CORNERS

GOVERNMENT CORNERS				N. C. MILLER CO. MFG. STATIONERS, MILWAUKEE X15000															
No.	Bearing	In.	Courses	Links	Bearing	In.	Courses	Links	Bearing	In.	Courses	Links	Bearing	In.	Courses	Links	Bearing	In.	Courses
1.	N. W. Sec. Cor. identified,																		
2.	N. E. Sec. Cor. identified,																		
3.	S. E. Sec. Cor. identified,																		
4.	S. W. Sec. Cor. identified,																		
5.	N. ¼ Sec. Cor. identified,																		
6.	E. ¼ Sec. Cor. identified,																		
7.	S. ¼ Sec. Cor. identified,																		
8.	W. ¼ Sec. Cor. identified,																		
Subdivision Corners																			
No.																			
1.	Center ¼ Sec. Cor.																		
2.	North ¼-¼s N. W. qr.,																		
3.	East ¼-¼s N. W. qr.,																		
4.	South ¼-¼s N. W. qr.,																		
5.	West ¼-¼s N. W. qr.,																		
6.	Center ¼-¼s N. W. qr.,																		
7.	North ¼-¼s N. E. qr.,																		
8.	East ¼-¼s N. E. qr.,																		
9.	South ¼-¼s N. E. qr.,																		
10.	Center ¼-¼s N. E. qr.,																		
11.	East ¼-¼s S. E. qr.,																		
12.	South ¼-¼s S. E. qr.,																		
13.	West ¼-¼s S. E. qr.,																		
14.	Center ¼-¼s S. E. qr.,																		
15.	South ¼-¼s S. W. qr.,																		
16.	West ¼-¼s S. W. qr.,																		
17.	Center ¼-¼s S. W. qr.																		

Description from survey -
Beginning at a stake at the Southeast corner
of lands heretofore sold, said point being
N 80° W 9 ch. from the ½ sec. post on the South side
of the NE ¼ of Section 9, T4N. R18E, thence
N 11° W along Mitchell's East line 6.30 ch. to a
stake (Set by W.O. Lee N 60° W 3 ½ ch.), thence
on the same course 14 chs. to the shore of Lake
Bellah; thence Easterly along the shore to a pt.;
thence S 11° E 1.12 chains to a stake which is
S 87° E 4.24 chains from the stake last above
mentioned; thence on the same course 6.85 ch.
to a stake which is N 80° W 4.60 chains from
the aforesaid ½ post; thence N 80° W 4.40 ch. to
the place of beginning, containing 2.85 Acres
more or less.

Surveyed by Wm Child
CS.
Recorded by Lloyd L. Jensen
CS.
May 3, 1934


NAMES OF SWORN ASSISTANTS

CHAINMEN FLAGMEN AXMEN

181 No. 545

DELAWARE CITY

18-2-16

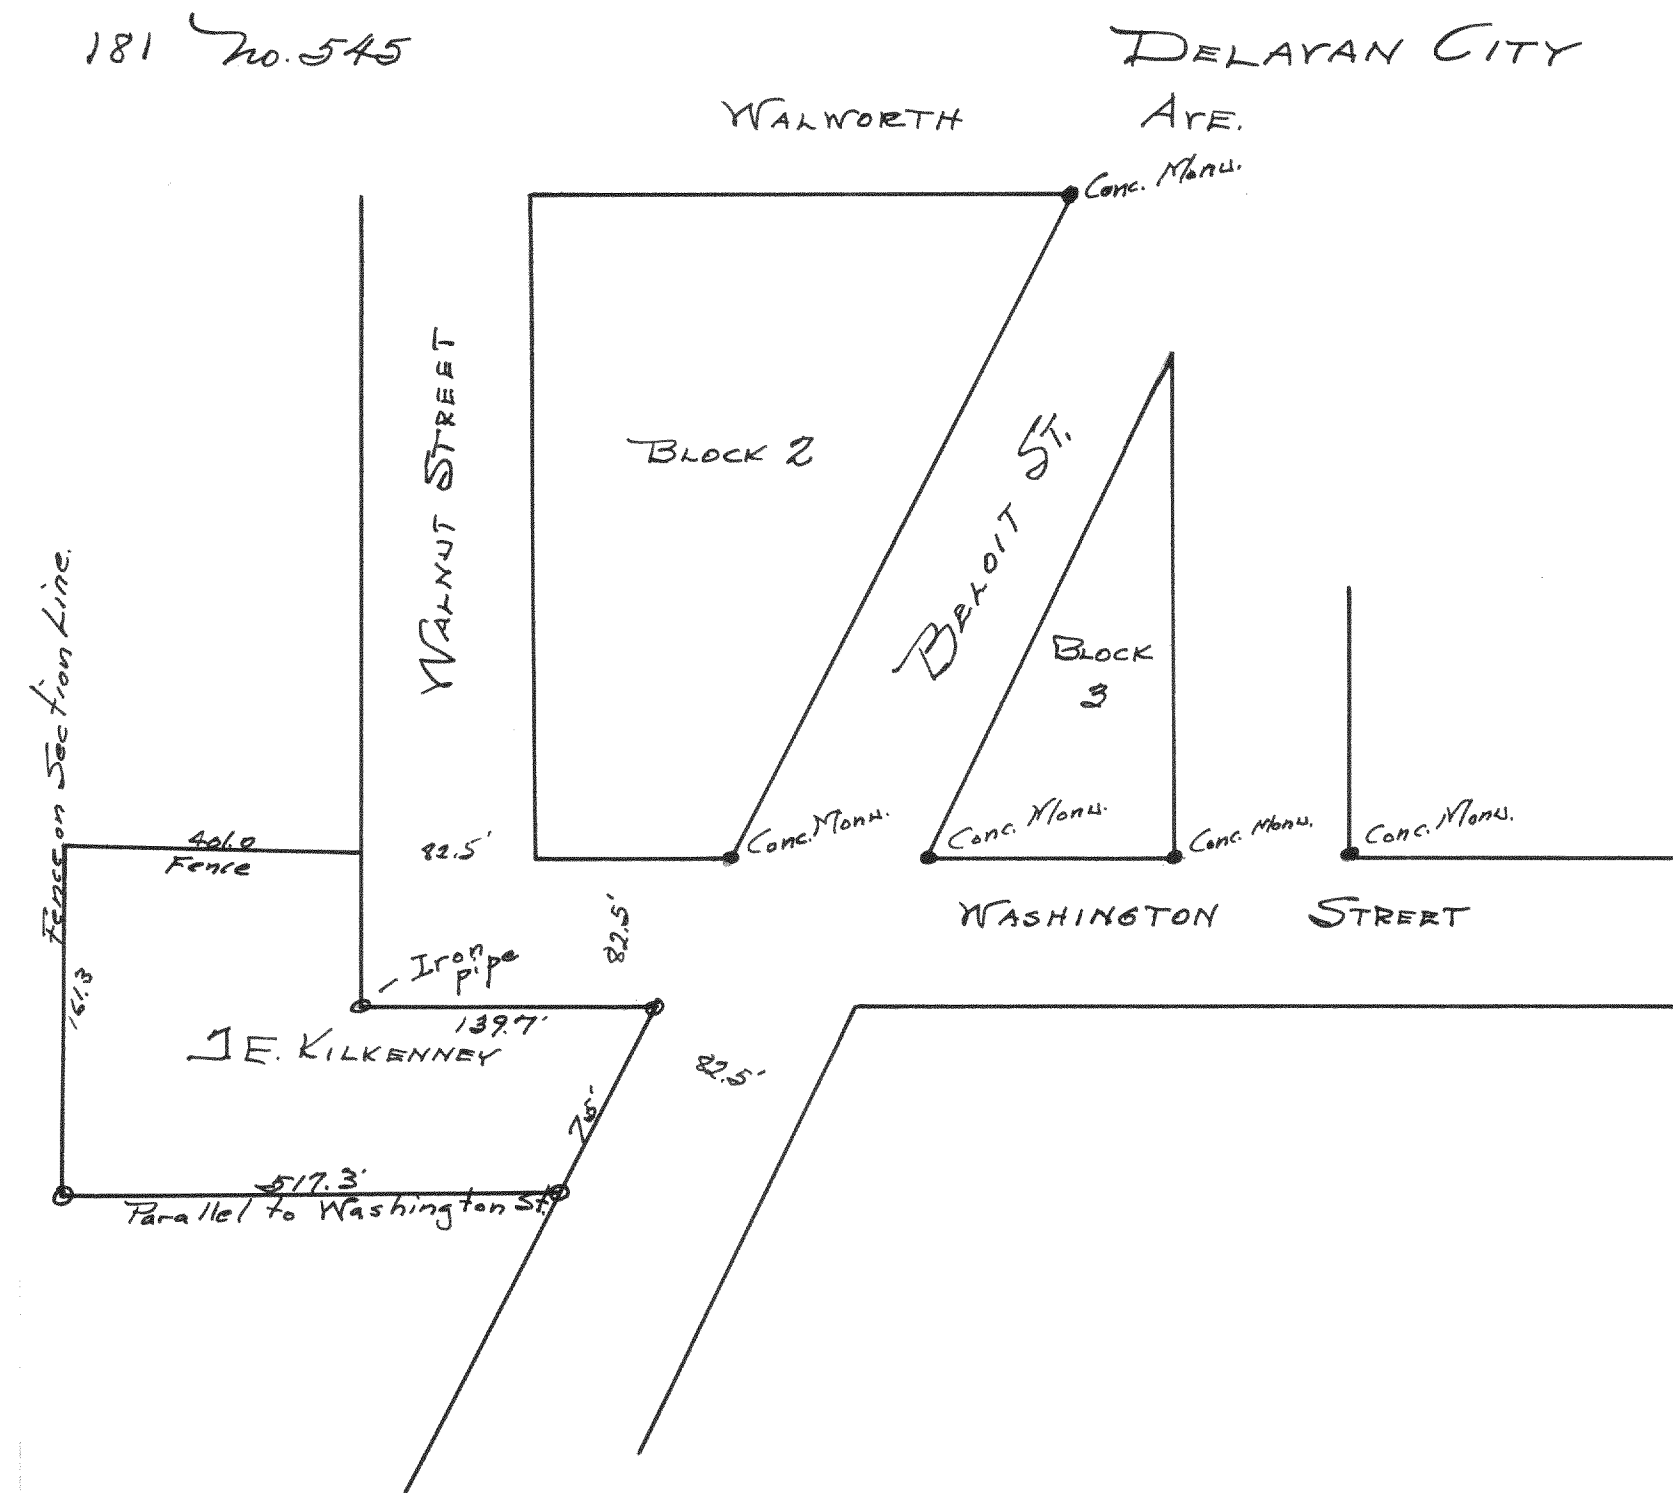

Plat of a survey in the Southwest $\frac{1}{4}$ of Section 18, T2N, R16E for J.E. Kilkenny of Delaware. Concrete monuments were located as noted on the drawing. Iron pipes (o) were driven at the corners of the plot surveyed as shown. The fences on the West and north were used as the line.

Surveyed by Lloyd S. Jensen
May 2, 1934