

No 546


Record of Survey.
26-7-16

DESCRIPTION

182


OF SECTION, QUARTER SECTION AND QUARTER QUARTER SECTION CORNERS

Township....., North of Range..... of 4 Principal Meridian
as presented by the courses and distances on the following plat, and annexed field-notes of survey:
Established the center of the section at the point of intersection of STRAIGHT quarter lines.
Established all quarter-quarter corners upon the section boundary at proportional distances between known section and quarter section corners, according to the original field-notes of the Government survey.
Established all lost corners at proportionate distances between known corners, according to the original field notes of the Government survey.

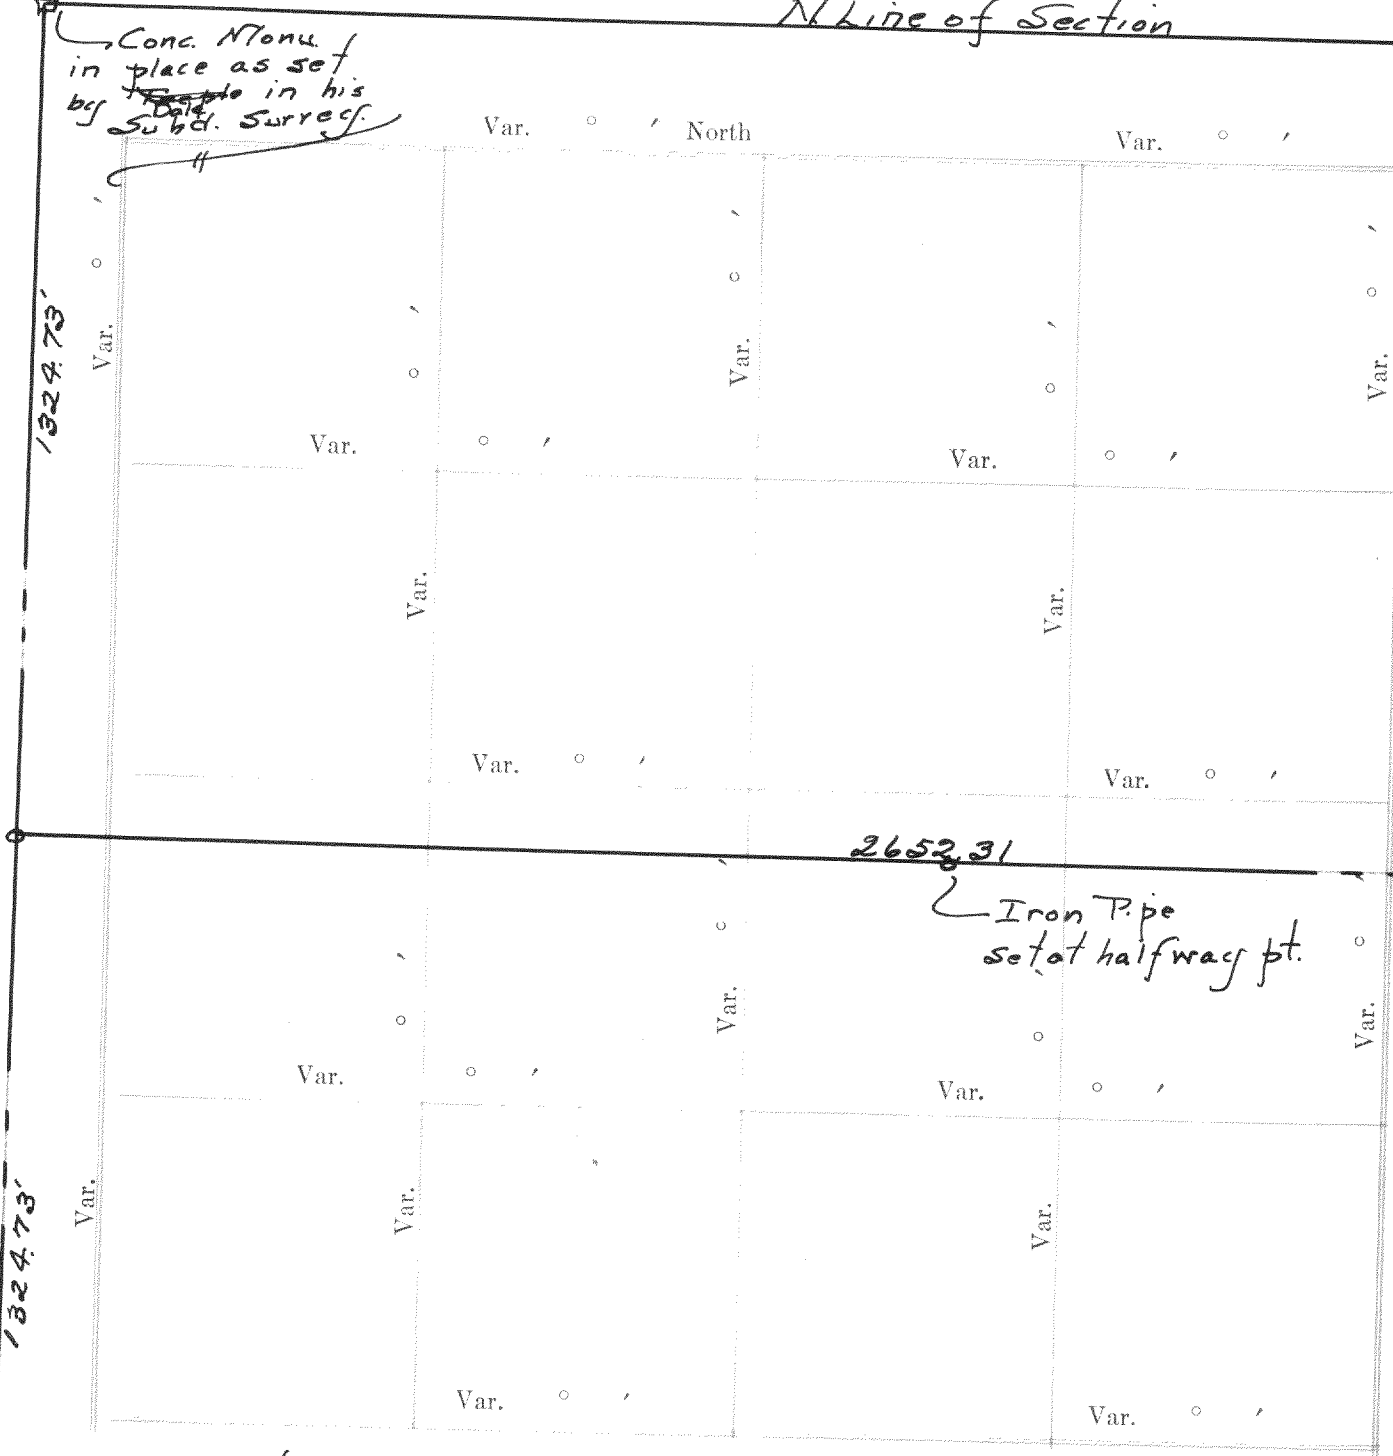

Plat of Section....., Township..... North, Range..... of 4 Principal Meridian Scale
80 chains to 6 inches. The figures in red ink are the lengths of the lines as stated in the field-notes of the Government survey.
Middle of fences have been in place 20 years.
Corner of the magnetic Meridian from the True Meridian.
Surveyed and sub-divided..... A. D. 1..... in accordance
with the State Laws and Instructions of the Commissioner of the General Land office, and recorded on pages
..... of Register in the County Clerk's office.
Witness my hand this..... day of..... A. D. 1.....

- GOVERNMENT CORNERS
1. N. W. Sec. Cor. identified,
 2. N. E. Sec. Cor. identified,
 3. S. E. Sec. Cor. identified,
 4. S. W. Sec. Cor. identified,
 5. N. $\frac{1}{4}$ Sec. Cor. identified,
 6. E. $\frac{1}{4}$ Sec. Cor. identified,
 7. S. $\frac{1}{4}$ Sec. Cor. identified,
 8. W. $\frac{1}{4}$ Sec. Cor. identified,
- Subdivision Corners
1. Center $\frac{1}{4}$ Sec. Cor.
 2. North $\frac{1}{4}$ - $\frac{1}{4}$ s N. W. qr.,
 3. East $\frac{1}{4}$ - $\frac{1}{4}$ s N. W. qr.,
 4. South $\frac{1}{4}$ - $\frac{1}{4}$ s N. W. qr.,
 5. West $\frac{1}{4}$ - $\frac{1}{4}$ s N. W. qr.,
 6. Center $\frac{1}{4}$ - $\frac{1}{4}$ s N. W. qr.,
 7. North $\frac{1}{4}$ - $\frac{1}{4}$ s N. E. qr.,
 8. East $\frac{1}{4}$ - $\frac{1}{4}$ s N. E. qr.,
 9. South $\frac{1}{4}$ - $\frac{1}{4}$ s N. E. qr.,
 10. Center $\frac{1}{4}$ - $\frac{1}{4}$ s N. E. qr.,
 11. East $\frac{1}{4}$ - $\frac{1}{4}$ s S. E. qr.,
 12. South $\frac{1}{4}$ - $\frac{1}{4}$ s S. E. qr.,
 13. West $\frac{1}{4}$ - $\frac{1}{4}$ s S. E. qr.,
 14. Center $\frac{1}{4}$ - $\frac{1}{4}$ s S. E. qr.,
 15. South $\frac{1}{4}$ - $\frac{1}{4}$ s S. W. qr.,
 16. West $\frac{1}{4}$ - $\frac{1}{4}$ s S. W. qr.,
 17. Center $\frac{1}{4}$ - $\frac{1}{4}$ s S. W. qr.

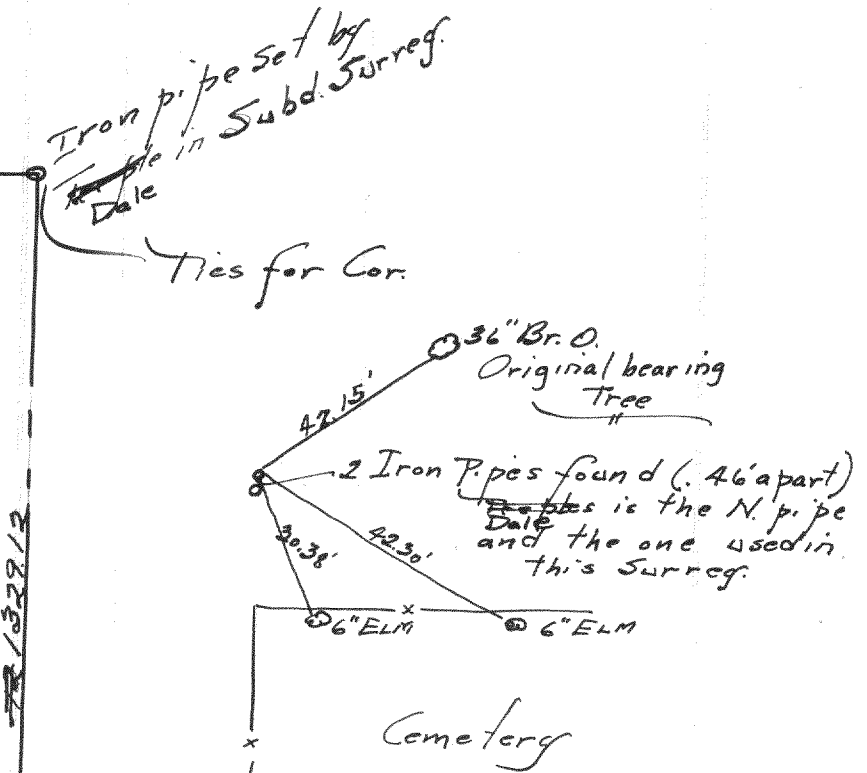


Plat of a survey of the NE $\frac{1}{4}$ of section 26, T2N, R16E to locate the Centerline East and West through the $\frac{1}{4}$. Iron stakes were placed or found at the points marked (o).

Surveyed by Lloyd S. Jensen
April 27 & 28 & May 1, 1934

CHAIMEN
Fences S & E & W. 4 remains of old fence to the North

AXMEN

DELAWARE CITY

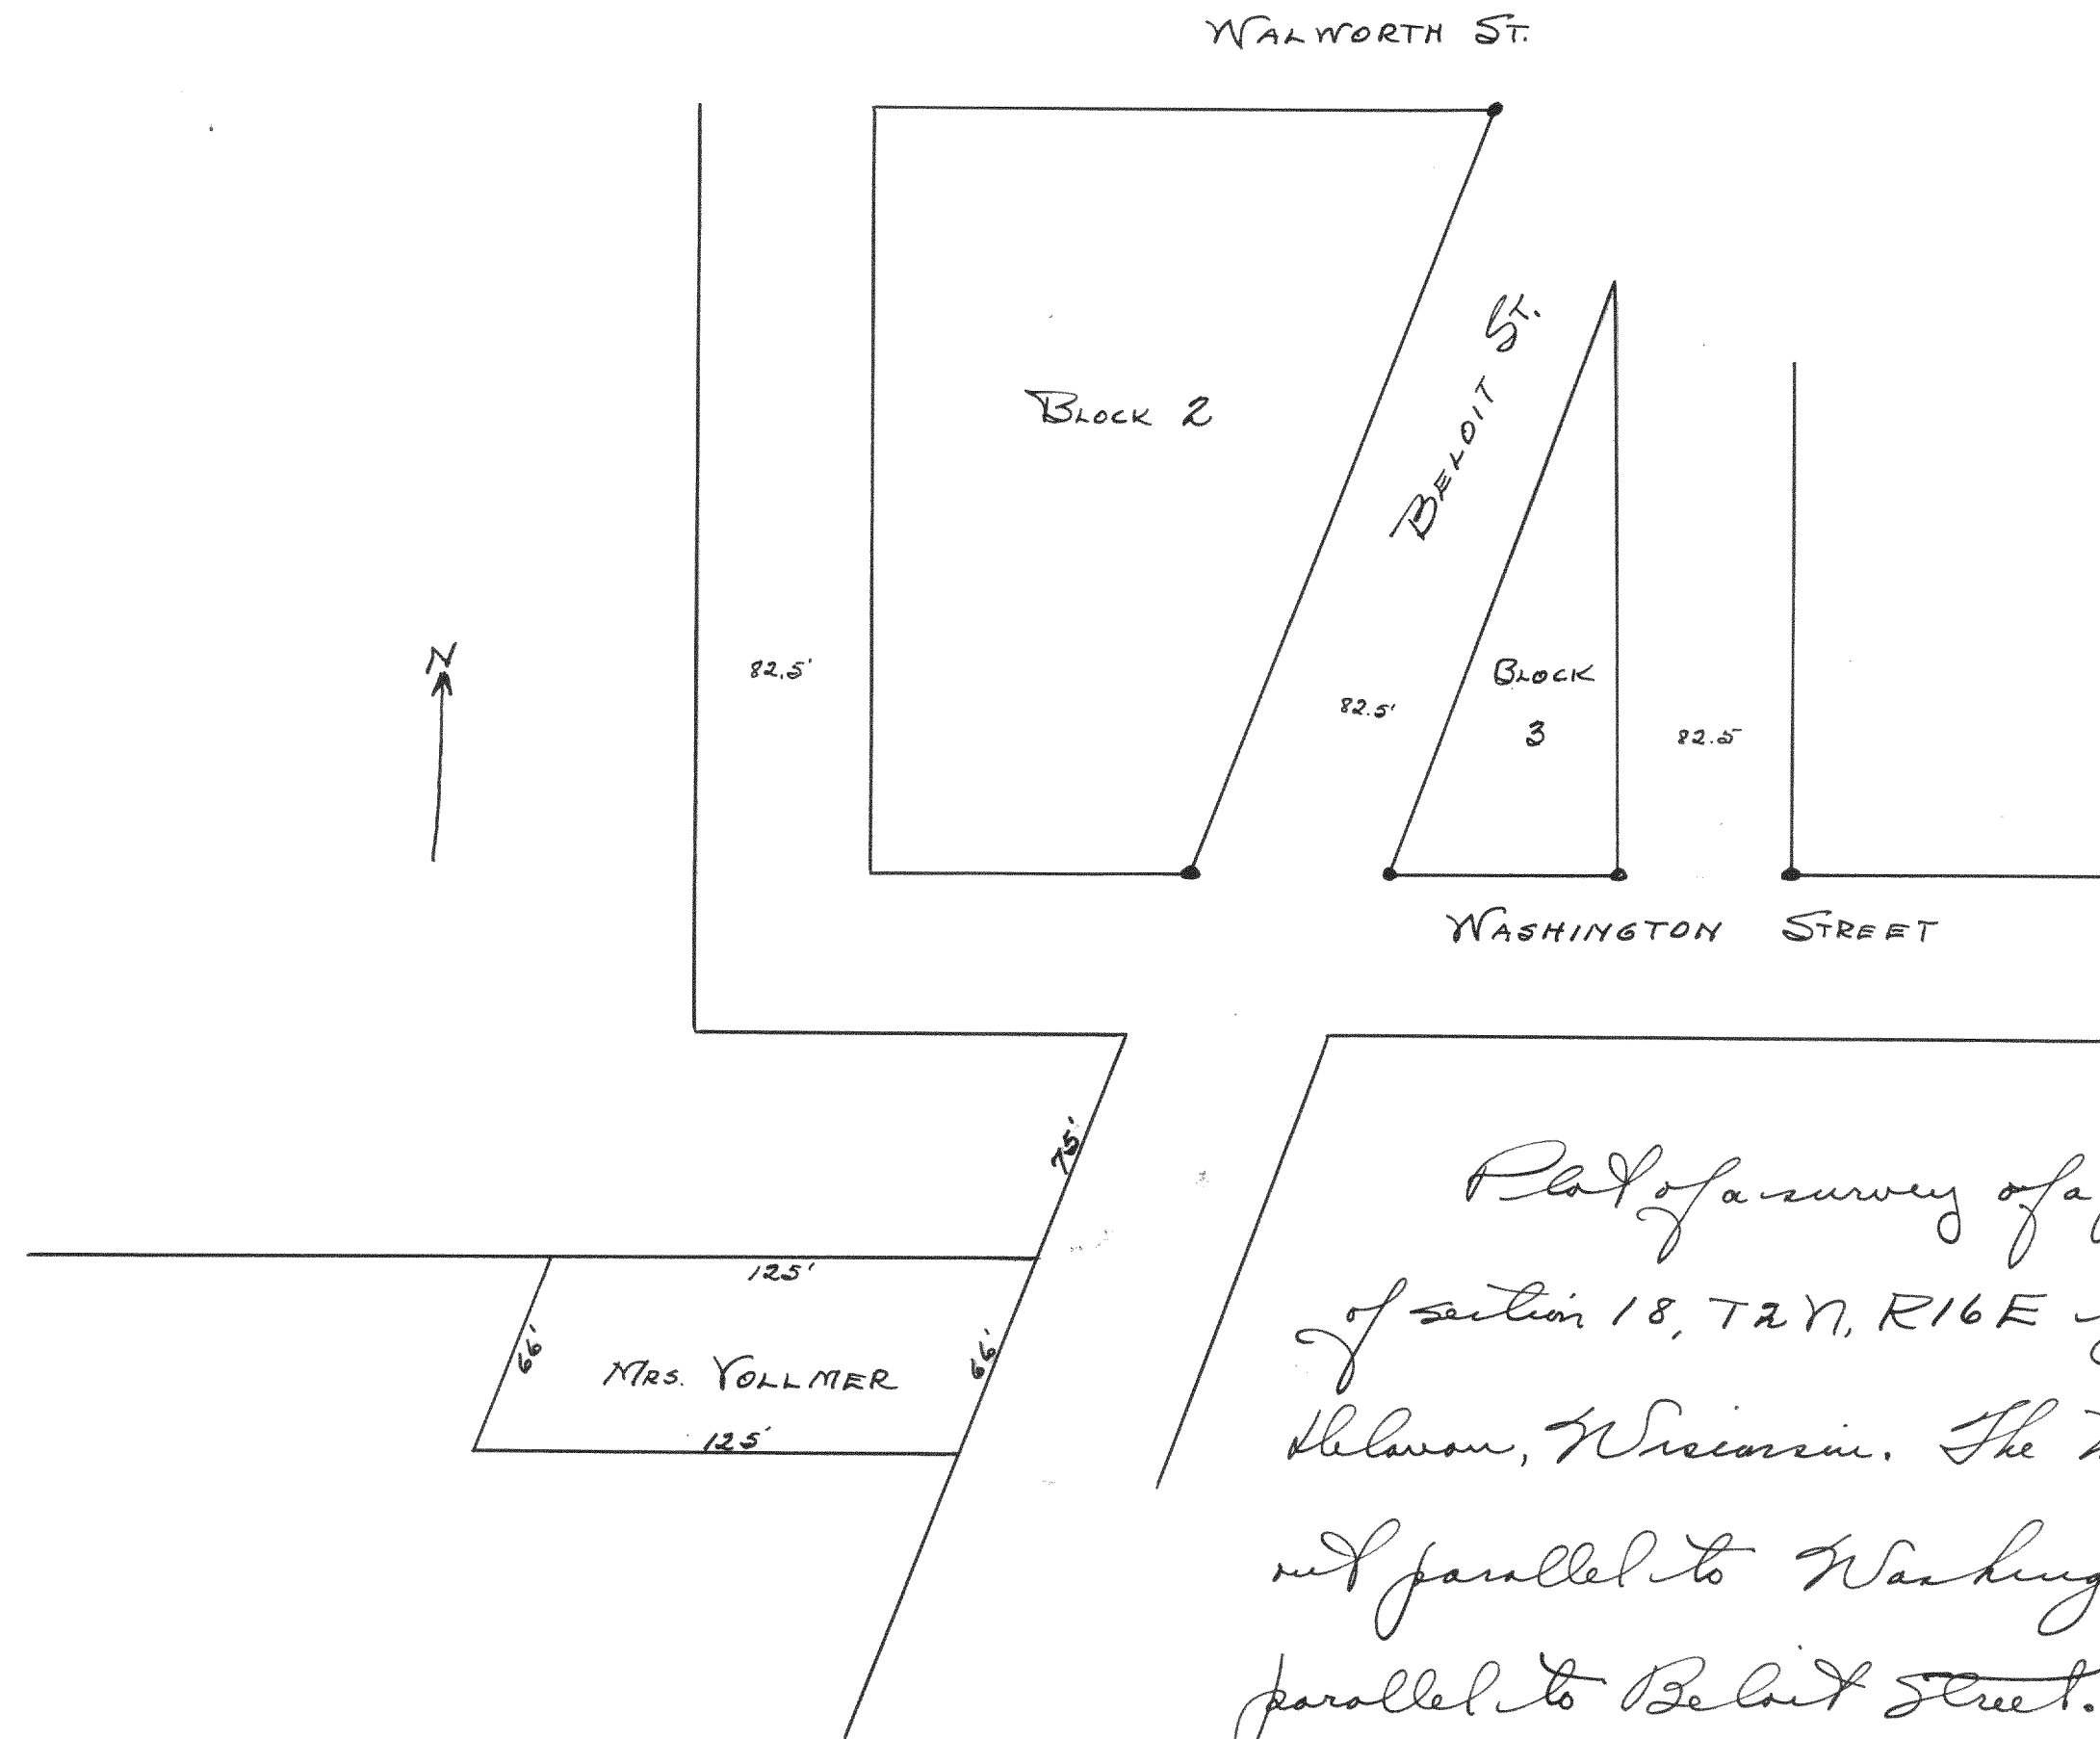

Plot of a survey of a parcel of land in The Southwest $\frac{1}{4}$ of section 18, T2N, R16E lying on Beloit Street in The City of Delaware, Wisconsin. The north and south lines were laid out parallel to Washington Street and the West line parallel to Beloit Street.

Surveyed by Floyd T. Jensen
May 3, 1924