


Record of Survey.

DESCRIPTION

OF SECTION, QUARTER SECTION AND QUARTER QUARTER SECTION CORNERS

No 548

Township....., North of Range..... of 4 Principal Meridian
as presented by the courses and distances on the following plat, and annexed field-notes of survey:
Established the center of the section at the point of intersection of STRAIGHT quarter lines.
Established all quarter-quarter corners upon the section boundary at proportional distances between known section and quarter section corners, according to the original field-notes of the Government survey.
Established all lost corners at proportionate distances between known corners, according to the original field notes of the Government survey.

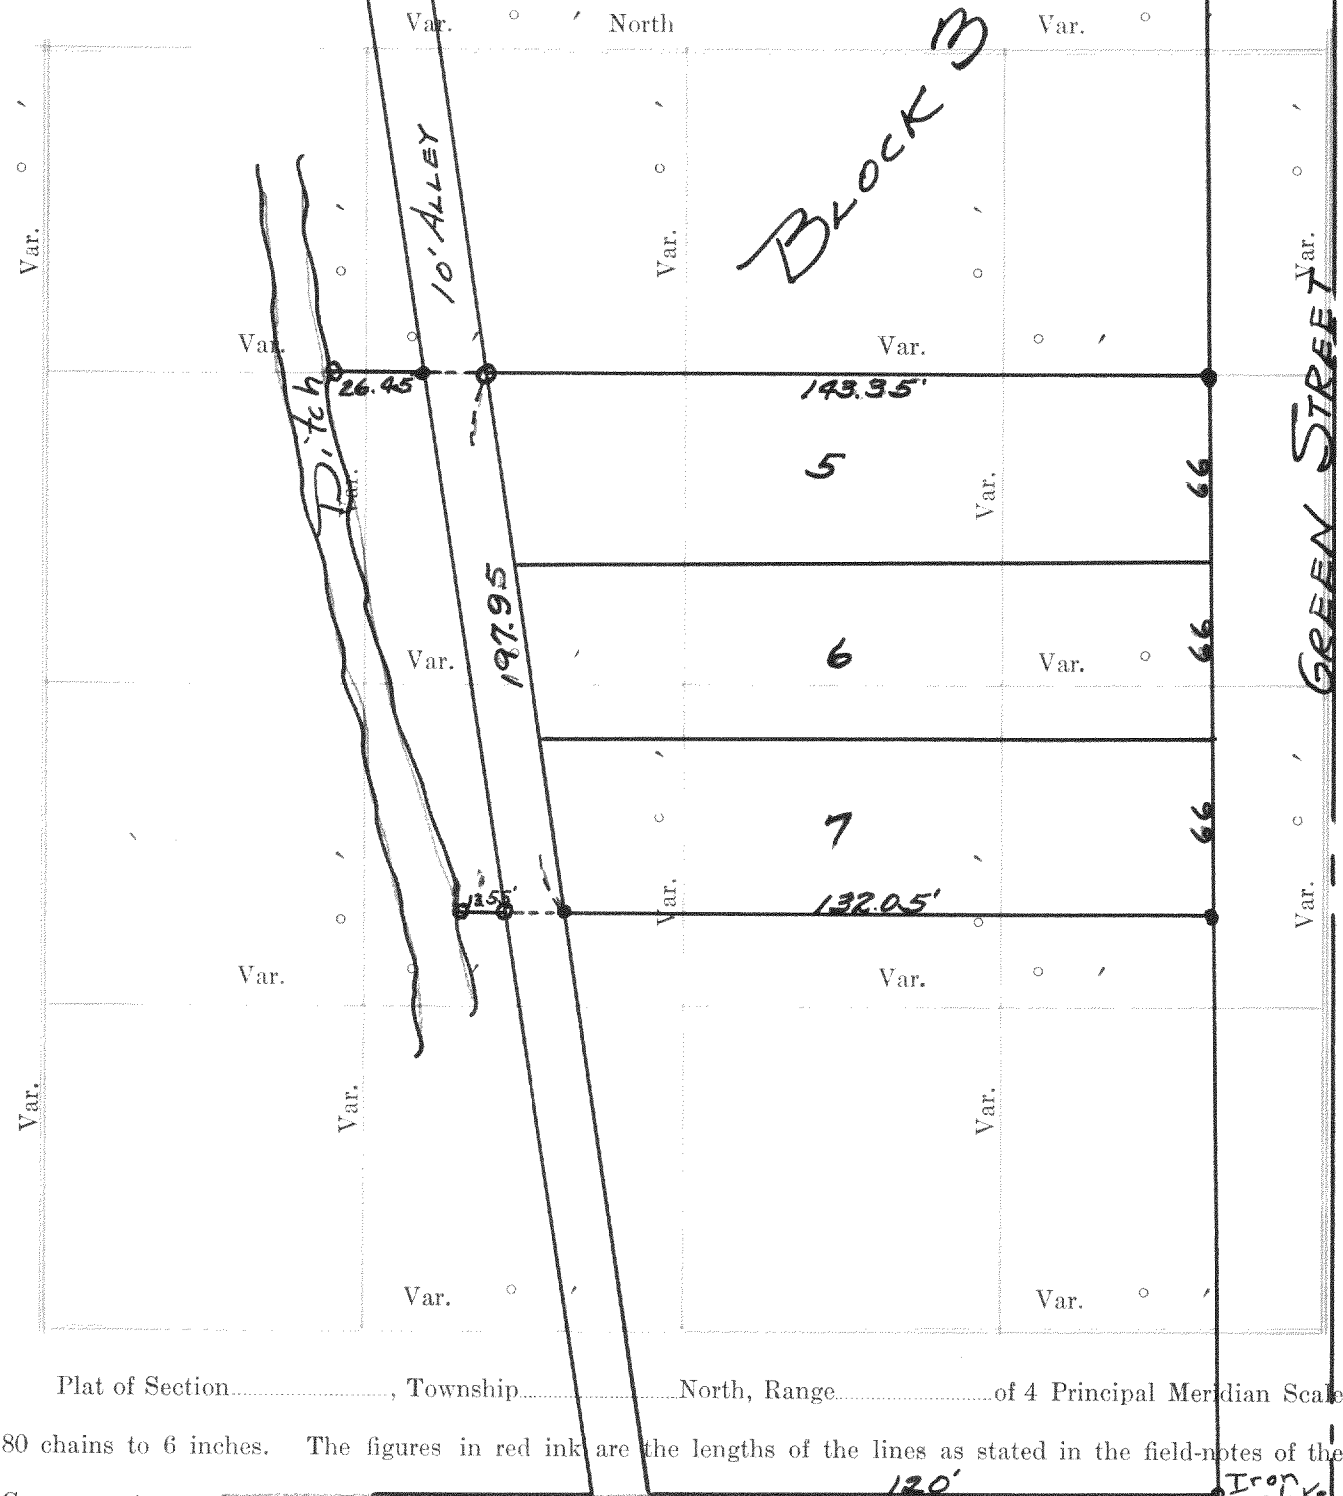

Plat of Section....., Township..... North, Range..... of 4 Principal Meridian Scale
80 chains to 6 inches. The figures in red ink are the lengths of the lines as stated in the field-notes of the
Government survey.

Declination of the Magnetic Meridian from the True Meridian.....
Surveyed and subdivided CLAY STREET A. D. 1..... in accordance
with the State Laws and Instructions of the Commissioner of the General Land office, and recorded on pages
..... of Register in the County Clerk's office.

Witness my hand this..... day of..... A. D. 1.....

SURVEYOR.

GOVERNMENT CORNERS				H. C. MILLER CO. MFG. STATIONERS, MILWAUKEE WIS 5000								
No.	Bearing Trees	In. Dia.	Courses they bear	Links Distant	Bearing Trees	In. Dia.	Courses they bear	Links Distant	Bearing Trees	In. Dia.	Courses they bear	Links Distant
1.	N. W. Sec. Cor. identified,											
2.	N. E. Sec. Cor. identified,											
3.	S. E. Sec. Cor. identified,											
4.	S. W. Sec. Cor. identified,											
5.	N. 1/4 Sec. Cor. identified,											
6.	E. 1/4 Sec. Cor. identified,											
7.	S. 1/4 Sec. Cor. identified,											
8.	W. 1/4 Sec. Cor. identified,											
Subdivision Corners												
1.	Center 1/4 Sec. Cor.											
2.	North 1/4-1/8 N. W. qr.,											
3.	East 1/4-1/8 S. N. W. qr.,											
4.	South 1/4-1/8 N. W. qr.,											
5.	West 1/4-1/8 N. W. qr.,											
6.	Center 1/4-1/8 N. W. qr.,											
7.	North 1/4-1/8 S. N. E. qr.,											
8.	East 1/4-1/8 S. N. E. qr.,											
9.	South 1/4-1/8 S. N. E. qr.,											
10.	Center 1/4-1/8 S. N. E. qr.,											
11.	East 1/4-1/8 S. S. E. qr.,											
12.	South 1/4-1/8 S. S. E. qr.,											
13.	West 1/4-1/8 S. S. E. qr.,											
14.	Center 1/4-1/8 S. S. E. qr.,											
15.	South 1/4-1/8 S. W. qr.,											
16.	West 1/4-1/8 S. W. qr.,											
17.	Center 1/4-1/8 S. W. qr.											

Survey of lots 5-6 & 7 of block 3 of Lippitt
Perry's Subdivision of Block 10 of Lippitt 2nd Addition
to the City of Whitewater.

I found old wood stakes as I have noted.
The SE. cor. of block 3 I obtained by measuring
60 feet and taking a line perpendicular to the NW
street line and this was parallel to Clay Street
located by Mrs. Seple. The measured length of
East line of block 3 checks the plotted distance
and there was an under-run of 0.19' on the rear line.

- Concrete monuments
- Iron pipes

Surveyed May 22, 23 & 24, 1934
By Lloyd S. Jensen
County Surveyor.

Original wood stake
Replaced with Iron
stake

Original wood Stake
Replaced with Iron
Stake

Survey of lots 5-6-7 of block 3 of Tupper & Porey's Subdivision of Block 10 of Tupper's 2nd Addition to the City of Whitewater.
I found old wood stakes as of have noted.
The S.E. cor. of block 3 obtained by measuring over 60 feet and taking a line perpendicular to the N.E. street line and this was parallel to Clay Street as located by Mrs. Teple. The measured length of East line of block 3 checks the plotted distance, and there was an under-run of 0.19' on the rear line.
• Concrete monuments
• Iron pipes

Surveyed May 22, 23 & 24, 1934
Ray Lloyd S. Jensen
County Surveyor.

NAMES OF SWORN ASSISTANTS

FLAGMEN AXMEN

no 549

