


Record of Survey.

No. 562

27-2-16
Township..... North of Range..... of 4 Principal Meridian
as presented by the courses and distances on the following plat, and annexed field-notes of survey:
Established the center of the section at the point of intersection of STRAIGHT quarter lines.
Established all quarter-quarter corners upon the section boundary at proportional distances between known section and quarter section corners, according to the original field-notes of the Government survey.
Established all lost corners at proportionate distances between known corners, according to the original field notes of the Government survey.

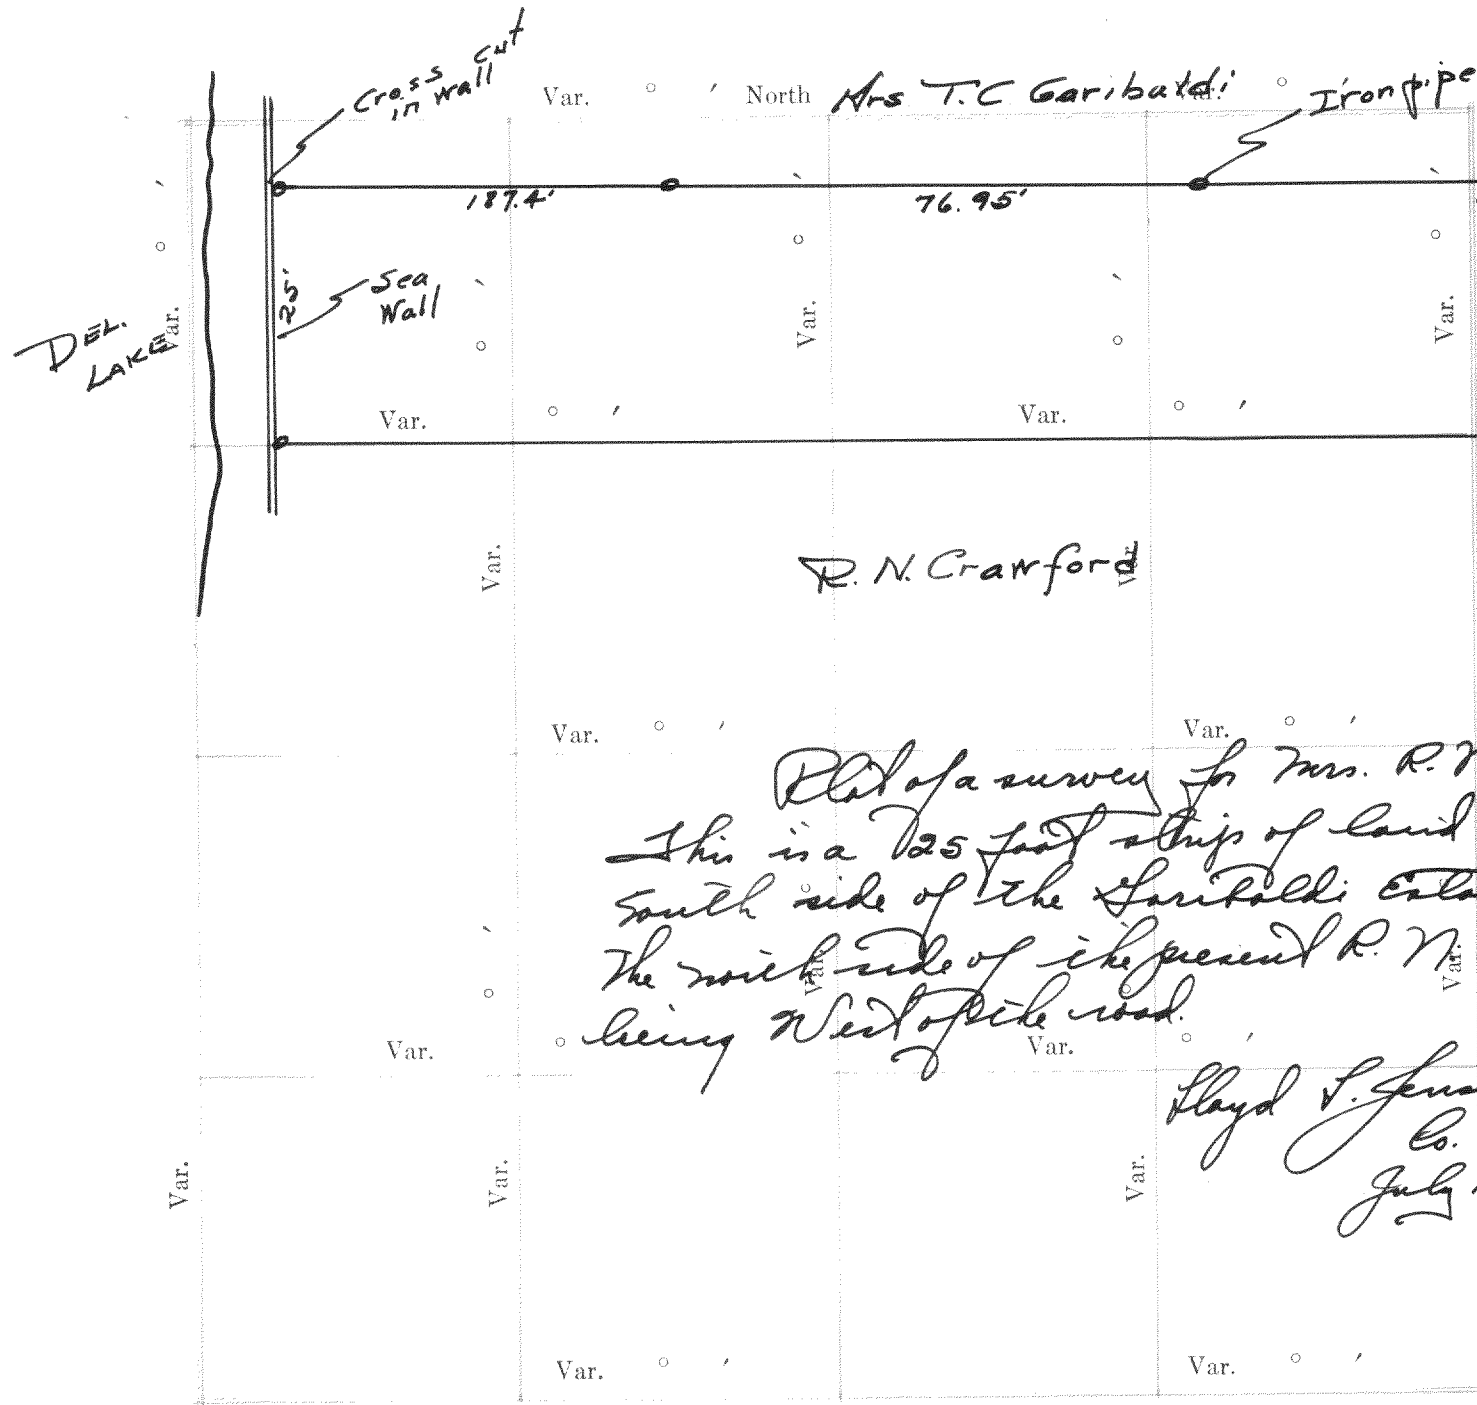

Plat of Section..... Township..... North, Range..... of 4 Principal Meridian Scale
80 chains to 6 inches. The figures in red ink are the lengths of the lines as stated in the field-notes of the Government survey.

Declination of the Magnetic Meridian from the True Meridian.....
Surveyed and sub-divided..... A. D. 1 , in accordance
with the State Laws and Instructions of the Commissioner of the General Land office, and recorded on pages
..... of Register in the County Clerk's office.

Witness my hand this..... day of..... A. D. 1
..... SURVEYOR.

DESCRIPTION

189

OF SECTION, QUARTER SECTION AND QUARTER QUARTER SECTION CORNERS

GOVERNMENT CORNERS

- No.
1. N. W. Sec. Cor. identified,
2. N. E. Sec. Cor. identified,
3. S. E. Sec. Cor. identified,
4. S. W. Sec. Cor. identified,
5. N. 1/4 Sec. Cor. identified,
6. E. 1/4 Sec. Cor. identified,
7. S. 1/4 Sec. Cor. identified,
8. W. 1/4 Sec. Cor. identified,


Subdivision Corners

- No. 25
1. Center 1/4 Sec. Cor.
2. North 1/4-1/4s Road,
3. East 1/4-1/4s N. W. qr.,
4. South 1/4-1/4s N. W. qr.,
5. West 1/4-1/4s N. W. qr.,
6. Center 1/4-1/4s N. W. qr.,
7. North 1/4-1/4s N. E. qr.,
8. East 1/4-1/4s N. E. qr.,
9. South 1/4-1/4s N. E. qr.,
10. Center 1/4-1/4s N. E. qr.,
11. East 1/4-1/4s S. E. qr.,
12. South 1/4-1/4s S. E. qr.,
13. West 1/4-1/4s S. E. qr.,
14. Center 1/4-1/4s S. E. qr.,
15. South 1/4-1/4s S. W. qr.,
16. West 1/4-1/4s S. W. qr.,
17. Center 1/4-1/4s S. W. qr.

Bearing In. Courses Links Bearing In. Courses Links Bearing In. Courses Links
Trees Dia. they bear Distant Trees Dia. they bear Distant Trees Dia. they bear Distant

No. 563

WANDAYEGA CLUB HOUSE GROUNDS
SEC. 1-3-16

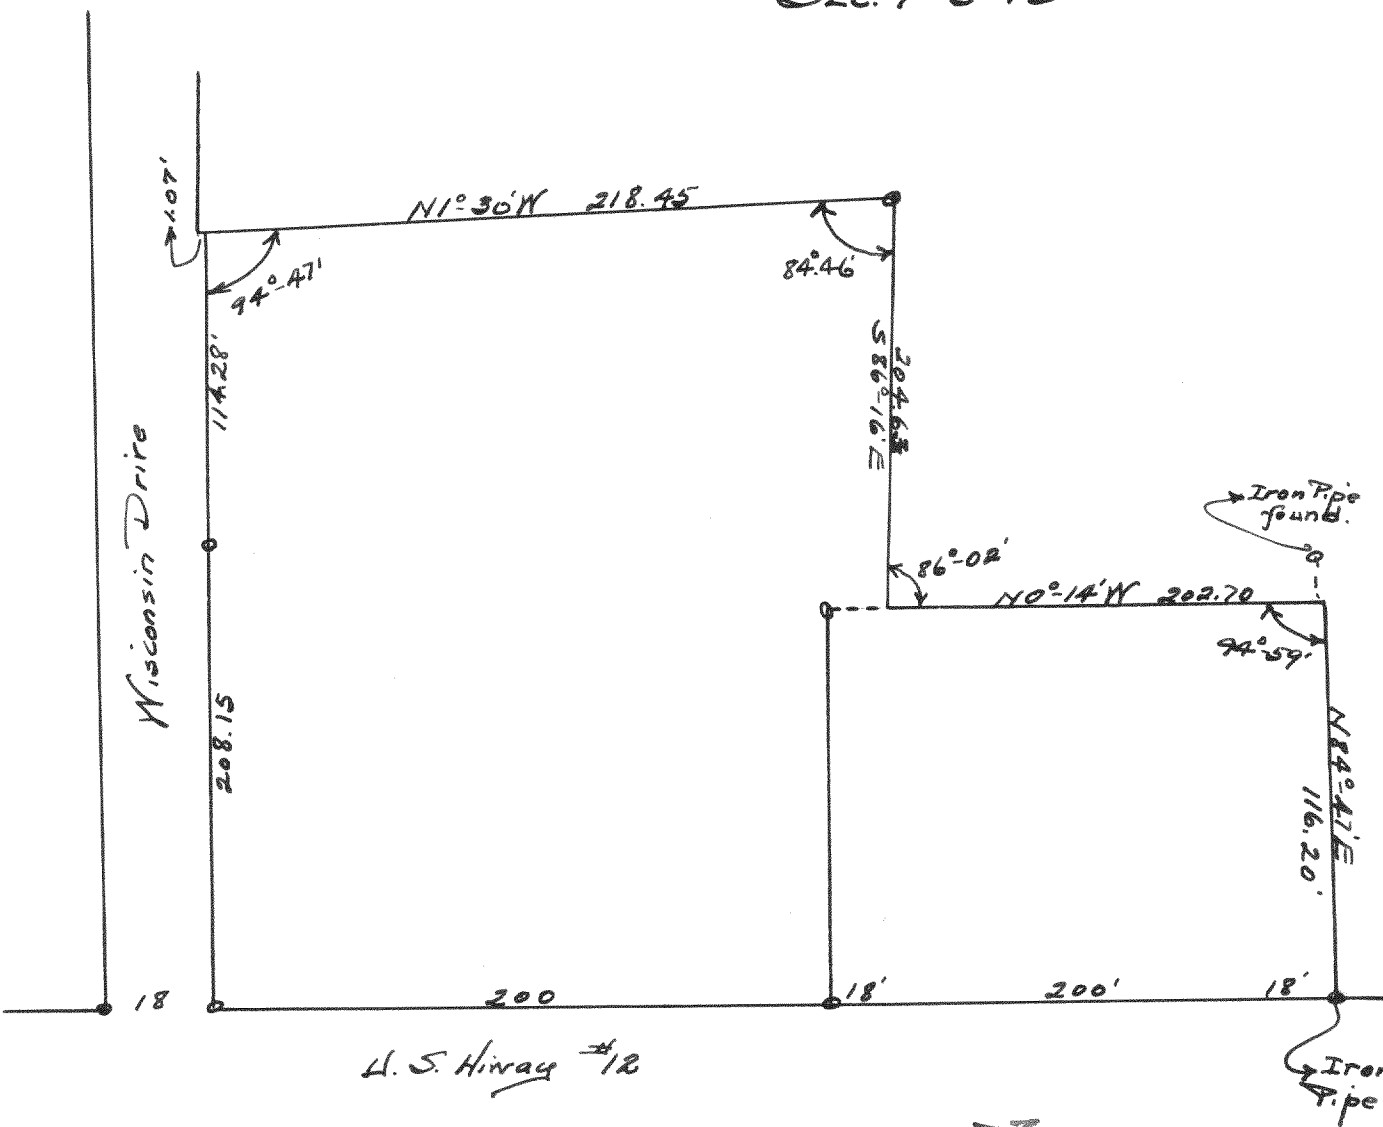

Plat of a survey of the Club house grounds as laid out by the Subd. owners on the recorded plat of the Golf Addition. Survey for the Township of Sugar Creek. Lloyd S. Jensen Co. Sur. July 12, 1934.


NAMES OF SWORN ASSISTANTS

CHAINMEN

FLAGMEN

AXMEN


Elkhorn

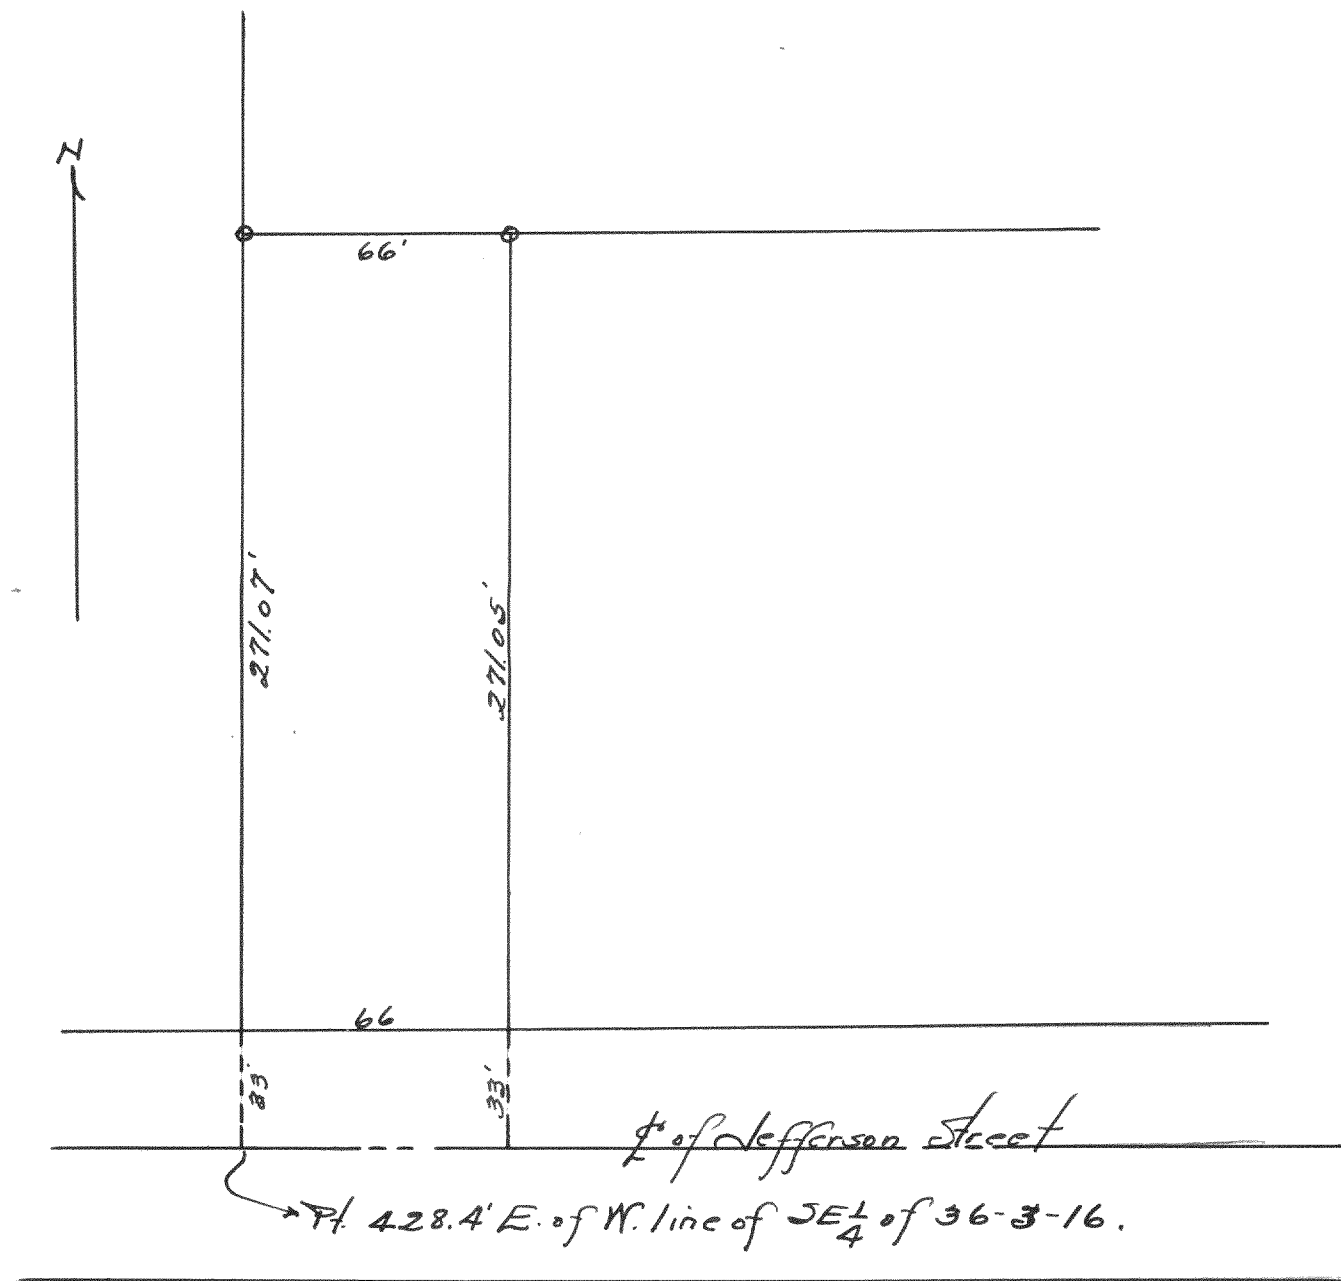SE $\frac{1}{4}$ 36-3-16

Survey of lot for J. Finch.
 Lloyd V. Jensen
 Co. Sur.
 July 15, 1934

Elkhorn

Block 39, Lot 12 of Davis Add.

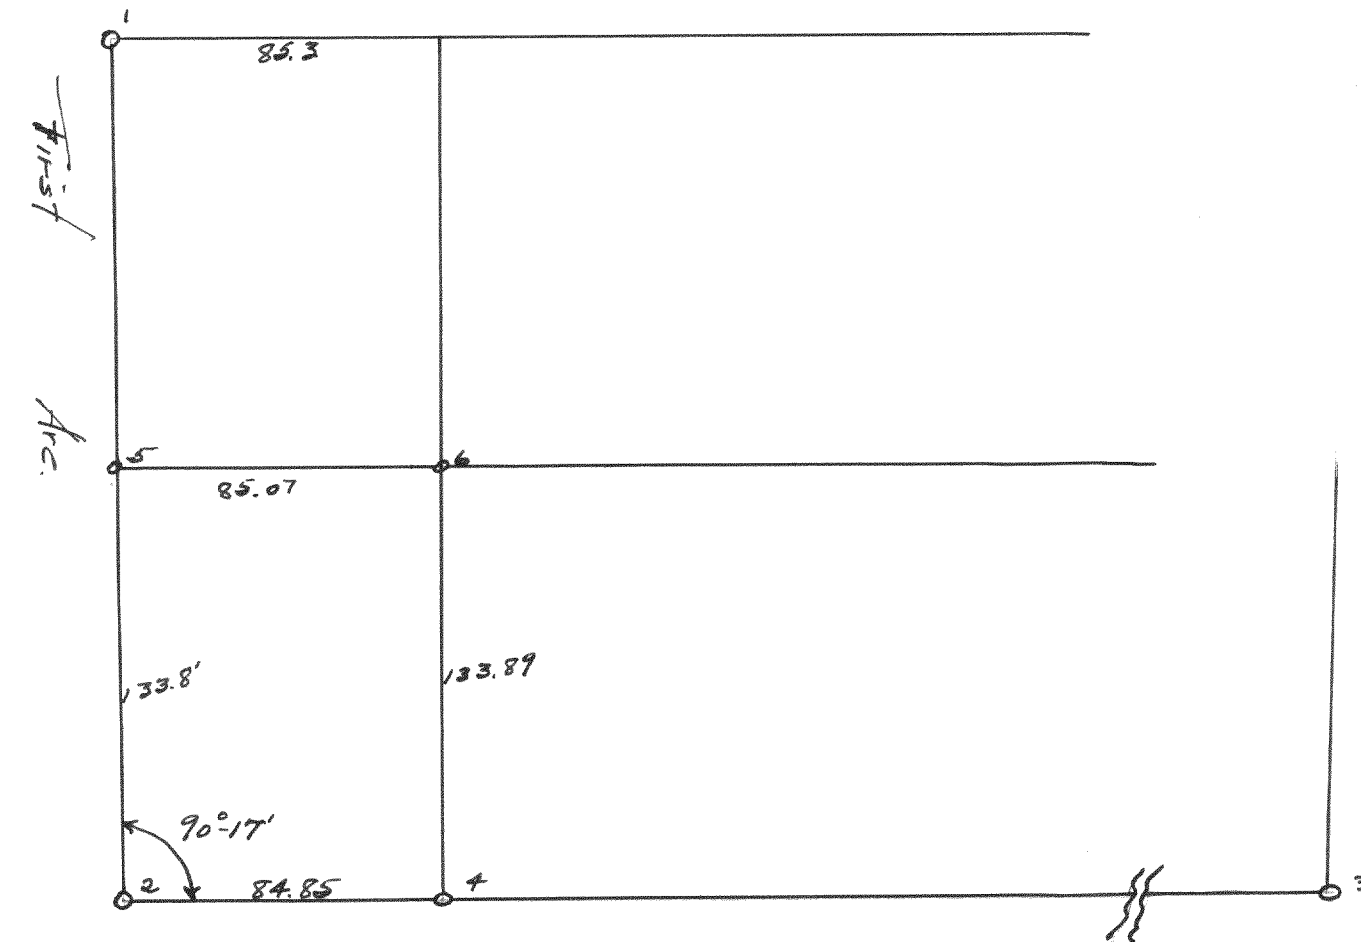

Broad St.
 Iron pipes found at points marked 1, 2 & 3.
 " " set " " " 4, 5 & 6
 Distances taken from City Engineers records,
 checked and found correct.

Lloyd V. Jensen
 Co. Sur.