


Record of Survey.

DESCRIPTION

19

no 42

Township....., North of Range.....of 4 Principal Meridian as presented by the courses and distances on the following plat, and annexed field-notes of survey:
Established the center of the section at the point of intersection of STRAIGHT quarter lines.
Established all quarter-quarter corners upon the section boundary at proportional distances between known section and quarter section corners, according to the original field-notes of the Government survey.
Established all lost corners at proportionate distances between known corners, according to the original field notes of the Government survey.

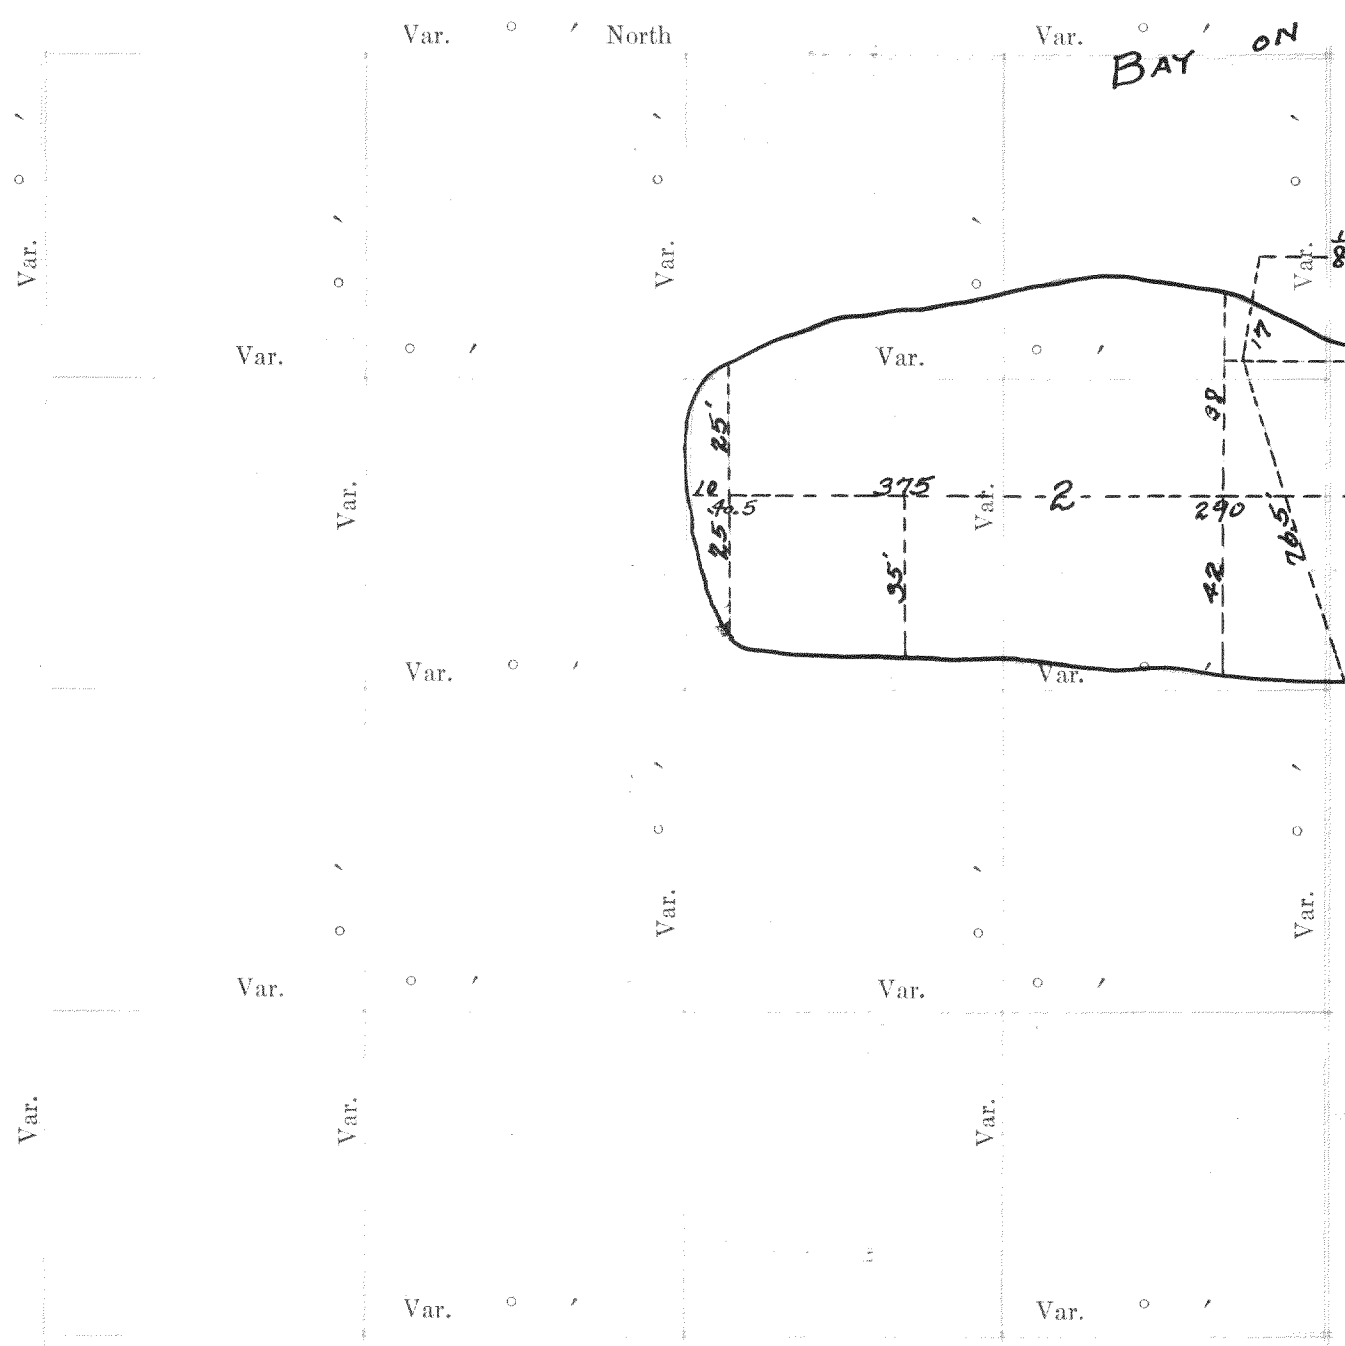

Plat of Section....., Township.....North, Range.....of 4 Principal Meridian Scale 80 chains to 6 inches. The figures in red ink are the lengths of the lines as stated in the field-notes of the Government survey.
Declination of the Magnetic Meridian from the True Meridian.....
Surveyed and sub-divided.....A. D. 1....., in accordance with the State Laws and Instructions of the Commissioner of the General Land office, and recorded on pages.....of Register in the County Clerk's office.
Witness my hand this.....day of.....A. D. 1.....

OF SECTION, QUARTER SECTION AND QUARTER QUARTER SECTION CORNERS

No.	GOVERNMENT CORNERS				SECTION CORNERS				QUARTER SECTION CORNERS				QUARTER QUARTER SECTION CORNERS			
	Bearing	In.	Courses	Links	Bearing	In.	Courses	Links	Bearing	In.	Courses	Links	Bearing	In.	Courses	Links

1. N. W. Sec. Cor. identified,
2. N. E. Sec. Cor. identified,
3. S. E. Sec. Cor. identified,
4. S. W. Sec. Cor. identified,
5. N. 1/4 Sec. Cor. identified,
6. E. 1/4 Sec. Cor. identified,
7. S. 1/4 Sec. Cor. identified,
8. W. 1/4 Sec. Cor. identified,
9. South 1/4-1/4 S. N. E. qr.,
10. Center 1/4-1/4 S. N. E. qr.,
11. East 1/4-1/4 S. E. qr.,
12. South 1/4-1/4 S. E. qr.,
13. West 1/4-1/4 S. E. qr.,
14. Center 1/4-1/4 S. E. qr.,
15. South 1/4-1/4 S. W. qr.,
16. West 1/4-1/4 S. W. qr.,
17. Center 1/4-1/4 S. W. qr.,

Plat of a Survey made for Mrs. John Echart of Chicago to locate the boundary of her lot at Lake Beulah, Township of East Troy, Walworth County, Wisconsin which is a part of Lot 1 and Lots 2-3-4-5 of Porters Park The South half of lot No. 7 of Frees Park, and a part of lots 18 & 19 of Beulah Lake Park a plot of each Park being on record in the register of Deeds office in and for the Said County. East Troy May 8th 1928 Wm Child

Recorded March 2, 1933 by
NAME OF SURVEY ASSISTANTS
County Surveyor
AXMEN


Record of Survey.

DESCRIPTION

20

No 43

Township....., North of Range.....of 4 Principal Meridian
as presented by the courses and distances on the following plat, and annexed field-notes of survey:
Established the center of the section at the point of intersection of STRAIGHT quarter lines.
Established all quarter-quarter corners upon the section boundary at proportional distances between known section and quarter section corners, according to the original field-notes of the Government survey.
Established all lost corners at proportionate distances between known corners, according to the original field notes of the Government survey.

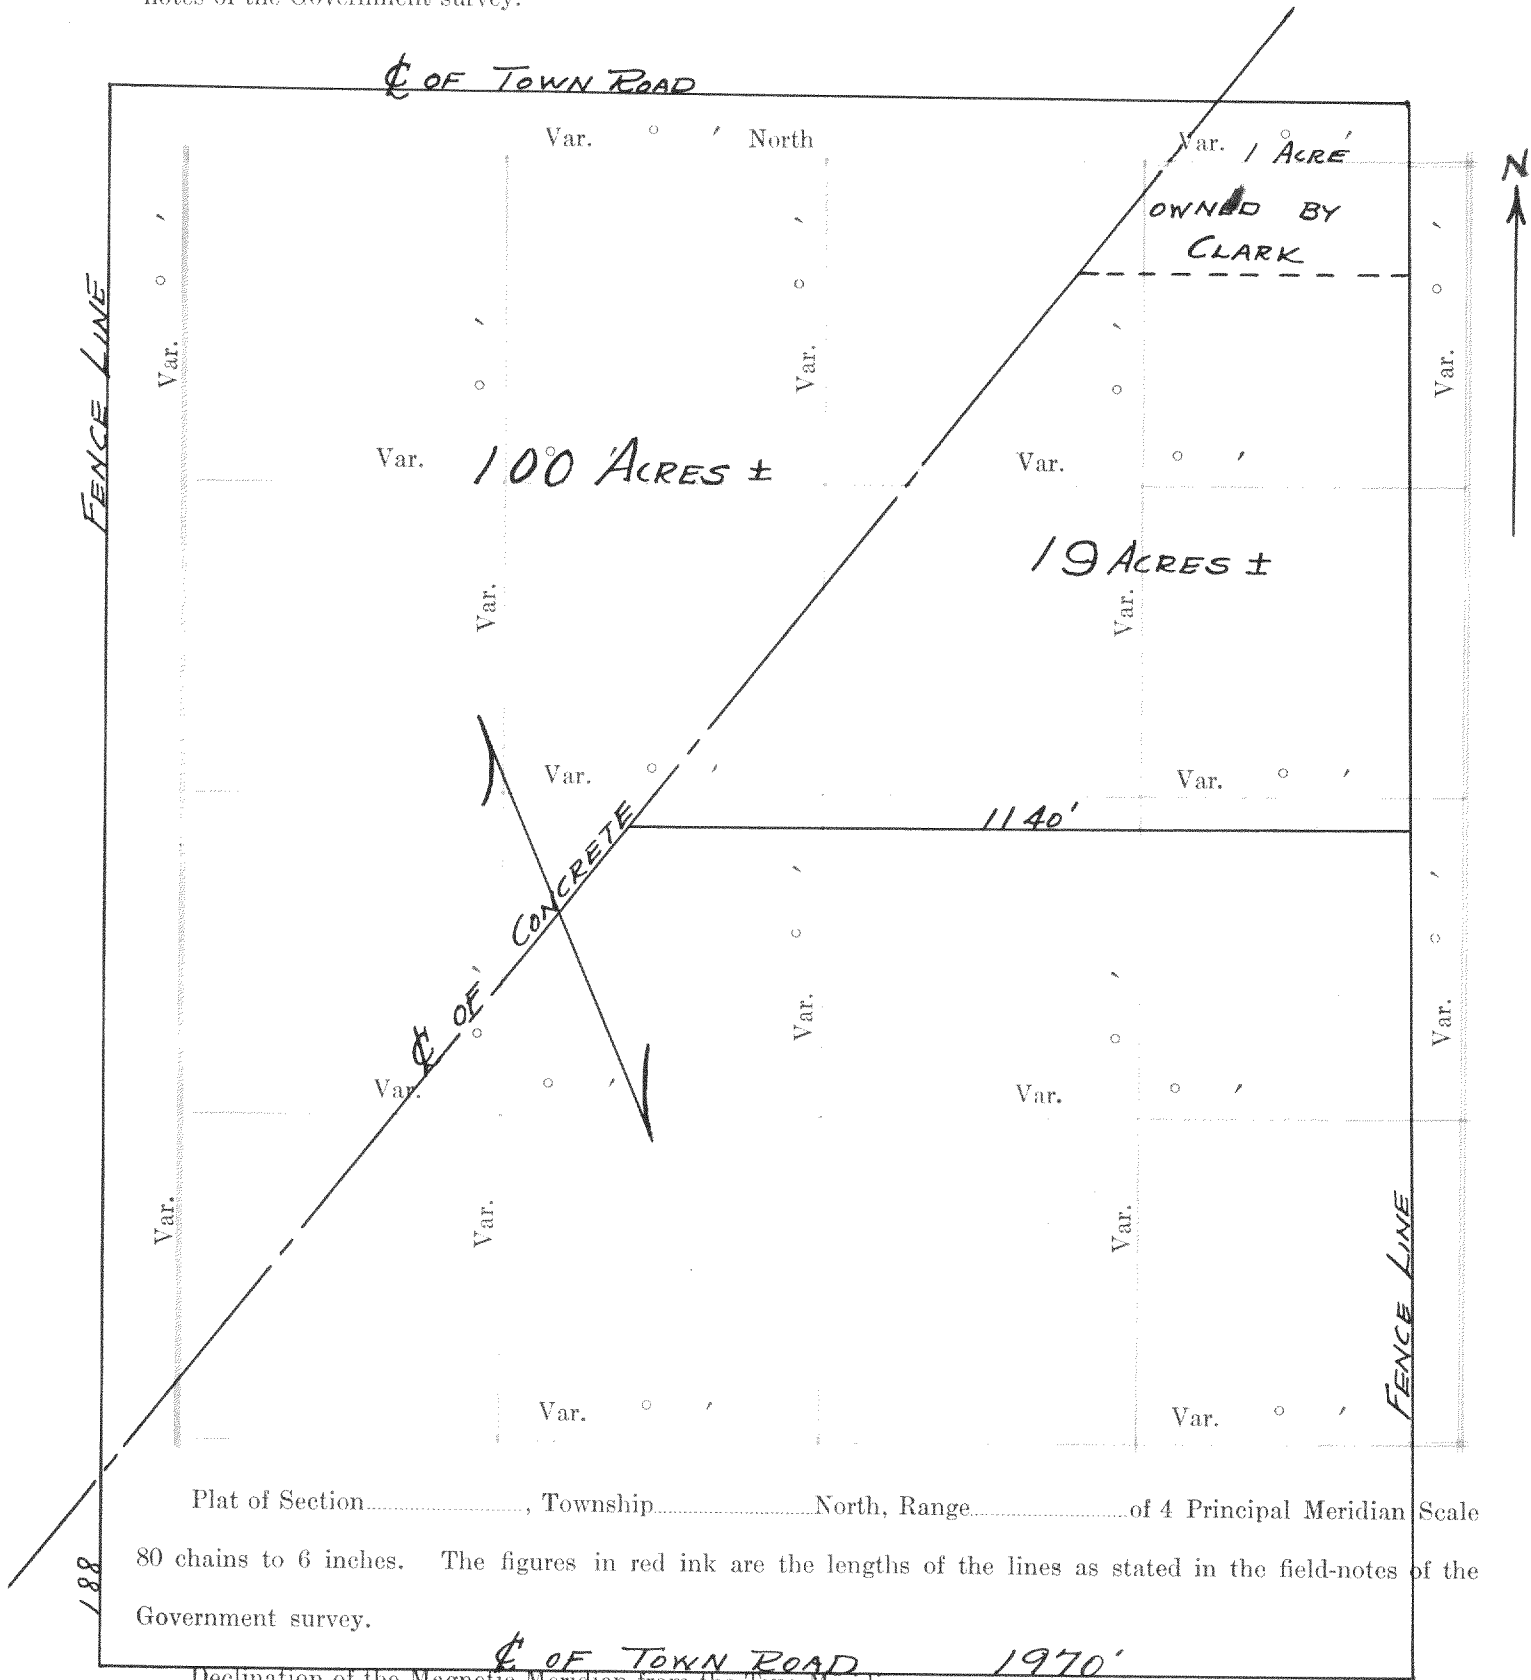

Plat of Section....., Township.....North, Range.....of 4 Principal Meridian Scale
80 chains to 6 inches. The figures in red ink are the lengths of the lines as stated in the field-notes of the
Government survey.

Declination of the Magnetic Meridian from the True Meridian.....

Surveyed and sub-divided.....A. D. 1....., in accordance
with the State Laws and Instructions of the Commissioner of the General Land office, and recorded on pages
.....of Register in the County Clerk's office.

Witness my hand this.....day of.....A. D. 1.....

SURVEYOR.

OF SECTION, QUARTER SECTION AND QUARTER QUARTER SECTION CORNERS

GOVERNMENT CORNERS

- No.
1. N. W. Sec. Cor. identified,
2. N. E. Sec. Cor. identified,
3. S. E. Sec. Cor. identified,
4. S. W. Sec. Cor. identified,
5. N. 1/4 Sec. Cor. identified,
6. E. 1/4 Sec. Cor. identified,
7. S. 1/4 Sec. Cor. identified,
8. W. 1/4 Sec. Cor. identified,

Subdivision Corners

- No.
1. Center 1/4 Sec. Cor.,
2. North 1/4-1/4s N. W. qr.,
3. East 1/4-1/4s N. W. qr.,
4. South 1/4-1/4s N. W. qr.,
5. West 1/4-1/4s N. W. qr.,
6. Center 1/4-1/4s N. W. qr.,
7. North 1/4-1/4s N. E. qr.,
8. East 1/4-1/4s N. E. qr.,
9. South 1/4-1/4s N. E. qr.,
10. Center 1/4-1/4s N. E. qr.,
11. East 1/4-1/4s S. E. qr.,
12. South 1/4-1/4s S. E. qr.,
13. West 1/4-1/4s S. E. qr.,
14. Center 1/4-1/4s S. E. qr.,
15. South 1/4-1/4s S. W. qr.,
16. West 1/4-1/4s S. W. qr.,
17. Center 1/4-1/4s S. W. qr.

Bearing In. Courses Links Bearing In. Courses Links Bearing In. Courses Links Bearing In. Courses Links
Trees Dia. they bear Distant Trees Dia. they bear Distant Trees Dia. they bear Distant

Survey of 100 Acres off of the farm of Miss Helen Rybeck of Gray center.
Location of farm - Sec. 1, T4N, R16E
The E of the adjoining roads were used as the boundary lines and the fences on the East and west.

Description of the 100 acres -
Beginning at the N. W. cor. of the E 1/2 of N 1/2 of the SE 1/4 of sec. 1, T4N, R16E, thence S. to the SW. cor. of the E 1/2 of N 1/2 of the SE 1/4 of sec. 1, T4N, R16E
Thence E. to the SE. cor. of sec. 1, T4N, R16E.
Thence N 1283.7 feet, thence W. to the E of conc. highway as now laid out, thence N.E. by along E of said highway to the N. line of the SE 1/4 of sec. 1, T4N, R16E, thence W. to pt. of beginning, containing 100 acres more or less.

Feb. 23, 1933
Lloyd S. Jensen
County Surveyor.

NAMES OF SWORN ASSISTANTS

CHAINMEN

FLAGMEN

AXMEN