


Record of Survey.

No. 566

Township....., North of Range..... of 4 Principal Meridian
as presented by the courses and distances on the following plat, and annexed field-notes of survey:
Established the center of the section at the point of intersection of STRAIGHT quarter lines.
Established all quarter-quarter corners upon the section boundary at proportional distances between known section and quarter section corners, according to the original field-notes of the Government survey.
Established all lost corners at proportionate distances between known corners, according to the original field notes of the Government survey.

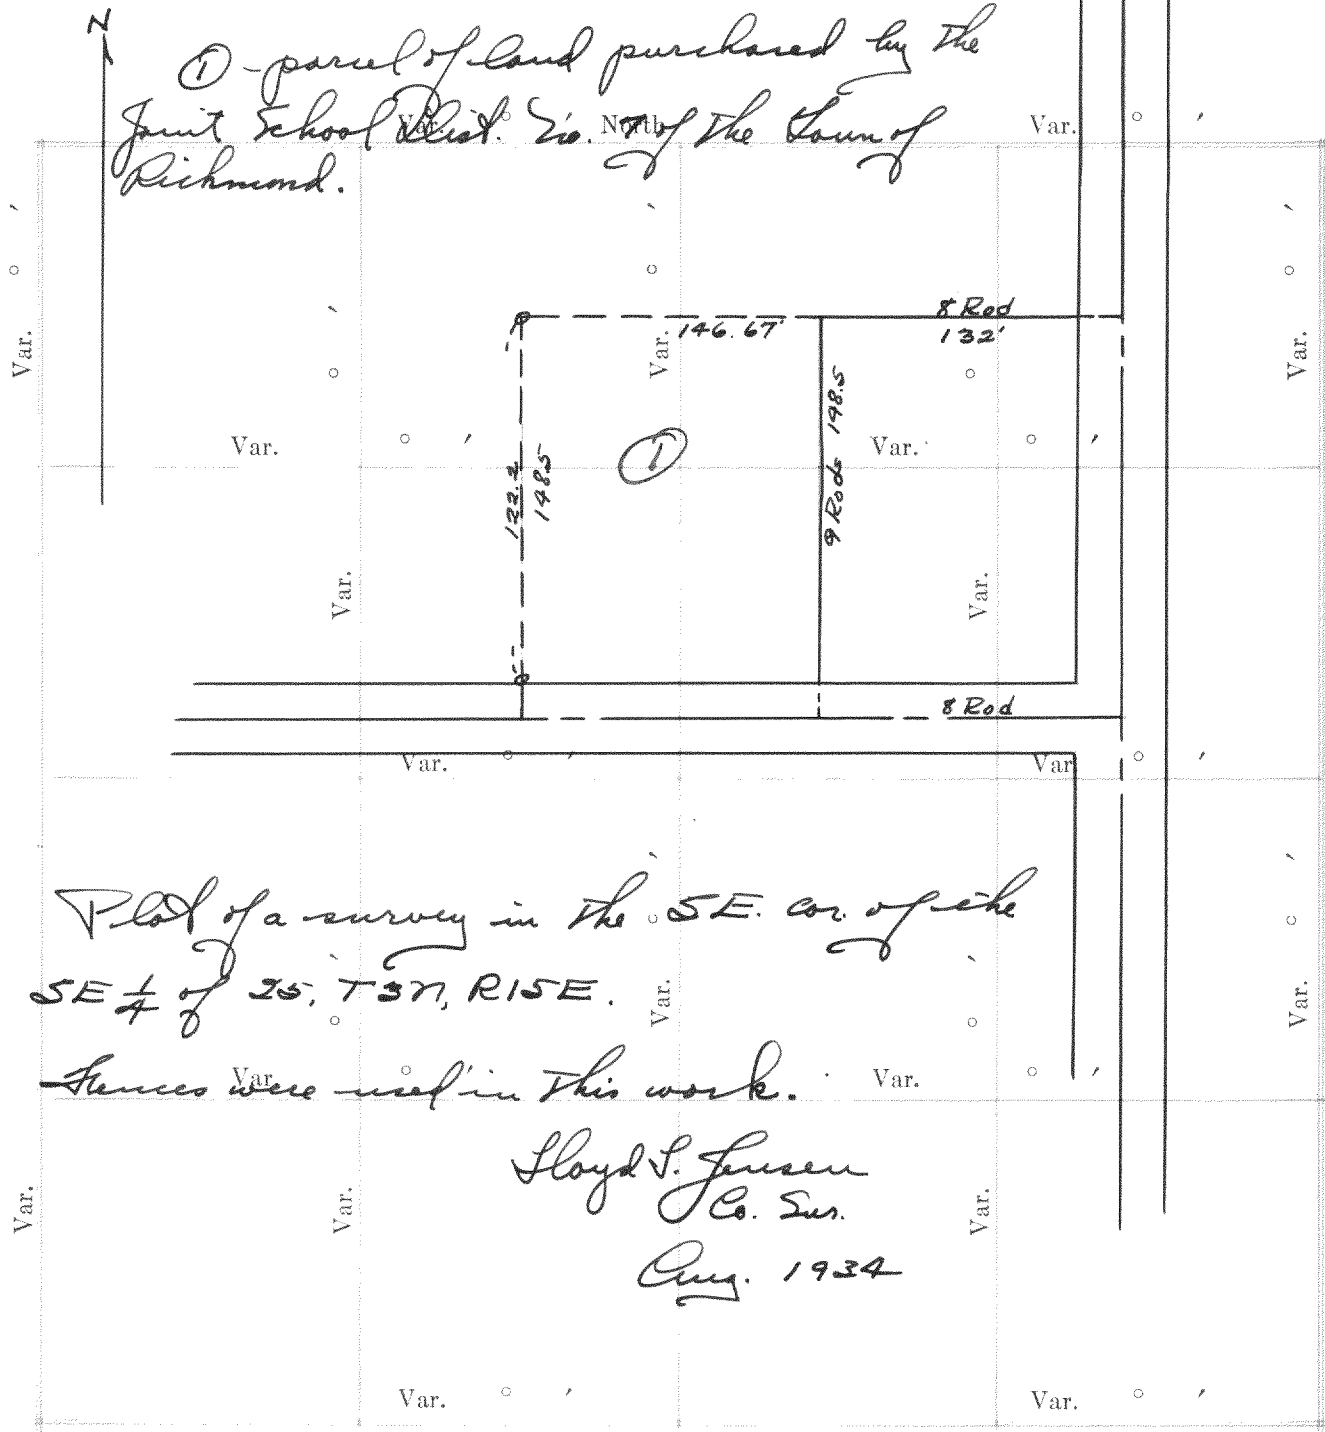

Plat of Section....., Township..... North, Range..... of 4 Principal Meridian Scale
80 chains to 6 inches. The figures in red ink are the lengths of the lines as stated in the field-notes of the
Government survey.
Declination of the Magnetic Meridian from the True Meridian.....
Surveyed and sub-divided..... A. D. 1 , in accordance
with the State Laws and Instructions of the Commissioner of the General Land office, and recorded on pages
..... of Register in the County Clerk's office.
Witness my hand this..... day of..... A. D. 1
..... SURVEYOR.

DESCRIPTION

190

OF SECTION, QUARTER SECTION AND QUARTER QUARTER SECTION CORNERS

GOVERNMENT CORNERS				H. C. MILLER CO., MFG. STATIONERS, MILWAUKEE X15000								
No.	Bearing Trees	In. Dia.	Courses they bear	Links Distant	Bearing Trees	In. Dia.	Courses they bear	Links Distant	Bearing Trees	In. Dia.	Courses they bear	Links Distant
1.	N. W. Sec. Cor. identified,											
2.	N. E. Sec. Cor. identified,											
3.	S. E. Sec. Cor. identified,											
4.	S. W. Sec. Cor. identified,											
5.	N. 1/4 Sec. Cor. identified,											
6.	E. 1/4 Sec. Cor. identified,											
7.	S. 1/4 Sec. Cor. identified,											
8.	W. 1/4 Sec. Cor. identified,											
Subdivision Corners												
No.												
1.	Center 1/4 Sec. Cor.											
2.	North 1/4-1/4s N. W. qr.,											
3.	East 1/4-1/4s N. W. qr.,											
4.	South 1/4-1/4s N. W. qr.,											
5.	West 1/4-1/4s N. W. qr.,											
6.	Center 1/4-1/4s N. E. qr.,											
7.	North 1/4-1/4s N. E. qr.,											
8.	East 1/4-1/4s N. E. qr.,											
9.	South 1/4-1/4s N. E. qr.,											
10.	Center 1/4-1/4s S. E. qr.,											
11.	East 1/4-1/4s S. E. qr.,											
12.	South 1/4-1/4s S. E. qr.,											
13.	West 1/4-1/4s S. E. qr.,											
14.	Center 1/4-1/4s S. W. qr.,											
15.	South 1/4-1/4s S. W. qr.,											
16.	West 1/4-1/4s S. W. qr.,											
17.	Center 1/4-1/4s S. W. qr.											


No. 567

Fontana - Lake View Subd.

Map details: Lot 1, 2, 3, 4, 5, 6, 7, 8, 9, 10, 11, 12, 13, 14. Road. Bearings: N 20° 53' E 270.0', N 20° 58' W 330'. Distances: 234', 60', 96.7', 95.7', 187.0', 97.0', 60', 14 60', 65', 87, 30', 3

No. 567

Fontana - Lake View Subd.

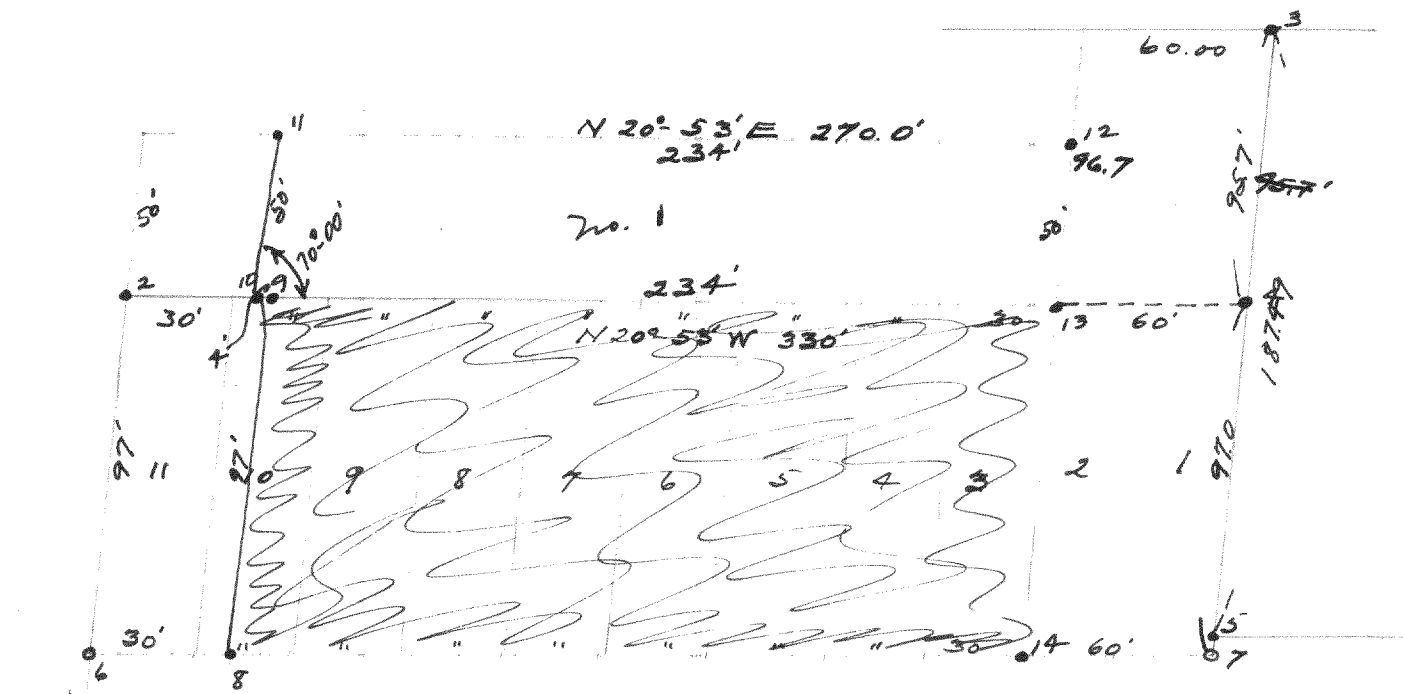

Prop owned by boat Co. - lots 3 - 9 & the 1/2 of lot 10.
Found conc. mon. at points marked 1, 2, 3, 4 & 5
" " " " " " 6 & 7
Set conc. mon. at " " " " 8, 9, 10, 11, 12, 13 & 14
Parcel No. 1. purchased by a meter & bounds description
and runs to South of the property owned in the Subd.
Found all measurements to check the recorded plat of
Fontana. Survey for Palmes Boat Co.
Lloyd S. Jensen
Co. Sur.

NAMES OF SWORN ASSISTANTS

CHAINMEN

FLAGMEN

AXMEN

