


PELL LAKE SUBD.

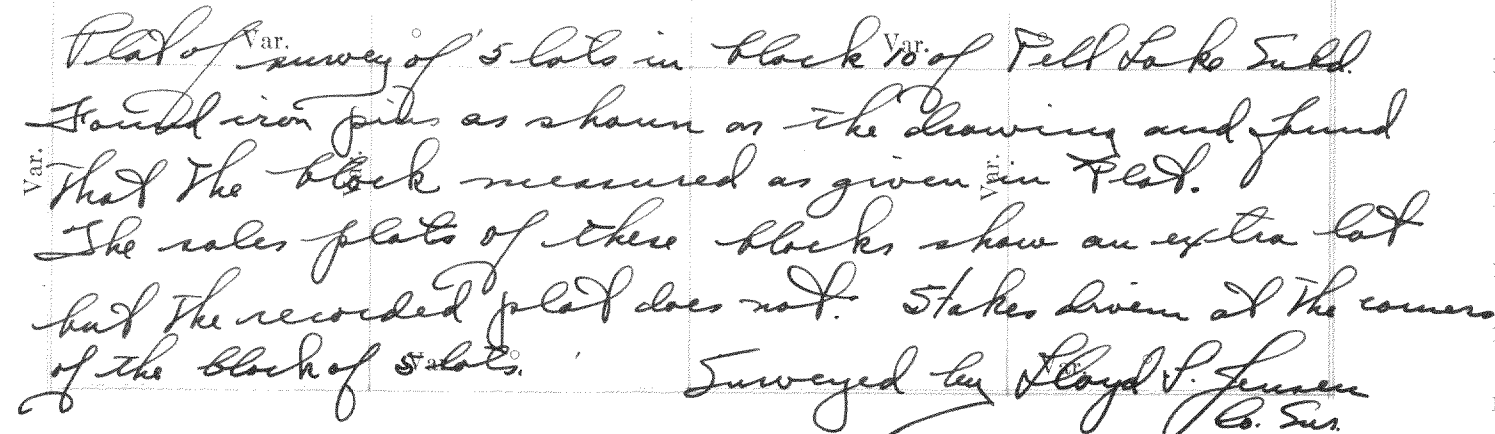

Witness my hand this.....day of.....A. D. 1

...SURVEYOR.

GOVERNMENT CORNERS

No. 571

Survey of lot 3 & 1 of lot 4 of Esterly's Add. to the
City of Watervliet, for Paula Stegeman Priewe.

Lloyd S. Jensen
Co. Sur.
Sept. 29, 1934

CHAINMEN

FLAGMEN

AXMEN

No. 572

NW $\frac{1}{4}$ of Sec. 4, T4N, R18E

No. 574

Mellate Subd.


Relocated the original corners of lots
15, 16, 17, 18, 19, 20, 21, 22, 23, 24, 25, 26 & 27 & 28 of
The Mellate Subdivision.

Lloyd V. Jensen
Co. Sur.

No. 573

Indian Hills Subd.

14-1-16

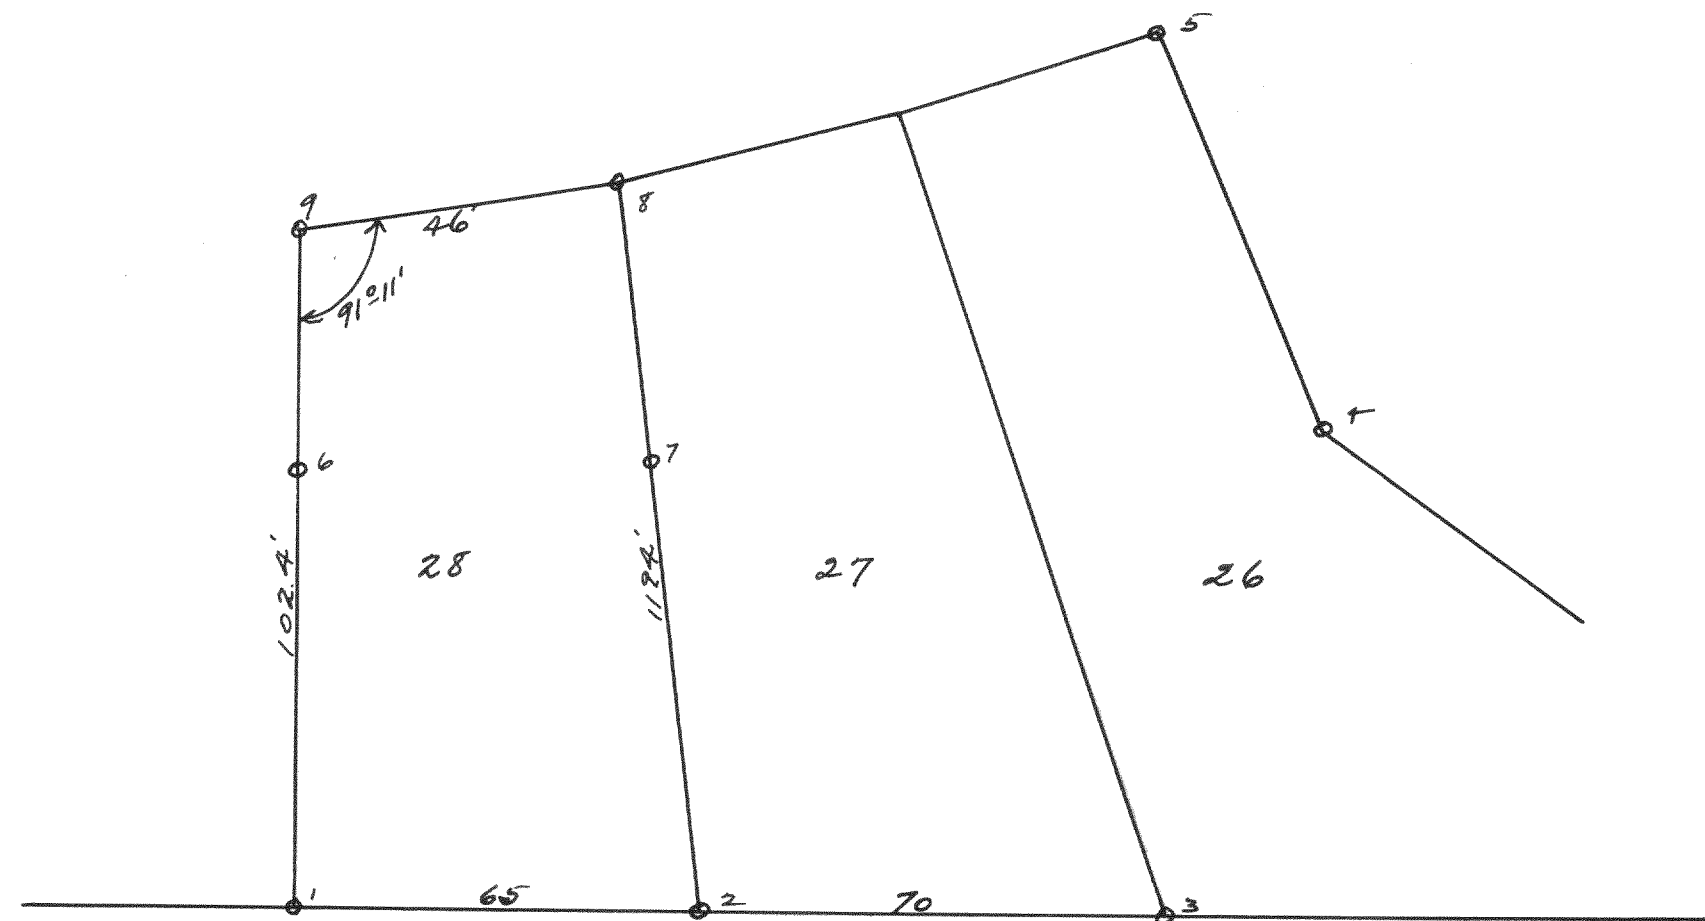

Survey of lot 28 of Block 1 of Indian Hills, located
in, sec. 14-1-16, Village of Fontana.
Iron pipes found at 1, 2, 3, 4 & 5.
" " " at 6, 7, 8 & 9

Lloyd V. Jensen
Co. Sur.
Oct. 16, 1934

WHITewater CITY



Pilot of a survey of lot 19 & all of lot 18
except the West 16.5 feet of lot 18 of block
14 of the original City of Whitewater.
Survey for Postoffice site.

Lloyd V. Jensen
Co. Sur.
Oct. 1934