


Township.....*Lake Wandauega Subd.*.....North of Range.....of 4 Principal Meridian
as presented by the courses and distances on the following plat, and annexed field-notes of survey:
Established the center of the section at the point of intersection of STRAIGHT quarter lines.
Established all quarter-quarter corners upon the section boundary at proportional distances between known section and quarter section corners, according to the original field-notes of the Government survey.
Established all lost corners at proportionate distances between known corners, according to the original field notes of the Government survey.

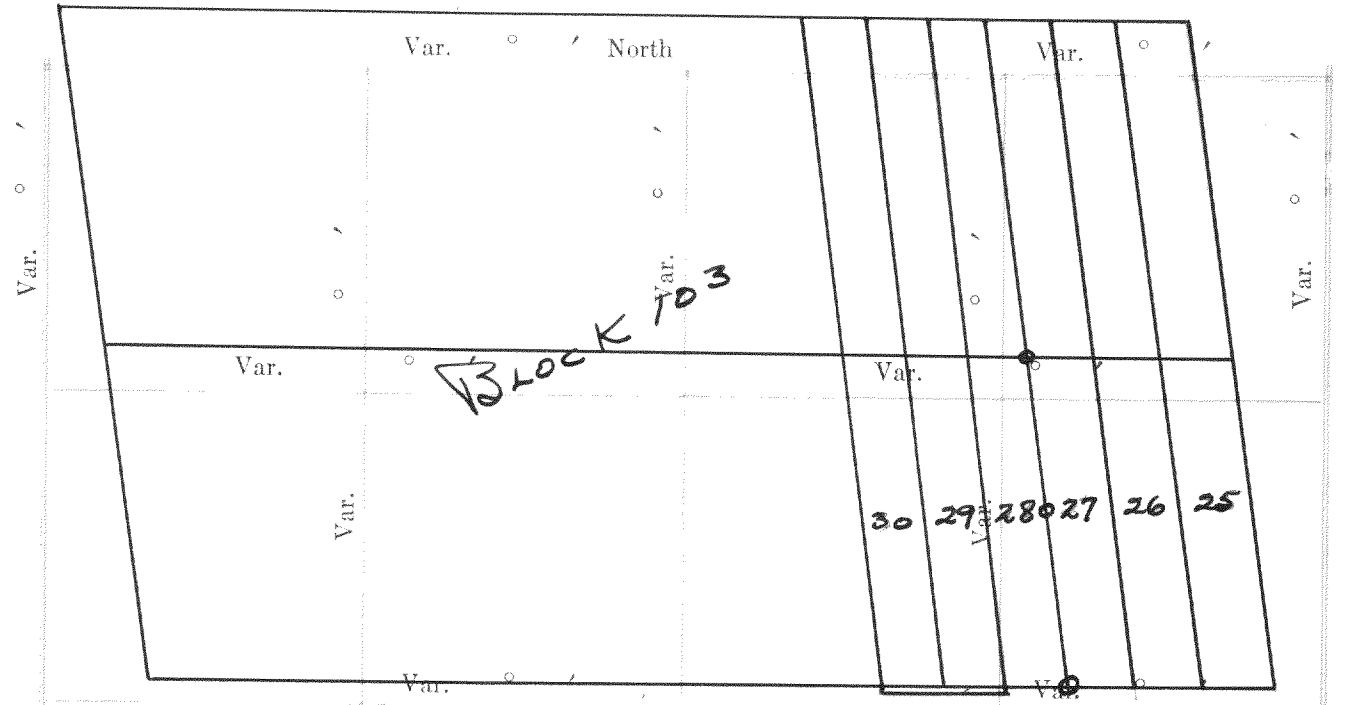

Plat of a survey of lots 28, 29 & 30 of Block 103 of Lake Wandauega Subd.. Survey to mark the East line of lot 28 and to show the relative location of the stone wall in front of lots 29 & 30. West end of wall is 1.65' on road. East end of wall is 2.0' on the road. Lines of block found from adjoining block corners. Surveyed by Lloyd S. Jensen Co. Sur. Dec. 1934

Plat of Section....., Township.....North, Range.....of 4 Principal Meridian Scale 80 chains to 6 inches. The figures in red ink are the lengths of the lines as stated in the field-notes of the Government survey.
Declination of the Magnetic Meridian from the True Meridian.....
Surveyed and sub-divided.....A. D. 1, in accordance with the State Laws and Instructions of the Commissioner of the General Land office, and recorded on pages.....of Register in the County Clerk's office.
Witness my hand this.....day of.....A. D. 1.....SURVEYOR.

OF SECTION, QUARTER SECTION AND QUARTER QUARTER SECTION CORNERS

GOVERNMENT CORNERS				H. C. MILLER CO. MFG. STATIONERS, MILWAUKEE X15000								
No.	Bearing	In.	Courses	Links	Bearing	In.	Courses	Links	Bearing	In.	Courses	Links
	Trees	Dia.	they bear	Distant	Trees	Dia.	they bear	Distant	Trees	Dia.	they bear	Distant
1.	N. W. Sec. Cor. identified,											
2.	N. E. Sec. Cor. identified,											
3.	S. E. Sec. Cor. identified,											
4.	S. W. Sec. Cor. identified,											
5.	N. 1/4 Sec. Cor. identified,											
6.	E. 1/4 Sec. Cor. identified,											
7.	S. 1/4 Sec. Cor. identified,											
8.	W. 1/4 Sec. Cor. identified,											
Subdivision Corners												
No.												
1.	Center 1/4 Sec. Cor.											
2.	North 1/4-1/4s N. W. qr.,											
3.	East 1/4-1/4s N. W. qr.,											
4.	South 1/4-1/4s N. W. qr.,											
5.	West 1/4-1/4s N. W. qr.,											
6.	Center 1/4-1/4s N. W. qr.,											
7.	North 1/4-1/4s N. E. qr.,											
8.	East 1/4-1/4s N. E. qr.,											
9.	South 1/4-1/4s N. E. qr.,											
10.	Center 1/4-1/4s N. E. qr.,											
11.	East 1/4-1/4s S. E. qr.,											
12.	South 1/4-1/4s S. E. qr.,											
13.	West 1/4-1/4s S. E. qr.,											
14.	Center 1/4-1/4s S. E. qr.,											
15.	South 1/4-1/4s S. W. qr.,											
16.	West 1/4-1/4s S. W. qr.,											
17.	Center 1/4-1/4s S. W. qr.,											

Williams Bay


Sq. Wood Stake

Iron Stake

Lot 14 - Block 7 of the original village of Williams Bay.

50.06'

Used South line of Madison lot and the NW cor. of Block 7, total dist. = 1047.84', Platted dist. = 1046.68
Overrun for this parcel = .06'.
The NW. cor. of lot 14 falls 0.15' N. of the N. face of the N. sq. wood post at the W. end of the School lot.
Surveyed by - Lloyd L Jensen
Co. Sur.
Dec. 1934

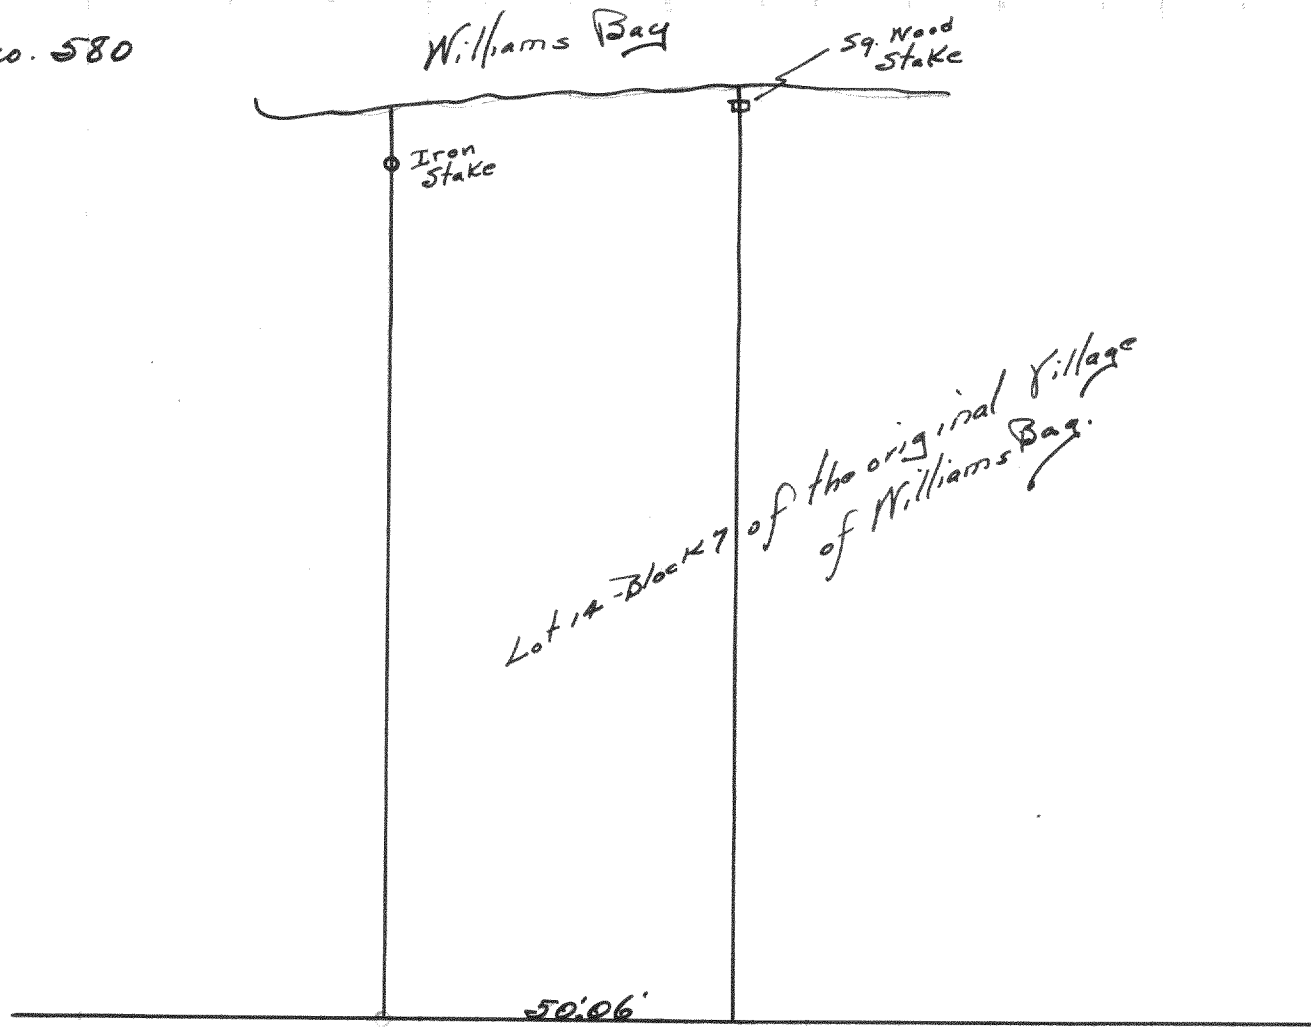

Used South line of median lot and the NW cor. of Block 7, total dist. = 1047.84', Platted dist. = 1046.68 Overrun for this parcel = .06'.
The NW cor. of lot 14 falls 0.15' N. of the N. face of The N. sq. wood post at the West end of the School lot.
Surveyed by Lloyd S. Jensen Co. Sur. Dec. 1934

NAMES OF SWORN ASSISTANTS

CHAINMEN

FLAGMEN

AXMEN

