


No 590

Record of Survey.

BLOCK 19, ORIGINAL TOWN, EAST TROY

Township....., North of Range.....of 4 Principal Meridian
as presented by the courses and distances on the following plat, and annexed field-notes of survey:
Established the center of the section at the point of intersection of STRAIGHT quarter lines.
Established all quarter-quarter corners upon the section boundary at proportional distances between known section and quarter section corners, according to the original field-notes of the Government survey.
Established all lost corners at proportionate distances between known corners, according to the original field notes of the Government survey.

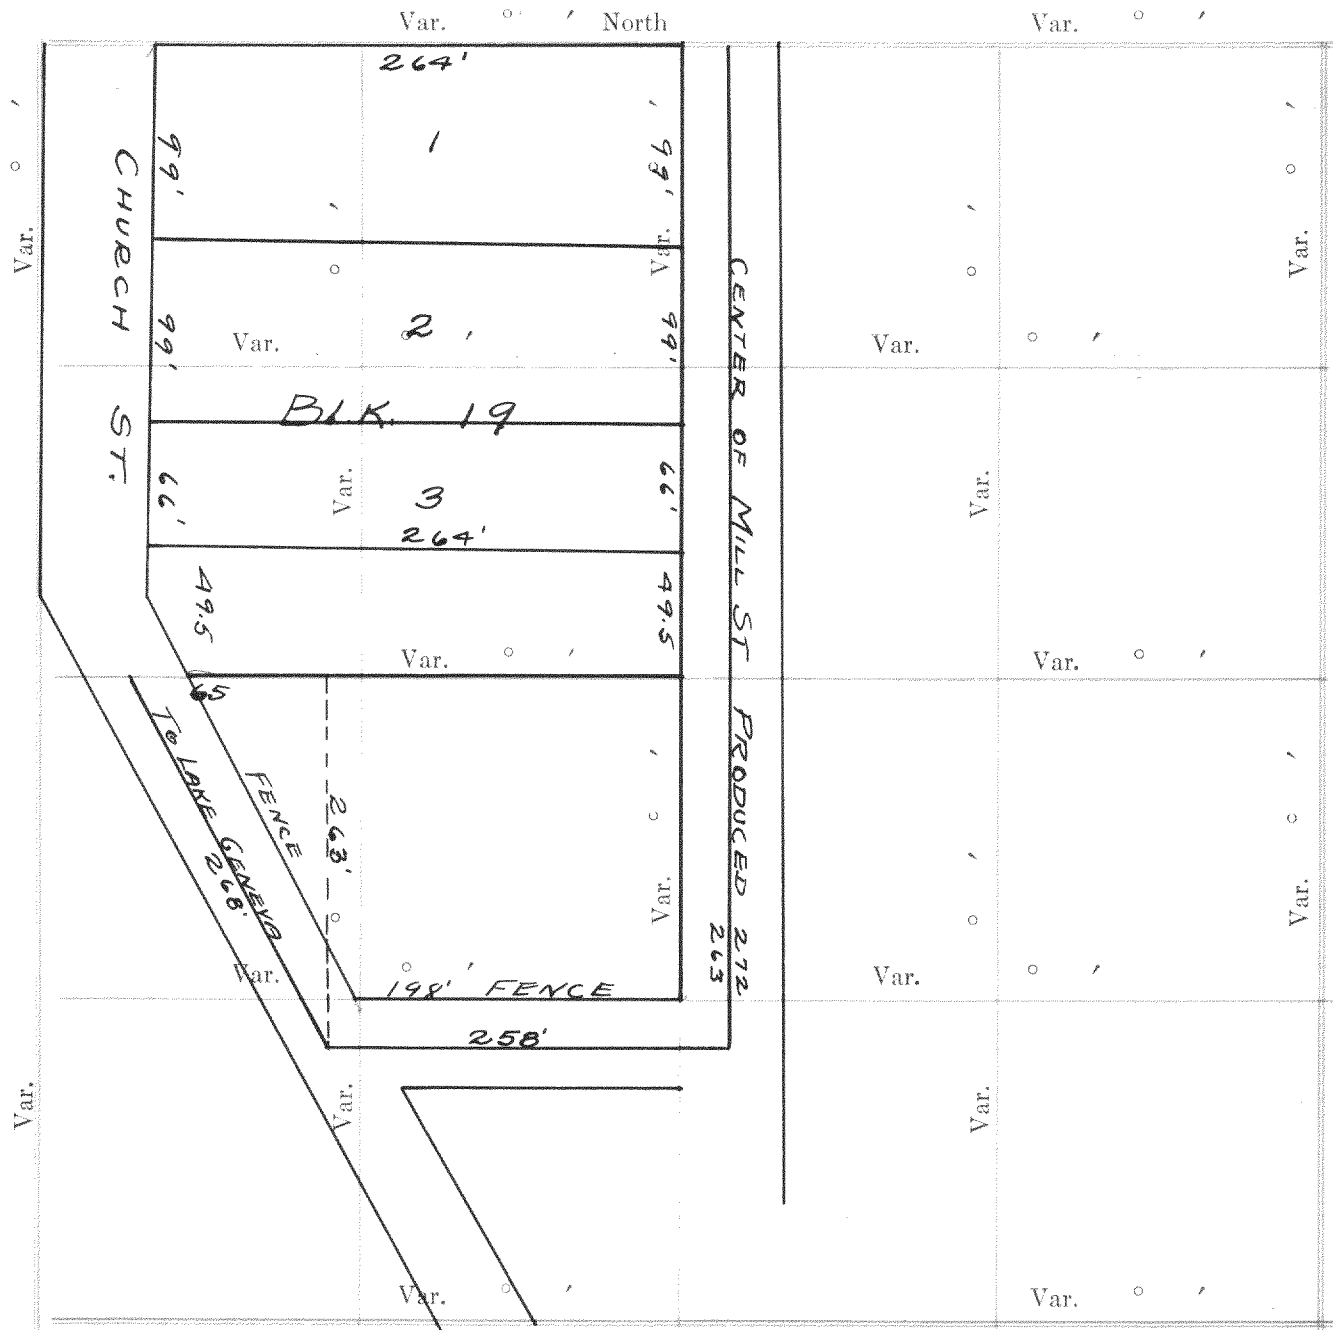

Plat of a survey of block 19 of the original town in the village of East Troy, Walworth County, Wis.

Declination of the Magnetic Meridian from the True Meridian.....
Surveyed and sub-divided.....
with the State Laws and Instructions of the Commissioner of the General Land office, and recorded on pages.....
.....of Register in the County Clerk's office.
Witness my hand this.....day of.....A. D. 1.....

Surveyed by Wm. Child, C.S.
Recorded by Lloyd C. Jensen
Co. Sur.

DESCRIPTION

OF SECTION, QUARTER SECTION AND QUARTER QUARTER SECTION CORNERS

H. C. MILLER CO., MFG. STATIONERS, MILWAUKEE X15000

GOVERNMENT CORNERS

Bearing	In.	Courses	Links	Bearing	In.	Courses	Links	Bearing	In.	Courses	Links	Bearing	In.	Courses	Links
Trees	Dia.	they bear	Distant	Trees	Dia.	they bear	Distant	Trees	Dia.	they bear	Distant	Trees	Dia.	they bear	Distant

No.

1. N. W. Sec. Cor. identified,
2. N. E. Sec. Cor. identified,
3. S. E. Sec. Cor. identified,
4. S. W. Sec. Cor. identified,

NO. 591 BLOCK 1, S.B. EDWARDS' ADDITION TO VILLAGE OF EAST TROY

5. N. $\frac{1}{4}$ Sec. Cor. identified,

6. E. $\frac{1}{4}$ Sec. Cor. identified,

7. S. $\frac{1}{4}$ Sec. Cor. identified,

8. W. $\frac{1}{4}$ Sec. Cor. identified,

Subdivision Corners

No.

1. Center $\frac{1}{4}$ Sec. Cor.
2. North $\frac{1}{4}$ - $\frac{1}{4}$ s N. W. qr.,
3. East $\frac{1}{4}$ - $\frac{1}{4}$ s N. W. qr.,
4. South $\frac{1}{4}$ - $\frac{1}{4}$ s N. W. qr.,
5. West $\frac{1}{4}$ - $\frac{1}{4}$ s N. W. qr.,
6. Center $\frac{1}{4}$ - $\frac{1}{4}$ s N. W. qr.,
7. North $\frac{1}{4}$ - $\frac{1}{4}$ s N. E. qr.,
8. East $\frac{1}{4}$ - $\frac{1}{4}$ s N. E. qr.,
9. South $\frac{1}{4}$ - $\frac{1}{4}$ s N. E. qr.,
10. Center $\frac{1}{4}$ - $\frac{1}{4}$ s N. E. qr.,

11. East $\frac{1}{4}$ - $\frac{1}{4}$ s S. E. qr.,

12. South $\frac{1}{4}$ - $\frac{1}{4}$ s S. E. qr.,

13. West $\frac{1}{4}$ - $\frac{1}{4}$ s S. E. qr.,

14. Center $\frac{1}{4}$ - $\frac{1}{4}$ s S. E. qr.,

15. South $\frac{1}{4}$ - $\frac{1}{4}$ s S. W. qr.,

16. West $\frac{1}{4}$ - $\frac{1}{4}$ s S. W. qr.,

17. Center $\frac{1}{4}$ - $\frac{1}{4}$ s S. W. qr.

Plat of a survey in Block 1 of
S. B. Edwards Addition to the
Village of East Troy

Surveyed by Wm. Child, C.S.
Recorded by Lloyd V. Furman


Plat of a survey in Block 1 of S. B. Edwards Addition to the Village of East Troy

Surveyed by Wm. Child, C.S.
Recorded by Lloyd C. Jensen
Co. Sur.

NAMES OF SWORN ASSISTANTS

CHAINMEN				FLAGMEN				AXMEN			

No. 592. BLOCK 118, LAKE WANDAWEGA SUB.
IN SEC. 1, T3N, R 16E

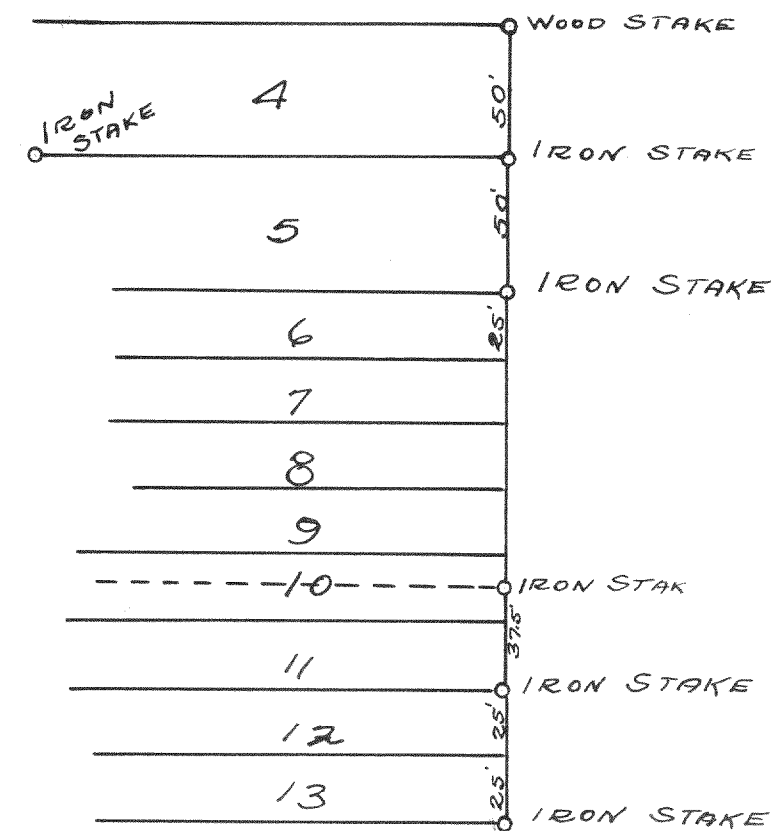


118 Plat of a survey of lot 5 in blocks
of Wandawega Subdivision.

Feb. 2, 1935

Lloyd V. Jensen
Co. Sur.

No. 593 PART OF LOTS 4, 5, 46 OF BLOCK 8
ORIGINAL TOWN OF DARIEN.

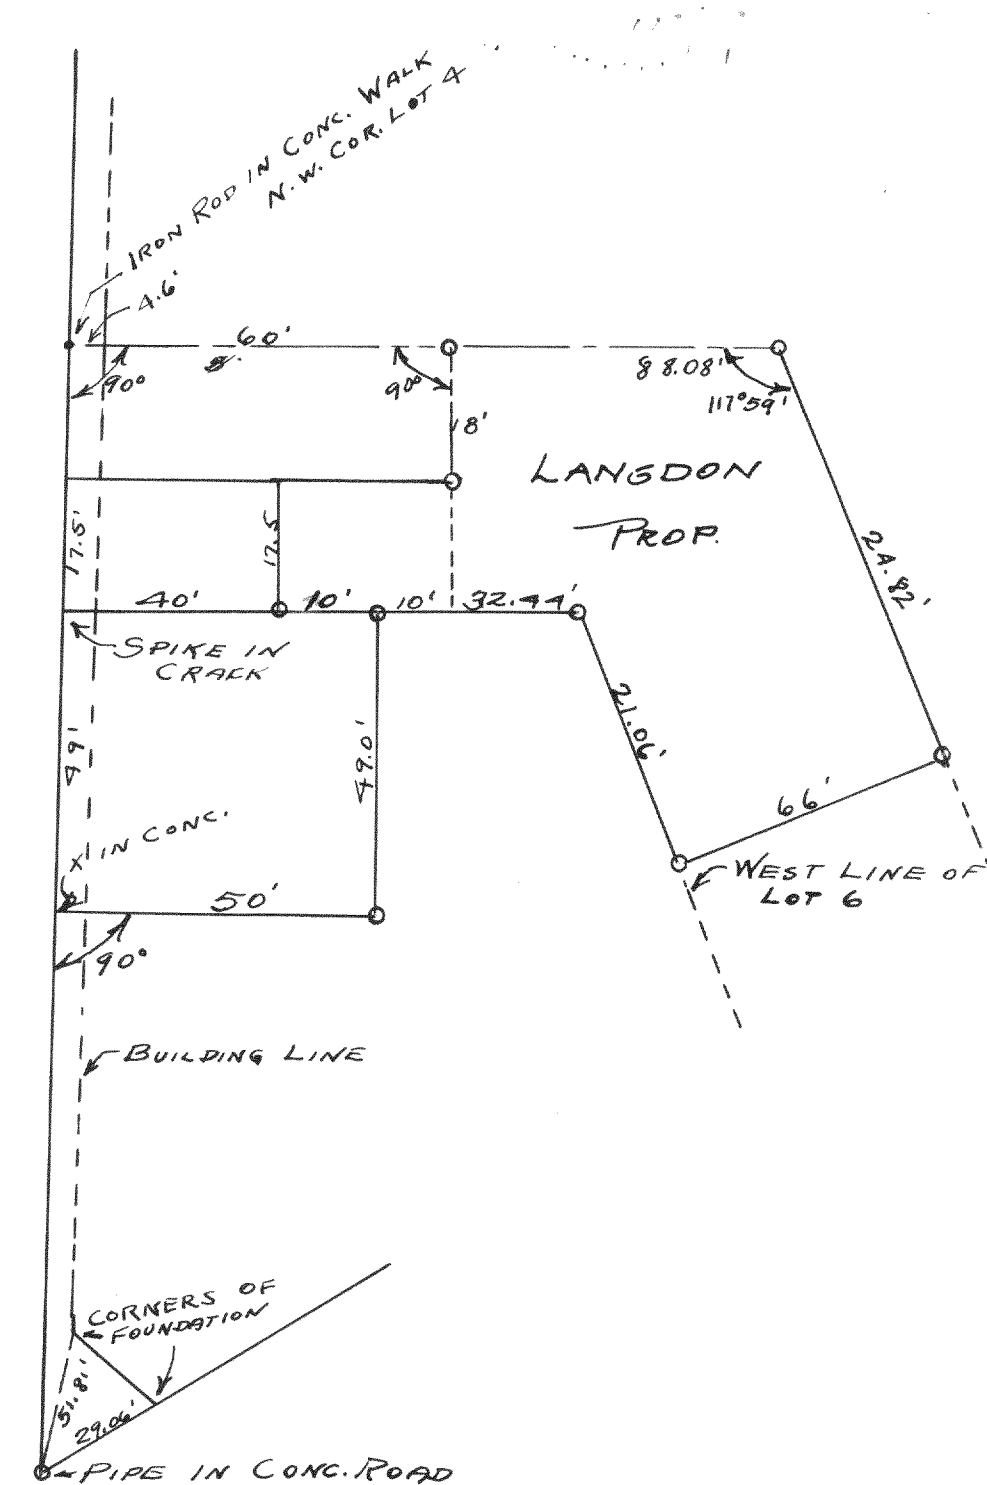

Plat of a survey of Langdon Property
in Block 8 of Original Town of Darien

Jan. 11, 1934

Lloyd P. Jensen
Co. Enr.