


No. 44

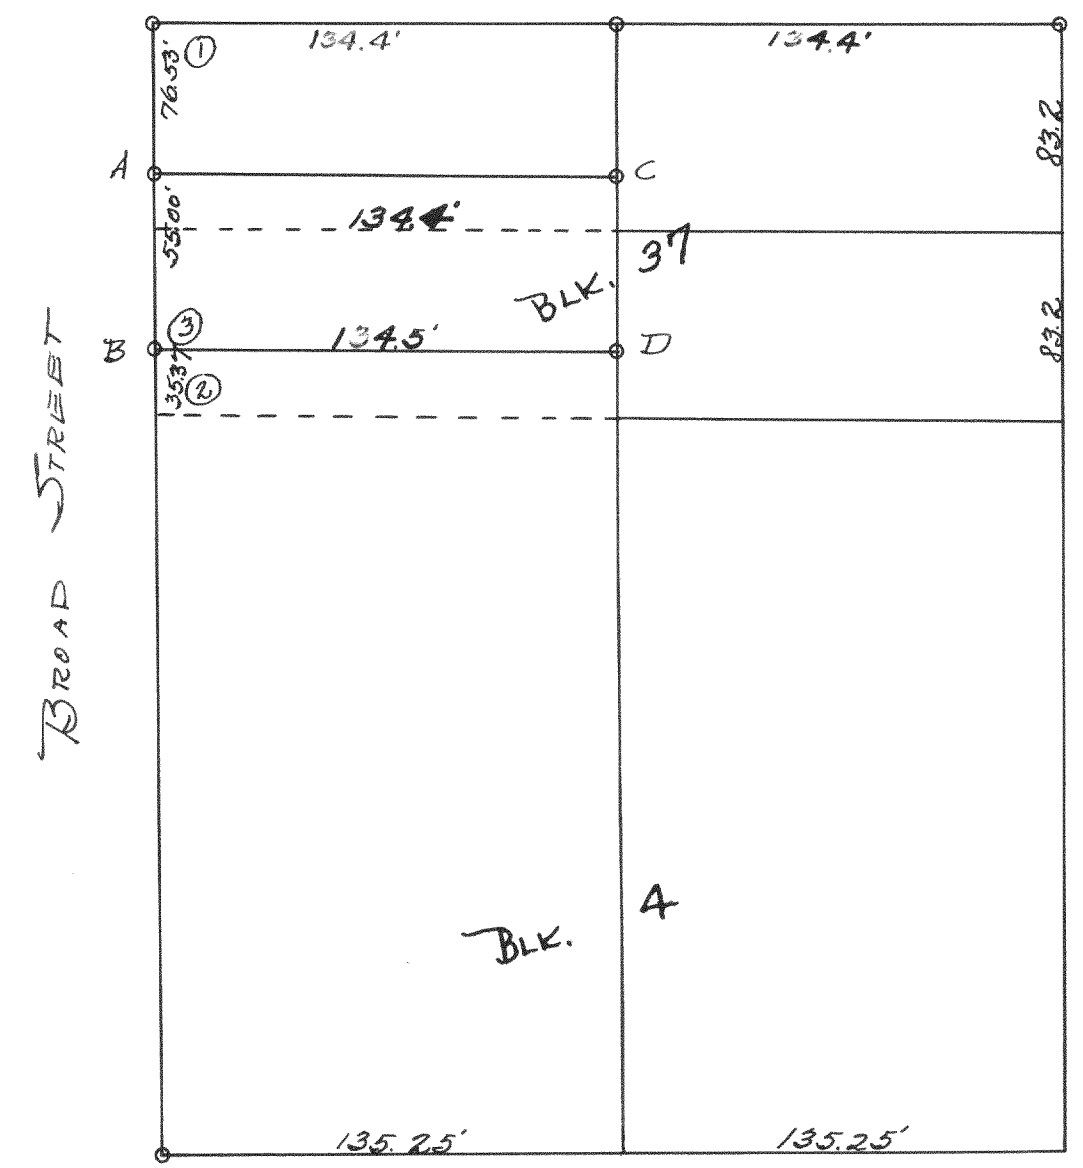

Survey of a 55 foot lot in Block 37 of Davis Add.
Location - Sec. 36, T3N, R16E.

Used figured ^{ap} from the plat book of the City of Elkhorn as compiled by City Engineer Mr. Gable.

Sighted in S.W. cor. of Block 4 of original town turned angle of $90^{\circ}04'$ and sighted iron pin at NE. cor. of blk. 37.

Angle ② = $89^{\circ}55'$

Angle ③ = $89^{\circ}55'$


Set iron pipes at A, B, C & D.

Lot owned by Mrs Peter Luves, Elkhorn, Wisconsin

FEB 19, 1933 Survey Floyd S. Jensen

Recorded March 18, 1933. County Surveyor

No. 45

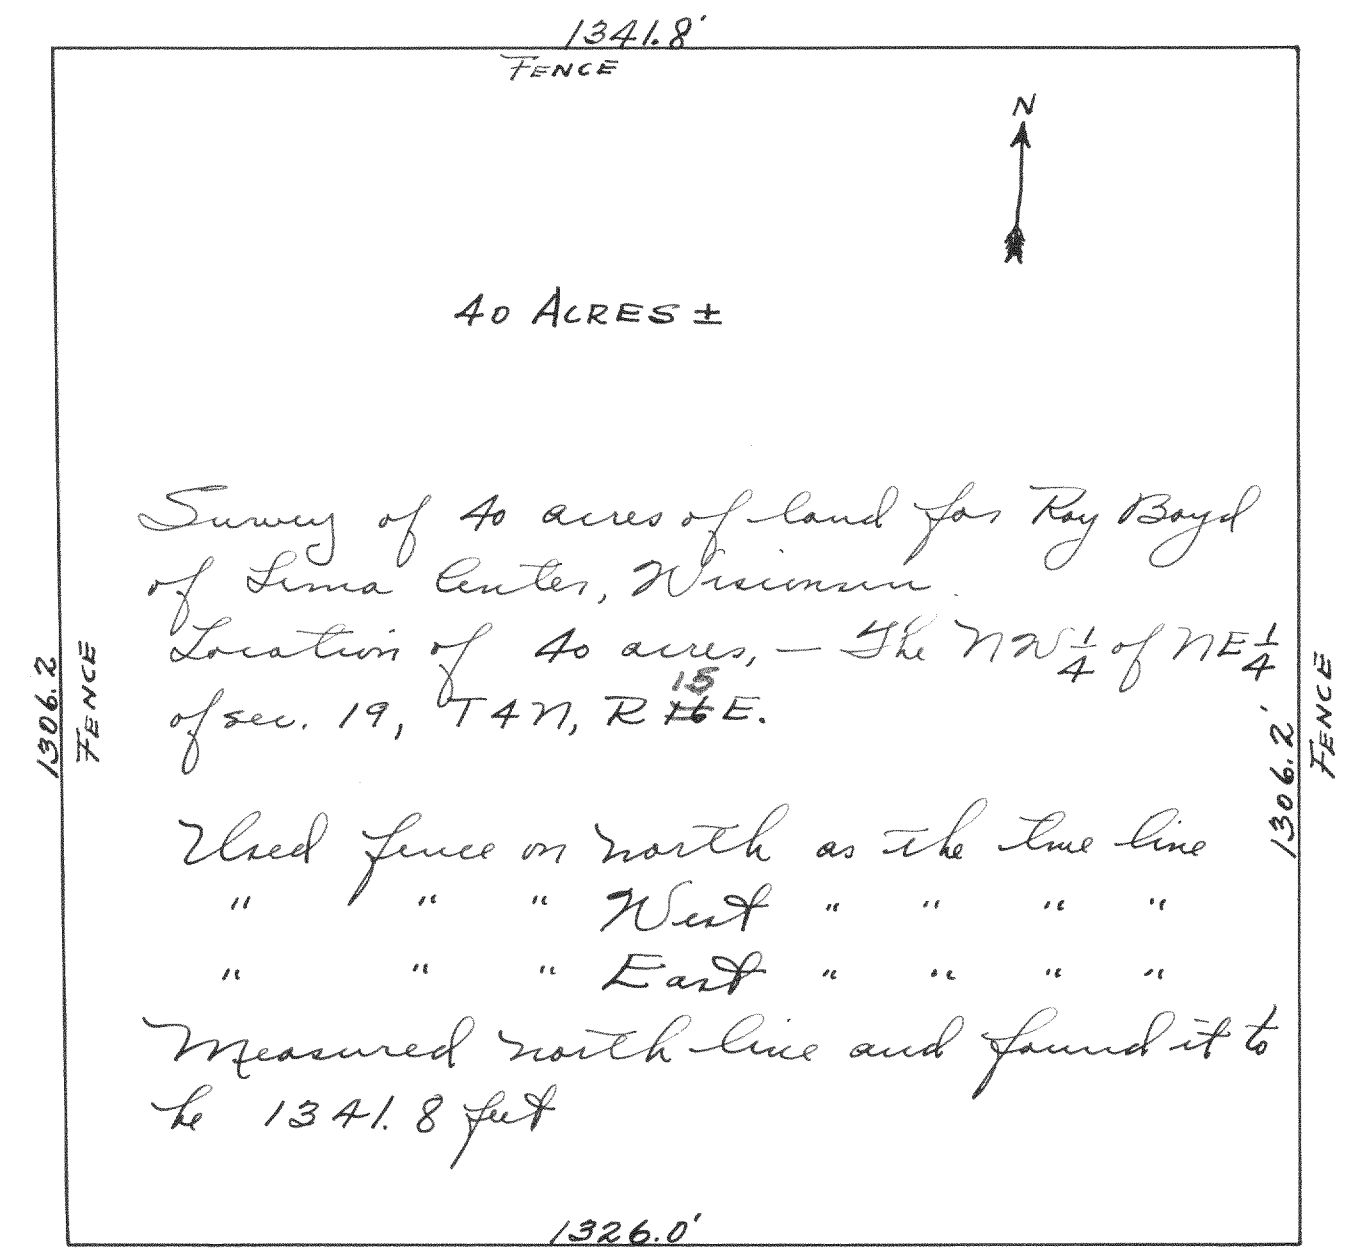

Survey of 40 acres of land for Ray Boyd of Lima Center, Wisconsin.
Location of 40 acres, - The NW $\frac{1}{4}$ of NE $\frac{1}{4}$ of sec. 19, T4N, R15E.

Used fence on north as the true line
" " " West " " " "
" " " East " " " "

Measured north line and found it to be 1341.8 feet

Measured south line at 80 rods from north fence and found it to be 1326.0 feet in length.

$$\begin{array}{r} 1341.8 \\ 1326.0 \\ 2 \overline{) 2667.8} \\ 1333.9 \end{array}$$

$$43560 \times 40 \div 1333.9 = 1306.2 = \text{the length of the East \& West lines of the 40 acres.}$$

Both, buyer Mr. Henry Duka and seller Mr. Ray Boyd were present and were satisfied with the above method.

March 3, 1933

Floyd S. Jensen
County Surveyor.