


No. 611 BLOCK 4 OF PASSAGE-ARAM-DOWNIE'S ADD.

CITY OF DELAVAN

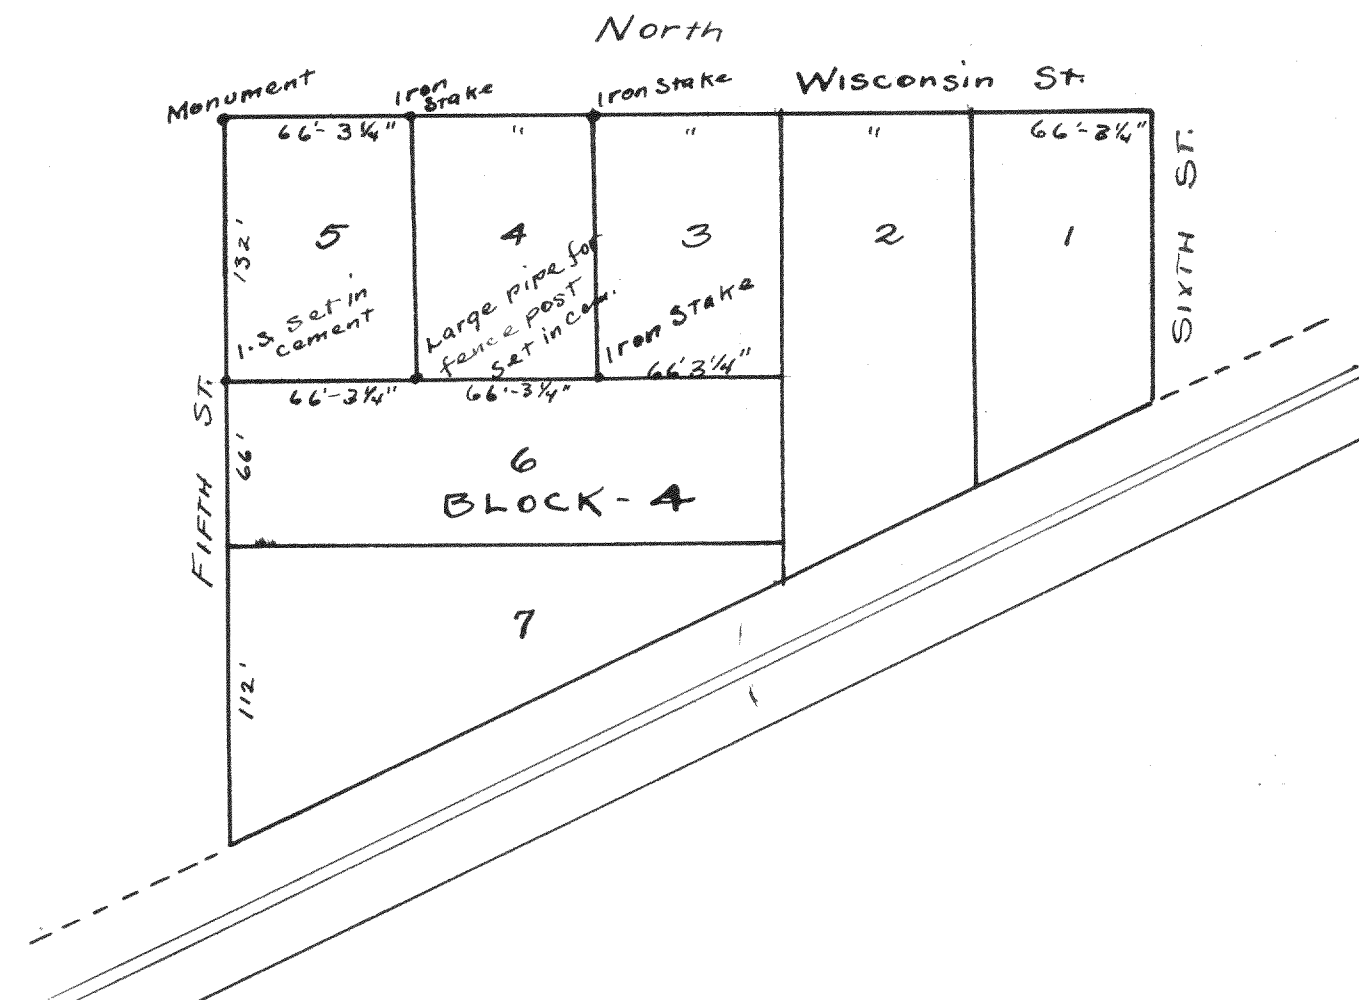


Plat of a survey made by the direction of
Thos. J. Sorenson of Delavan to locate the corners
of Lots 4 & 5 of Block 4 of Passage Aram-Downie's
Addition in the City of Delavan, Walworth County,
Wisconsin. The lines of the block were run according
to the Monuments set by the City Engineer, and
I find in the North line of the Block an overrun
of 17" (or 14") giving each lot 66' 3 1/4" in width.
Survey made April 24th 1931

Wm. CHILD
County Surveyor

Recorded by Lloyd S. Jensen
Co. Sur.

612- N.E. 1/4 Sec. 26, T4N, R17E

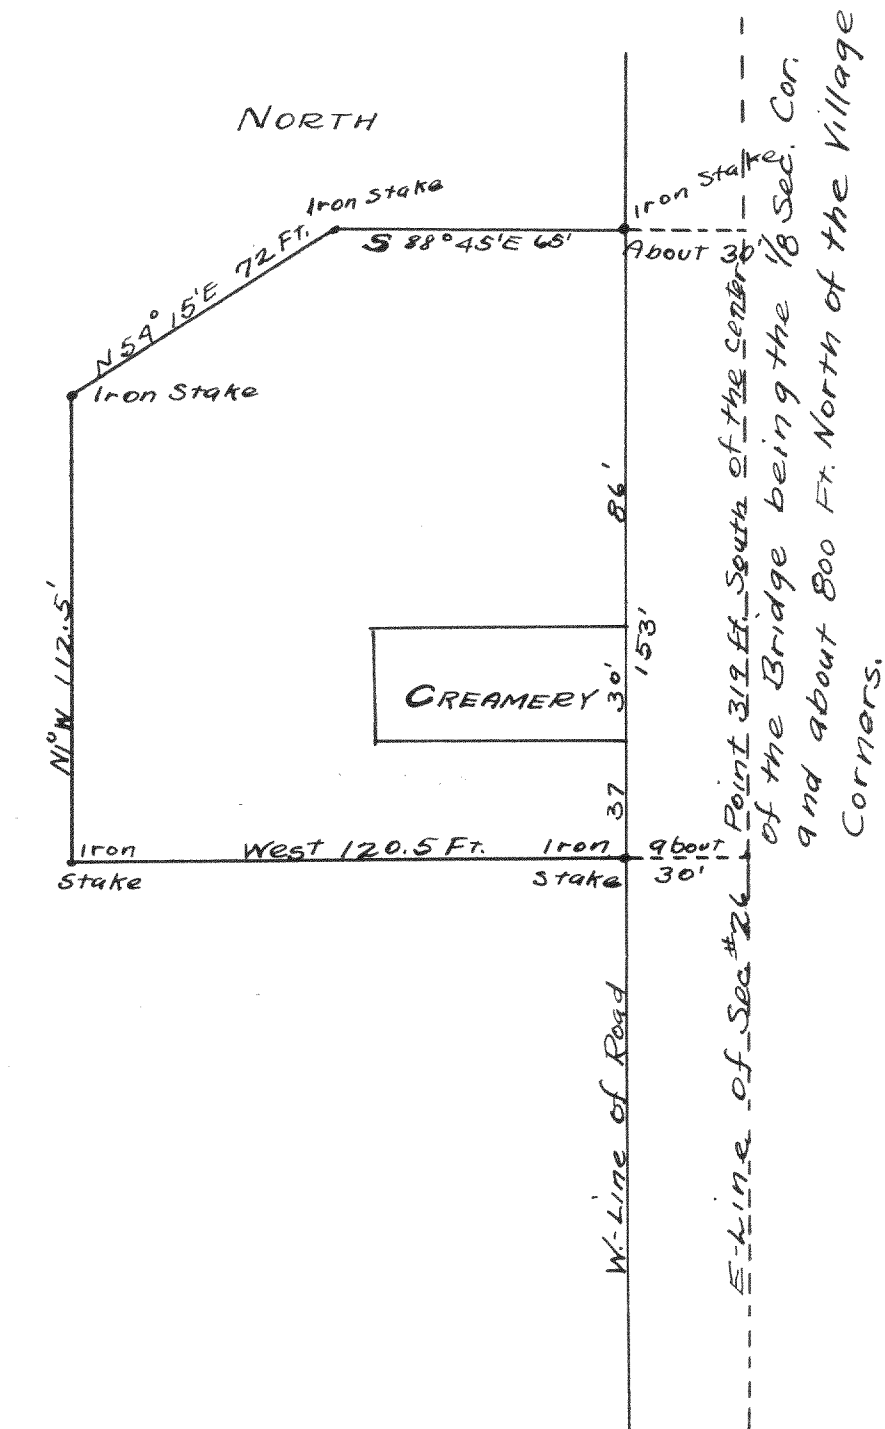

Plat of the property of the Jansen
Creamery Company located in the North
East Quarter of Sec. No. 26, Town No. 4
North, Range No. 17 East being the Town
of Troy, Walworth County, Wisconsin.
ELKHORN - Dec. 5, 1925

Wm. Child
Co. Surveyor

Recorded by Lloyd S. Jensen
Co. Sur.