


Record of Survey.

Township....., North of Range.....of 4 Principal Meridian
as presented by the courses and distances on the following plat, and annexed field-notes of survey:
Established the center of the section at the point of intersection of STRAIGHT quarter lines.
Established all quarter-quarter corners upon the section boundary at proportional distances between known section and quarter section corners, according to the original field-notes of the Government survey.
Established all lost corners at proportionate distances between known corners, according to the original field notes of the Government survey.

no. 640

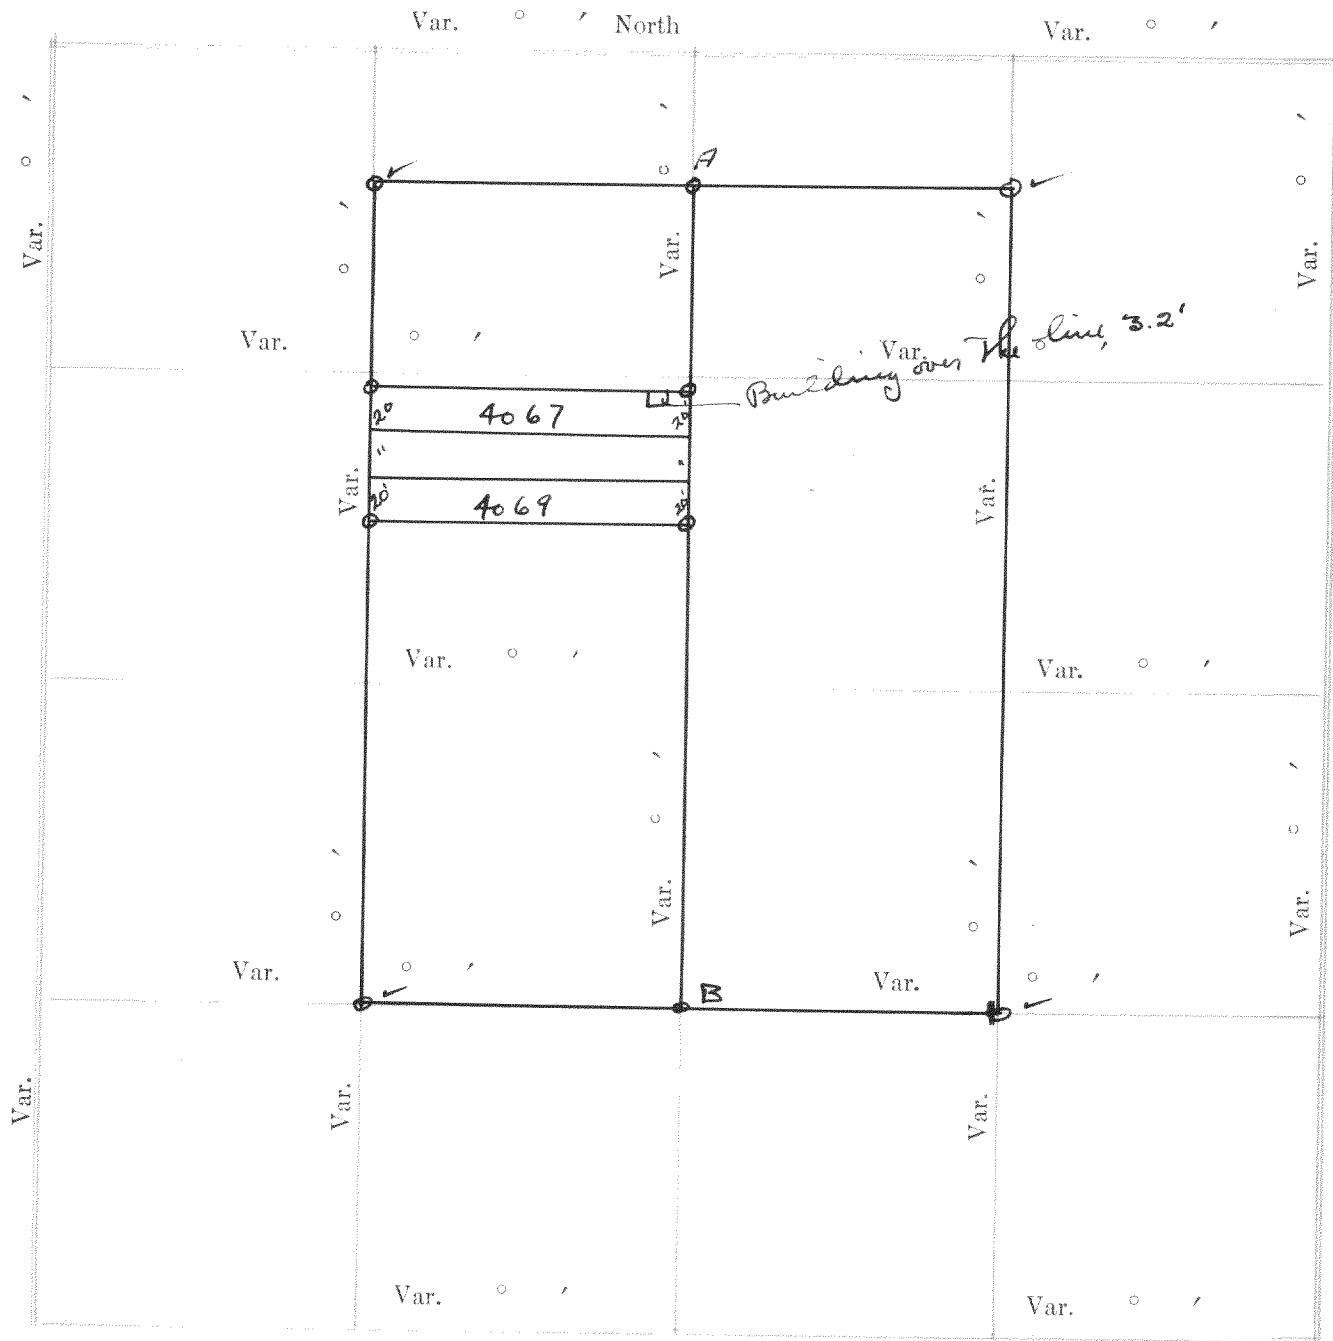

Plat of Section....., Township.....North, Range.....of 4 Principal Meridian Scale
80 chains to 6 inches. The figures in red ink are the lengths of the lines as stated in the field-notes of the
Government survey.

Declination of the Magnetic Meridian from the True Meridian.....
Surveyed and sub-divided.....A. D. 1, in accordance
with the State Laws and Instructions of the Commissioner of the General Land office, and recorded on pages
.....of Register in the County Clerk's office.

Witness my hand this.....day of.....A. D. 1

.....SURVEYOR.

DESCRIPTION

209

OF SECTION, QUARTER SECTION AND QUARTER QUARTER SECTION CORNERS

GOVERNMENT CORNERS

Bearing In. Courses Links Bearing In. Courses Links Bearing In. Courses Links Bearing In. Courses Links
Trees Dia. they bear Distant Trees Dia. they bear Distant Trees Dia. they bear Distant Trees Dia. they bear Distant

No.

1. N. W. Sec. Cor. identified,
2. N. E. Sec. Cor. identified,
3. S. E. Sec. Cor. identified,
4. S. W. Sec. Cor. identified,
5. N. $\frac{1}{4}$ Sec. Cor. identified,
6. E. $\frac{1}{4}$ Sec. Cor. identified,
7. S. $\frac{1}{4}$ Sec. Cor. identified,
8. W. $\frac{1}{4}$ Sec. Cor. identified,

Subdivision Corners

No.

1. Center $\frac{1}{4}$ Sec. Cor.
2. North $\frac{1}{4}$ - $\frac{1}{4}$ s N. W. qr.,
3. East $\frac{1}{4}$ - $\frac{1}{4}$ s N. W. qr.,
4. South $\frac{1}{4}$ - $\frac{1}{4}$ s N. W. qr.,
5. West $\frac{1}{4}$ - $\frac{1}{4}$ s N. W. qr.,
6. Center $\frac{1}{4}$ - $\frac{1}{4}$ s N. W. qr.,
7. North $\frac{1}{4}$ - $\frac{1}{4}$ s N. E. qr.,
8. East $\frac{1}{4}$ - $\frac{1}{4}$ s N. E. qr.,
9. South $\frac{1}{4}$ - $\frac{1}{4}$ s N. E. qr.,
10. Center $\frac{1}{4}$ - $\frac{1}{4}$ s N. E. qr.,
11. East $\frac{1}{4}$ - $\frac{1}{4}$ s S. E. qr.,
12. South $\frac{1}{4}$ - $\frac{1}{4}$ s S. E. qr.,
13. West $\frac{1}{4}$ - $\frac{1}{4}$ s S. E. qr.,
14. Center $\frac{1}{4}$ - $\frac{1}{4}$ s S. E. qr.,
15. South $\frac{1}{4}$ - $\frac{1}{4}$ s S. W. qr.,
16. West $\frac{1}{4}$ - $\frac{1}{4}$ s S. W. qr.,
17. Center $\frac{1}{4}$ - $\frac{1}{4}$ s S. W. qr.

Survey of lots 4067 - 4069 of Section 3 of
Pell Lake.

Set iron pipes at points marked (o)

June 24, 1935

Lloyd S. Jensen
County Surveyor

Found pipes at points marked (o) ✓
Set points at A & B to be used in the survey.

Survey of lots 4067 - 4069 of Section 3 of
Pell Lake.
Set iron pipes at points marked (o)

June 24, 1935

Lloyd S. Jensen
County Surveyor

Found pipes at points marked (o) ✓
Set points at A & B to be used in the survey.


NAMES OF SWORN ASSISTANTS

CHAINMEN

FLAGMEN

AXMEN

no. 641. Survey of lot 15, Block 56 of the 4th map of Interlaken, for L. J. Morris.

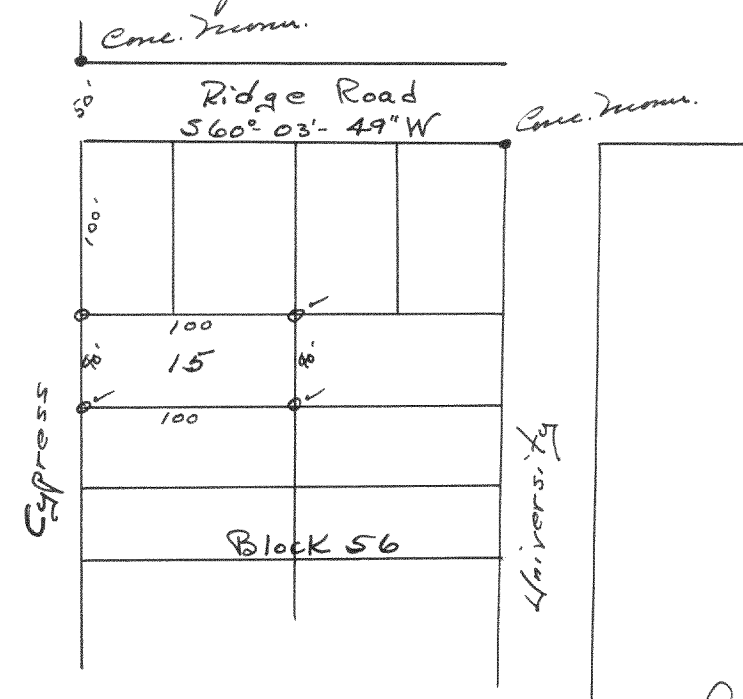


Found iron pipes at points marked (o) ✓
Placed iron pipes at " " " o

July 7, 1935

Lloyd S. Jensen
County Surveyor

no. 642

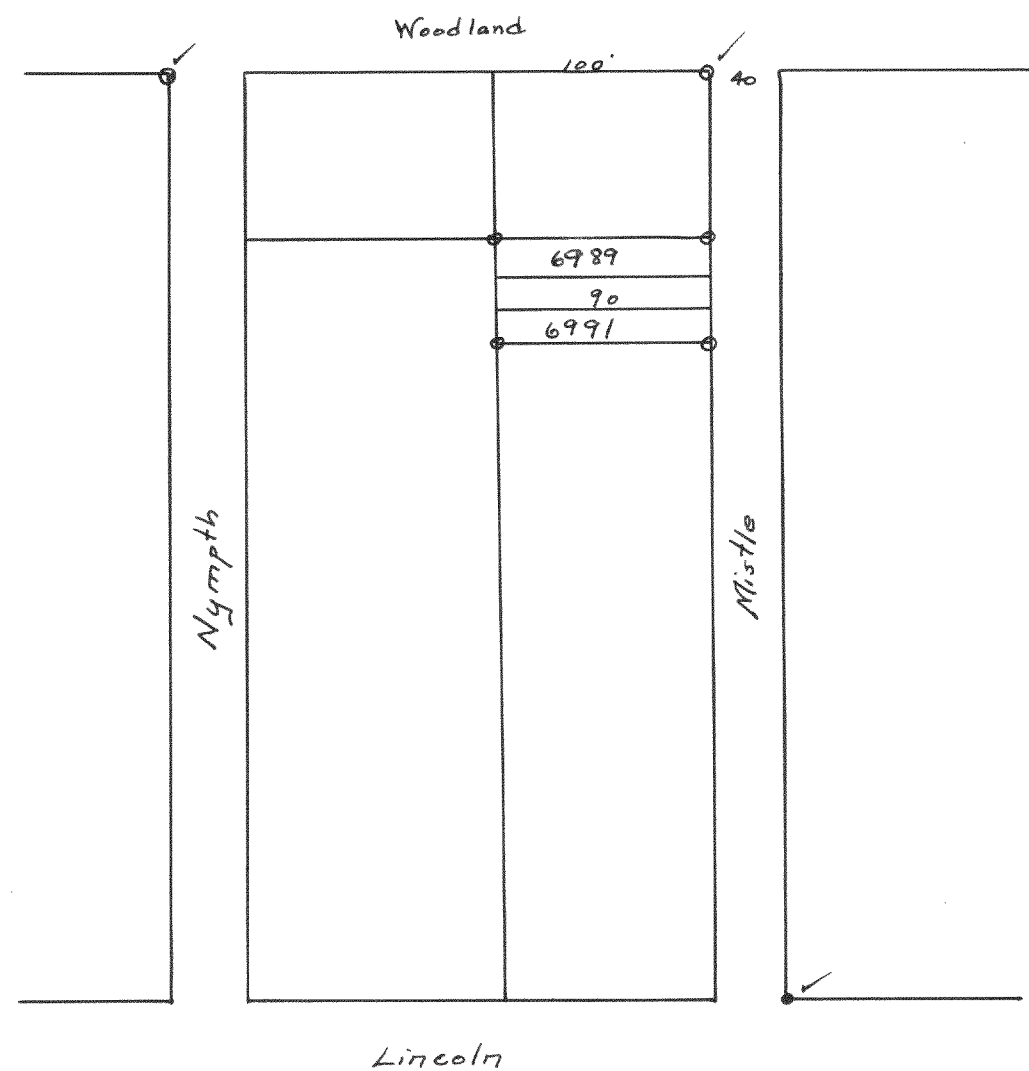

Survey of lots 6989-6991 inclusive of Block 120 of the First map of Lake Como Beach.

Iron pipes found at points marked o ✓
" " placed " " " o

Date of survey July 6, 1935

Lloyd S. Jensen
County Surveyor