


Record of Survey.

DESCRIPTION

OF SECTION, QUARTER SECTION AND QUARTER QUARTER SECTION CORNERS

No. 48

Township....., North of Range..... of 4 Principal Meridian
as presented by the courses and distances on the following plat, and annexed field-notes of survey:
Established the center of the section at the point of intersection of straight quarter lines.
Established all quarter-quarter corners upon the section boundary at proportional distances between known section and quarter section corners, according to the original field-notes of the Government survey.
Established all lost corners at proportionate distances between known corners, according to the original field notes of the Government survey.

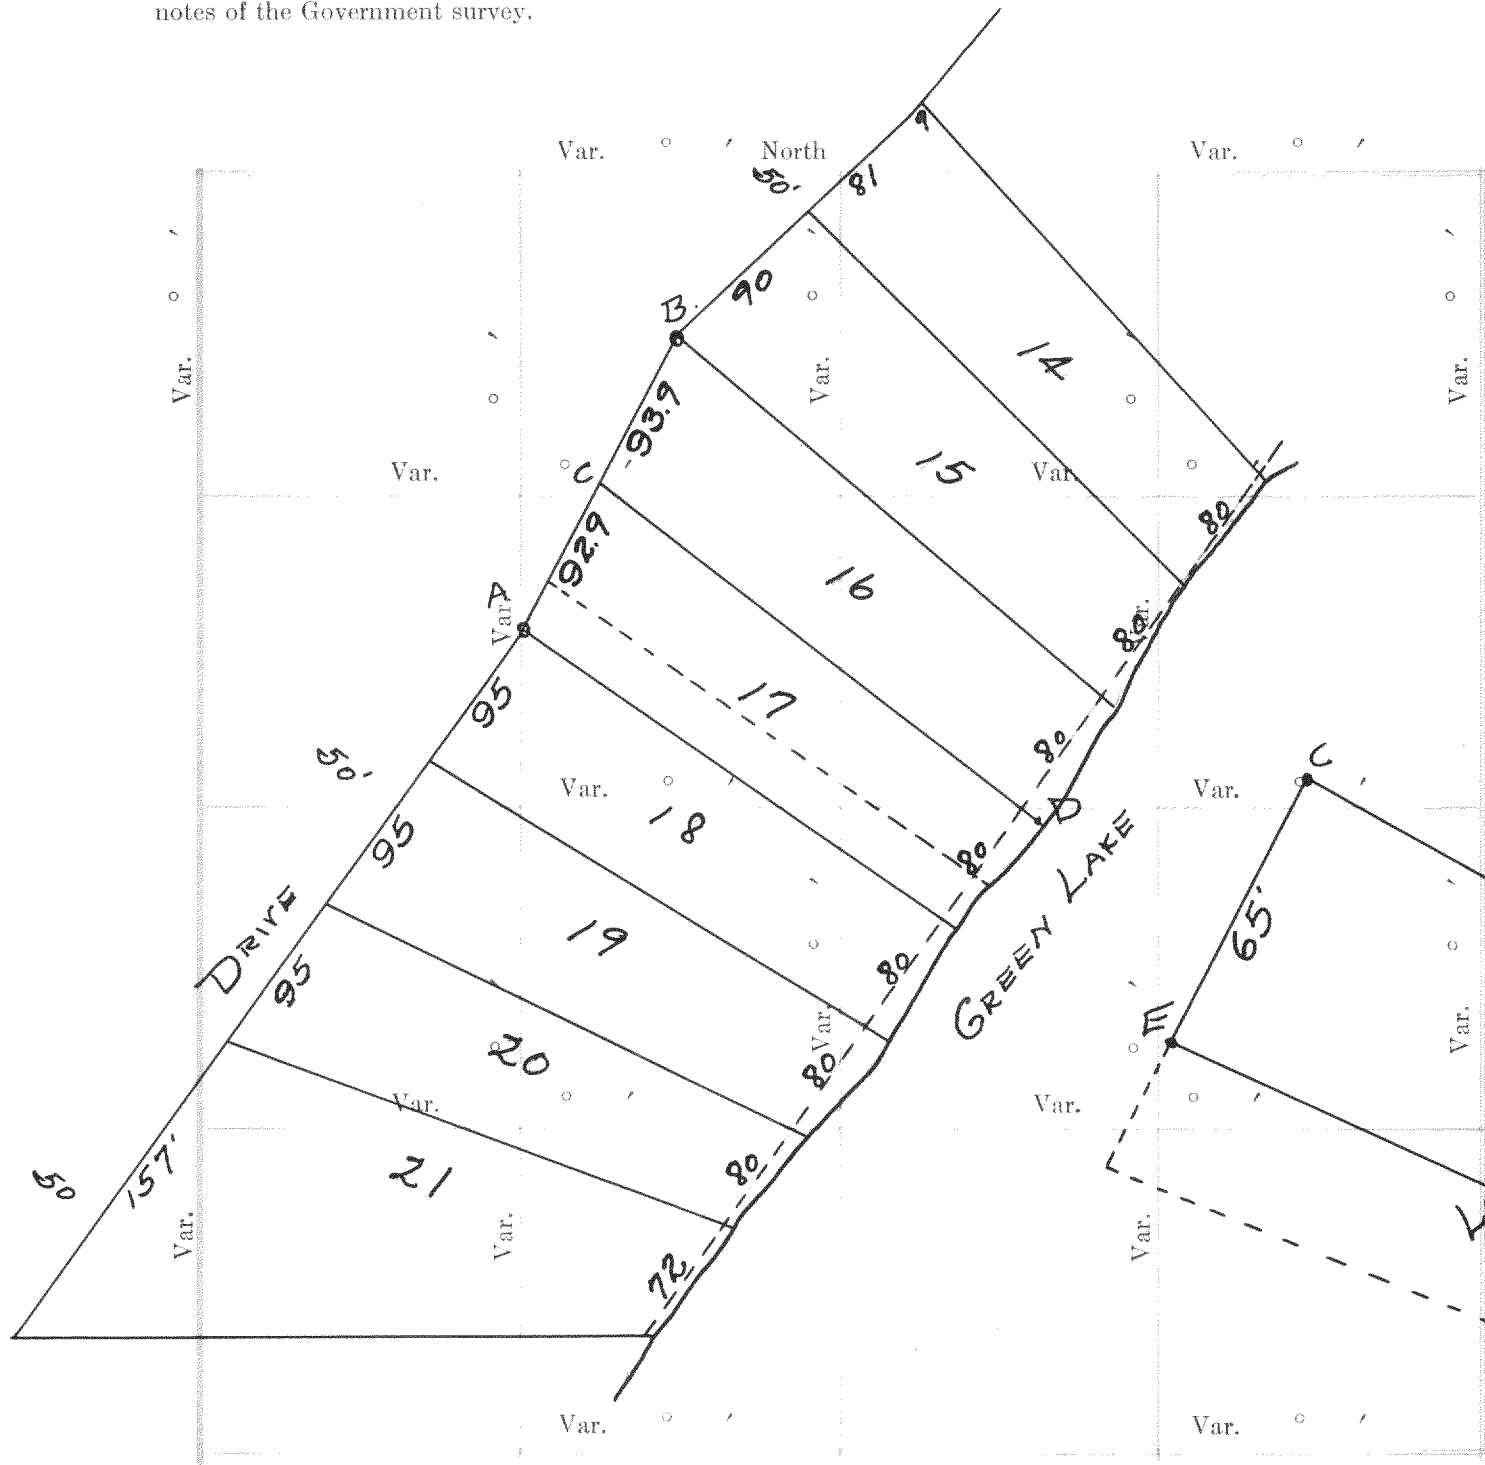

Plat of Section....., Township..... North, Range..... of 4 Principal Meridian Scale
80 chains to 6 inches. The figures in red ink are the lengths of the lines as stated in the field-notes of the
Government survey.

Declination of the Magnetic Meridian from the True Meridian.....
Surveyed and sub-divided..... A. D. 1 , in accordance
with the State Laws and Instructions of the Commissioner of the General Land office, and recorded on pages
..... of Register in the County Clerk's office.

Witness my hand this..... day of..... A. D. 1

..... SURVEYOR.

- GOVERNMENT CORNERS
- No. 1. N. W. Sec. Cor. identified,
 - 2. N. E. Sec. Cor. identified,
 - 3. S. E. Sec. Cor. identified,
 - 4. S. W. Sec. Cor. identified,
 - 5. N. $\frac{1}{4}$ Sec. Cor. identified,
 - 6. E. $\frac{1}{4}$ Sec. Cor. identified,
 - 7. S. $\frac{1}{4}$ Sec. Cor. identified,
 - 8. W. $\frac{1}{4}$ Sec. Cor. identified,
- Subdivision Corners
- No. 1. Center $\frac{1}{4}$ Sec. Cor.,
 - 2. North $\frac{1}{4}$ - $\frac{1}{4}$ s N. W. qr.,
 - 3. East $\frac{1}{4}$ - $\frac{1}{4}$ s N. W. qr.,
 - 4. South $\frac{1}{4}$ - $\frac{1}{4}$ s N. W. qr.,
 - 5. West $\frac{1}{4}$ - $\frac{1}{4}$ s N. W. qr.,
 - 6. Center $\frac{1}{4}$ - $\frac{1}{4}$ s N. W. qr.,
 - 7. North $\frac{1}{4}$ - $\frac{1}{4}$ s N. E. qr.,
 - 8. East $\frac{1}{4}$ - $\frac{1}{4}$ s N. E. qr.,
 - 9. South $\frac{1}{4}$ - $\frac{1}{4}$ s N. E. qr.,
 - 10. Center $\frac{1}{4}$ - $\frac{1}{4}$ s N. E. qr.,
 - 11. East $\frac{1}{4}$ - $\frac{1}{4}$ s S. E. qr.,
 - 12. South $\frac{1}{4}$ - $\frac{1}{4}$ s S. E. qr.,
 - 13. West $\frac{1}{4}$ - $\frac{1}{4}$ s S. E. qr.,
 - 14. Center $\frac{1}{4}$ - $\frac{1}{4}$ s S. E. qr.,
 - 15. South $\frac{1}{4}$ - $\frac{1}{4}$ s S. W. qr.,
 - 16. West $\frac{1}{4}$ - $\frac{1}{4}$ s S. W. qr.,
 - 17. Center $\frac{1}{4}$ - $\frac{1}{4}$ s S. W. qr.

Bearing	In.	Courses	Links	Bearing	In.	Courses	Links	Bearing	In.	Courses	Links
Trees	Dia.	they bear	Distant	Trees	Dia.	they bear	Distant	Trees	Dia.	they bear	Distant

Survey of 1/4 lot 17 of Morris Park, T4N, R16E
Located iron pipes at pts A & B as set by former
County Surveyor Mr. Child. Sighted between these
two pts & set pt. C which is a pipe set in concrete
Looked for the base line on the shore but could
find no evidence of stakes. Measured the distance from
a map to locate the approximate position of iron
lots 14, 15 & 16. Measured 240 feet & this measurement
checked within .08 our N. line of lot 17 using pt C &
the SE. fence post on east fence post toward the lake
between lots 16 & 17.
In locating the N. line of lot 17 I used pt C &
the E. of the fence post, this locates pt D .08' N of
the last house wall. It is an iron pin in concrete.
Measuring on the approximate base line
55 feet more & located pt E line of Mrs.
Forester's lot.
Measured 65' 5 from C and located pt E.
G & H are markers about midway on the lot.
All markers are iron pins or pipes in concrete, set
flush with the ground.
Surveyed March 7 & 9, 1933
Floyd J. Jensen
County Surveyor


NAMES OF SWORN ASSISTANTS

CHAINMEN

FLAGMEN

AXMEN

No. 49

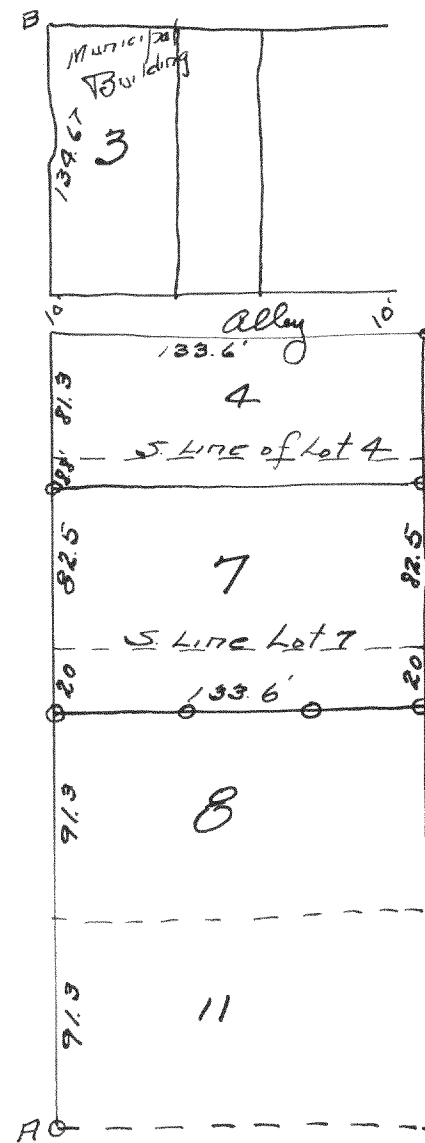


Survey of Sylvia Gray Estate in Block 26, original town of Elkhorn

Description of parcel surveyed
Beginning at a pt. 82.5 N. of the SE. cor. of Lot 7, Block 26 of the original town of Elkhorn, Walworth Co. Wisconsin, thence West parallel with the S. line of Lot 7 to a pt. on the West line of Lot 7 82.5 feet N. of the S.W. cor. of Lot 7, thence South 102.5 feet to a pt. 20' S. of the S.W. cor. of Lot 7, thence E to a pt. on the E. line of Lot 8, 20 feet South of the SE. cor. of Lot 7, thence North 102.5 feet to the place of beginning. Found iron pipe at A about 2' under surface. At B. the block cor. is a cross set in the side walk, both have been placed by Mr. Tabbs, City Engineer of Elkhorn.

Dec. 9, 1933

Floyd S. Jensen
Co. Sur.

No. 50

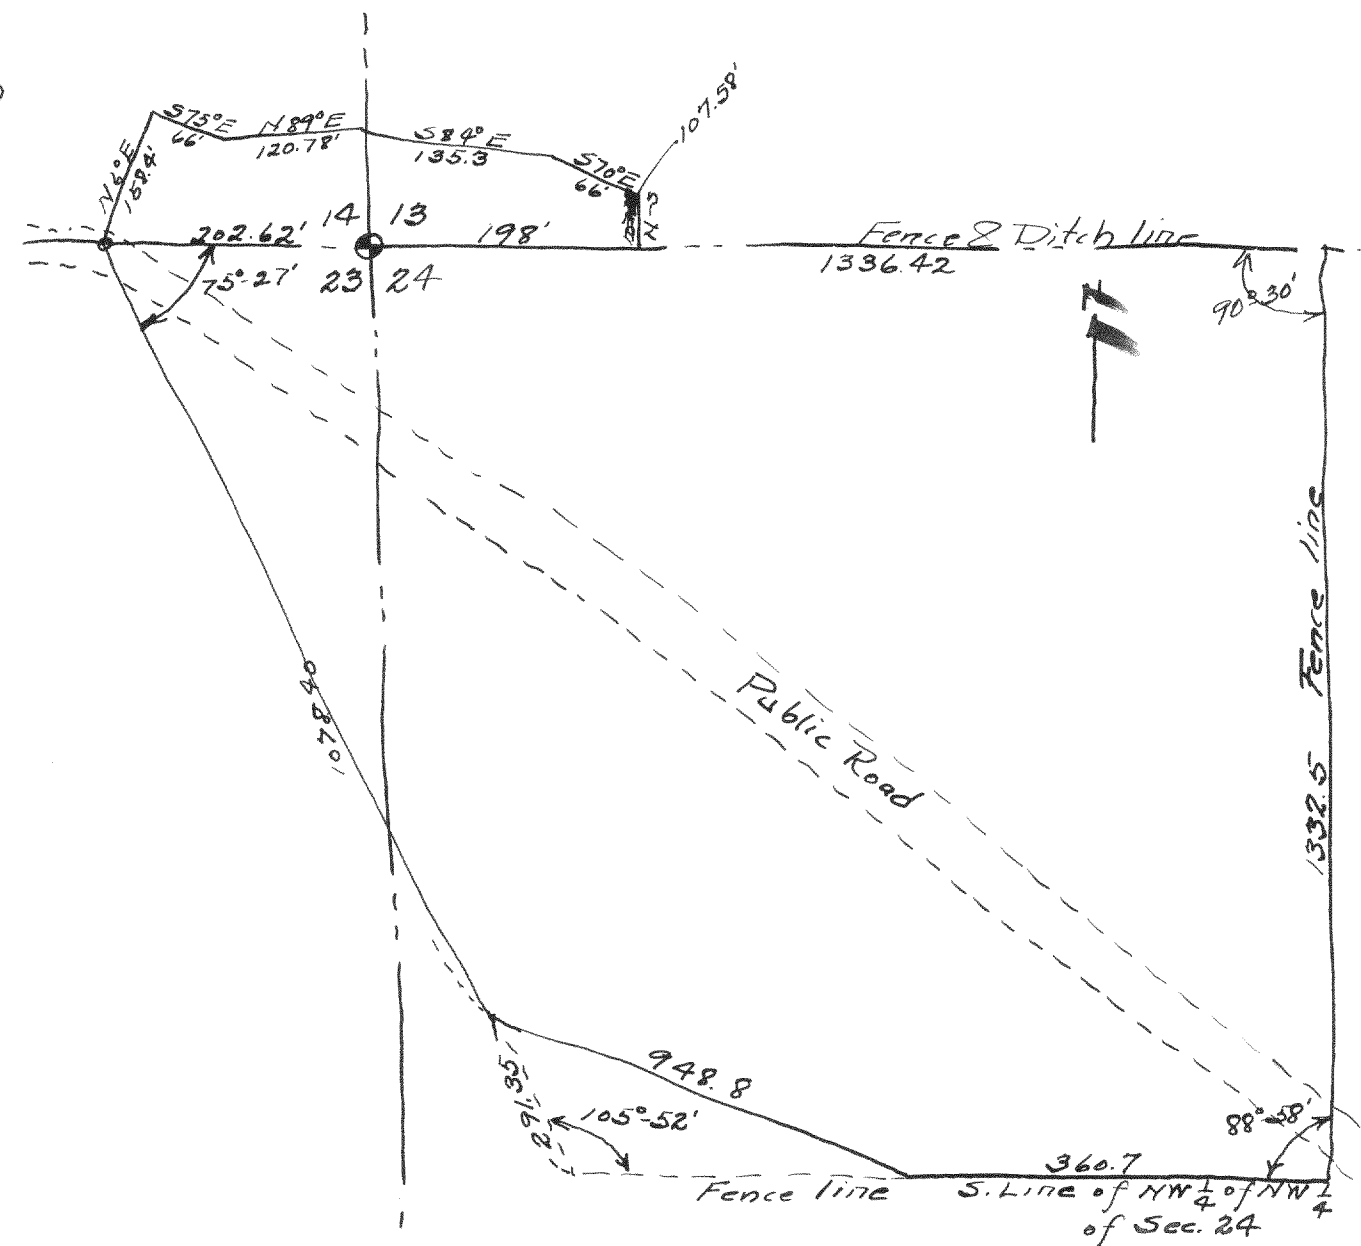

Survey of Frank B. Reist Dr. Amestrad located in Sections 13, 14, 23 & 24 of T4N, R18E.

Description:

Commencing at the sec. cor. common to sections 13, 14, 23 & 24 of T4N, R18E; thence N. 202.62 feet to an iron pipe, which is the place of beginning; thence S 14° 33' E, 1078.40' to an iron pipe; thence Southeast by 948.80' to a pt. 360.7' West of the SE. corner of NW 1/4 of NW 1/4 of Section 24, thence E. 360.7'; thence N. 1332.5' to a pt. in the E. of the drainage ditch, thence W. 1138.42' to a pt., thence N. 107.58' thence N 70° W 66'; thence N 84° W 135.3'; thence S 89° W 120.78'; thence N 75° W 66'; thence S 6° W 158.4' to the place of beginning - containing 40 acres of land.

Found evidence of old stake at sec. cor. 13, 14, 23 & 24, and placed Iron Pipe in its place.

May 22, 1933

Floyd S. Jensen
Co. Sur.