


Record of Survey.

DESCRIPTION


Township....., North of Range.....of 4 Principal Meridian
as presented by the courses and distances on the following plat, and annexed field-notes of survey:
Established the center of the section at the point of intersection of STRAIGHT quarter lines.
Established all quarter-quarter corners upon the section boundary at proportional distances between known section and quarter section corners, according to the original field-notes of the Government survey.
Established all lost corners at proportionate distances between known corners, according to the original field notes of the Government survey.

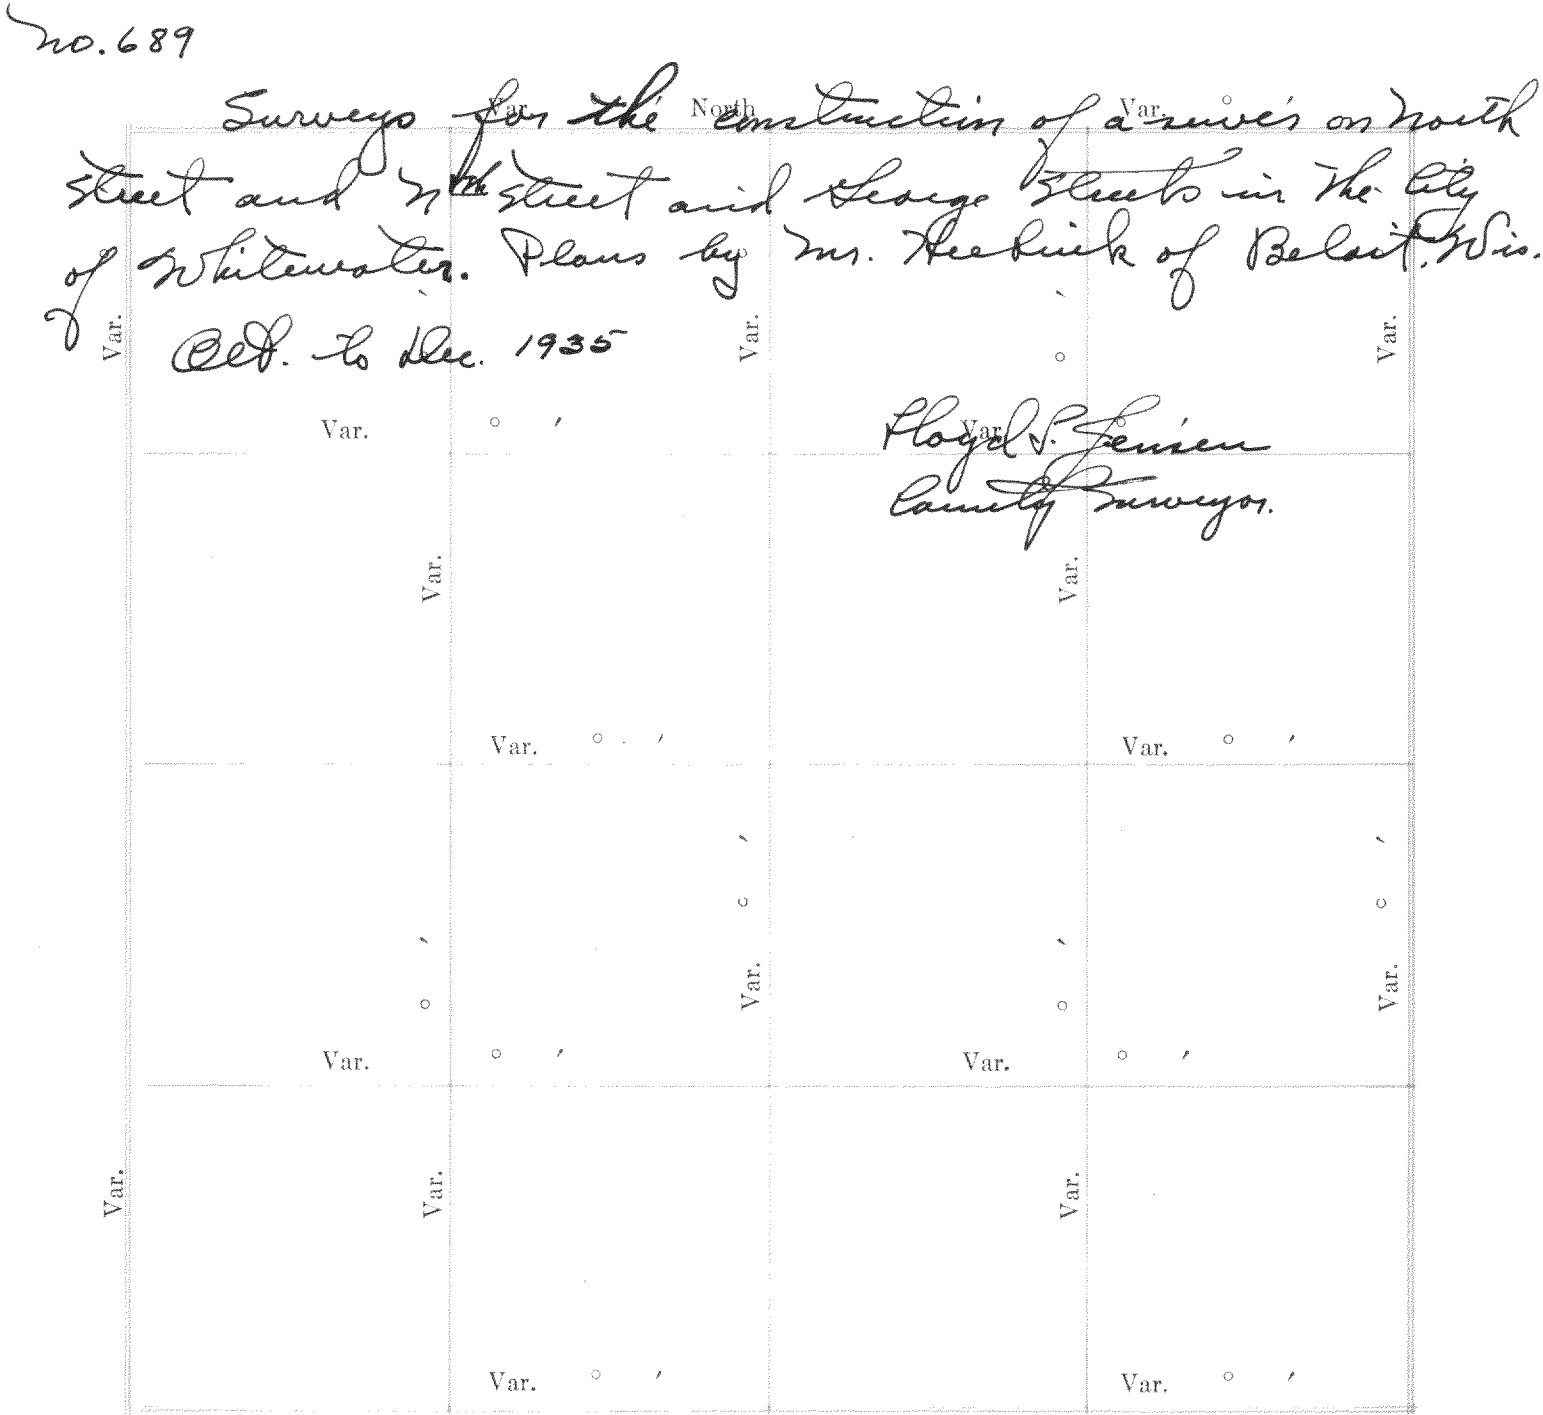

Plat of Section....., Township.....North, Range.....of 4 Principal Meridian Scale
80 chains to 6 inches. The figures in red ink are the lengths of the lines as stated in the field-notes of the Government survey.
Declination of the Magnetic Meridian from the True Meridian.....
Surveyed and sub-divided.....A. D. 1, in accordance
with the State Laws and Instructions of the Commissioner of the General Land office, and recorded on pages
.....of Register in the County Clerk's office.
Witness my hand this.....day of.....A. D. 1
.....SURVEYOR.

OF SECTION, QUARTER SECTION AND QUARTER QUARTER SECTION CORNERS

H. C. MILLER CO., MFG. STATIONERS, MILWAUKEE X15000															
GOVERNMENT CORNERS															
No.	Bearing	In.	Courses	Links	Bearing	In.	Courses	Links	Bearing	In.	Courses	Links	Bearing	In.	Courses
	Trees	Dia.	they bear	Distant	Trees	Dia.	they bear	Distant	Trees	Dia.	they bear	Distant	Trees	Dia.	they bear
No. 690 Survey in Section 36, T27N, R16E.															
1.	N. W. Sec. Cor. identified,	For N 1/4 post used round Oak post as given in Teeple's Survey, measured S. 1323.21 along fence, pt. fell on fence line E-W and center of Cor. posts.													
2.	N. E. Sec. Cor. identified,														
3.	S. E. Sec. Cor. identified,														
4.	S. W. Sec. Cor. identified,														
5.	N. 1/4 Sec. Cor. identified,	E 1/4 Cor. of 36-2-16, found Oak Stake 8" below road surface, Iron pipe driven in on top - 2 1/2' below road surface													
6.	E. 1/4 Sec. Cor. identified,														
7.	S. 1/4 Sec. Cor. identified,														
8.	W. 1/4 Sec. Cor. identified,														
Subdivision Corners															
No.															
1.	Center 1/4 Sec. Cor.														
2.	North 1/4-1/4s N. W. qr.,														
3.	East 1/4-1/4s N. W. qr.,														
4.	South 1/4-1/4s N. W. qr.,														
5.	West 1/4-1/4s N. W. qr.,														
6.	Center 1/4-1/4s N. W. qr.,														
7.	North 1/4-1/4s N. E. qr.,														
8.	East 1/4-1/4s N. E. qr.,														
9.	South 1/4-1/4s N. E. qr.,														
10.	Center 1/4-1/4s N. E. qr.,														
11.	East 1/4-1/4s S. E. qr.,														
12.	South 1/4-1/4s S. E. qr.,														
13.	West 1/4-1/4s S. E. qr.,														
14.	Center 1/4-1/4s S. E. qr.,														
15.	South 1/4-1/4s S. W. qr.,														
16.	West 1/4-1/4s S. W. qr.,														
17.	Center 1/4-1/4s S. W. qr.														

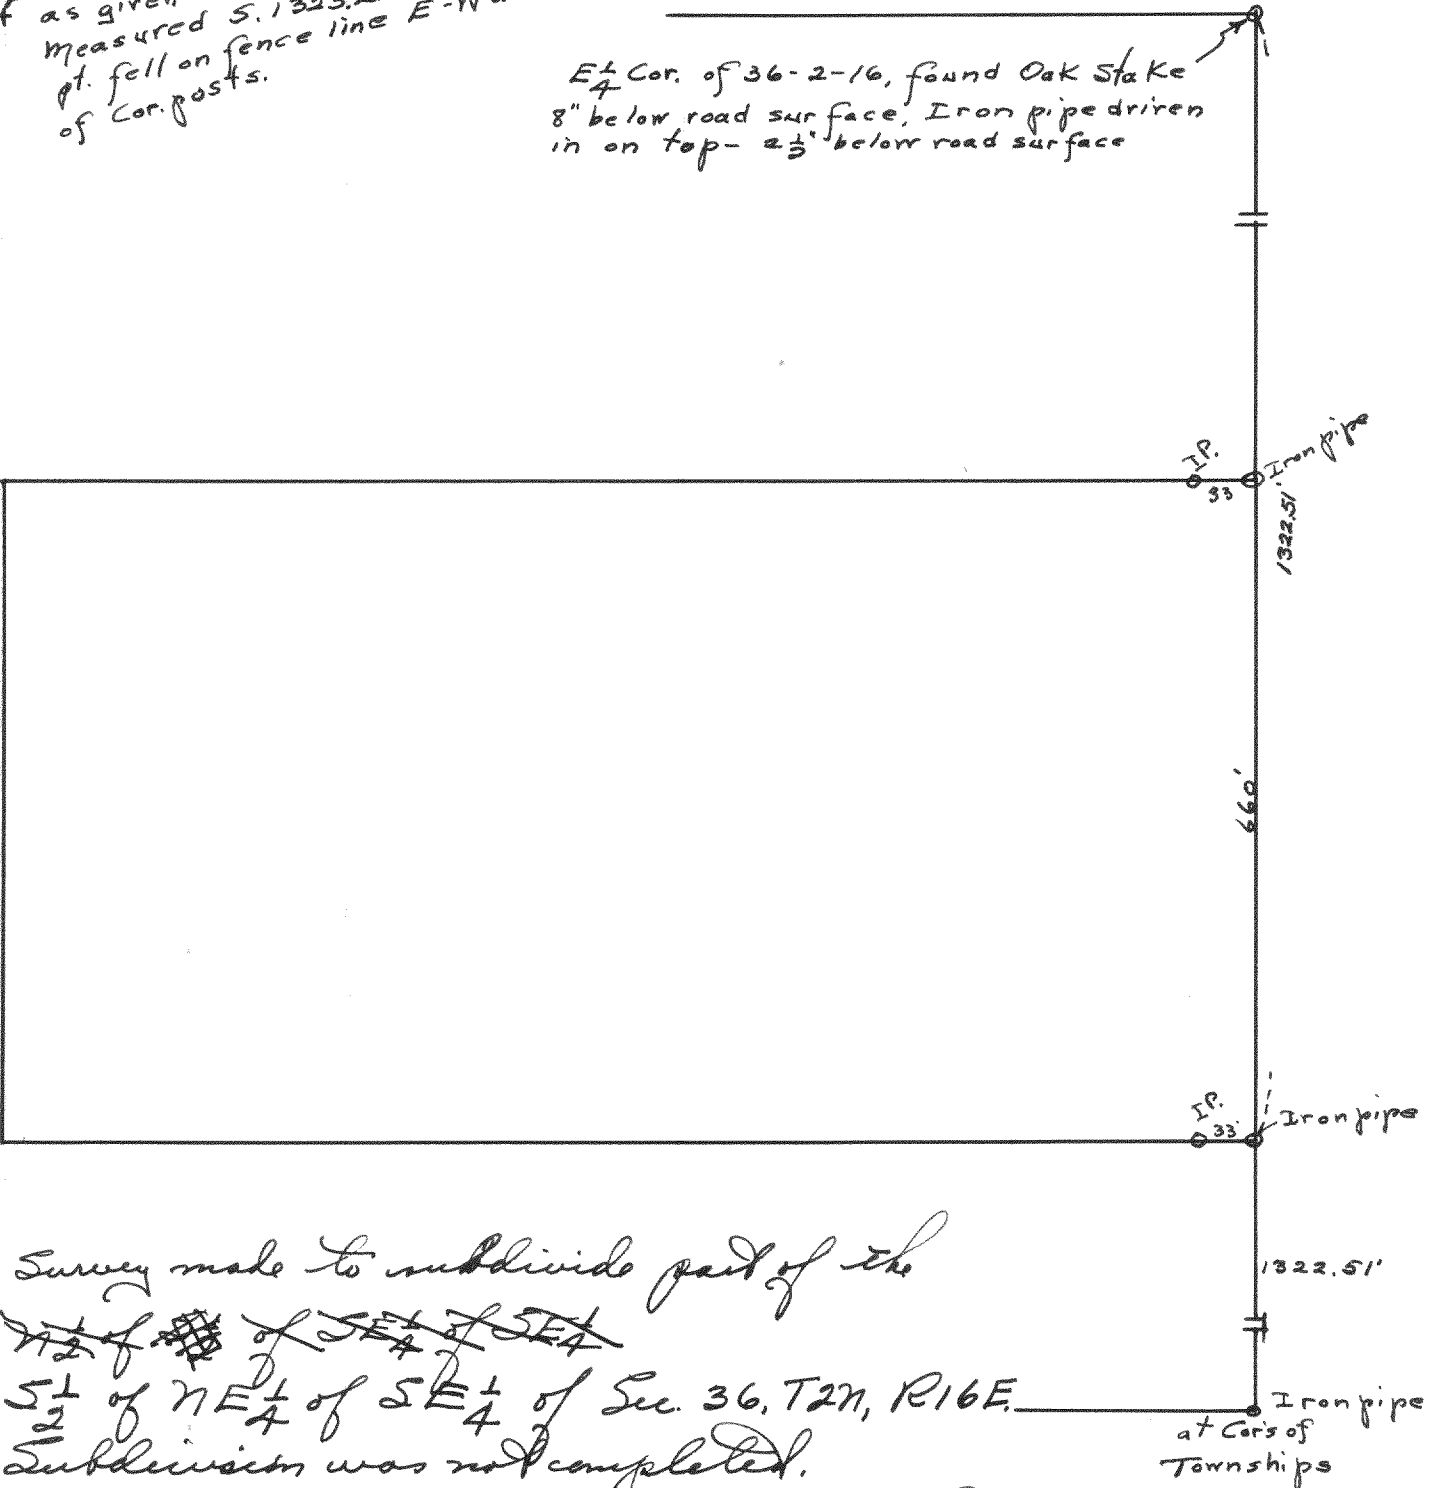

NAMES OF SWORN ASSISTANTS

CHAINMEN

FLAGMEN

AXMEN


no. 691

Survey of drainage in Section 16, T27, R17E.
Level shots were taken beginning north of school and following the present tile to a pt. South and East of said school. No grades were set for tiling.

June 6, 1935

Lloyd V. Jensen
County Surveyor

no. 692 Lots 19-20-344 of Block "11" of The Assembly Grounds
in Section 21, T27, R16E.


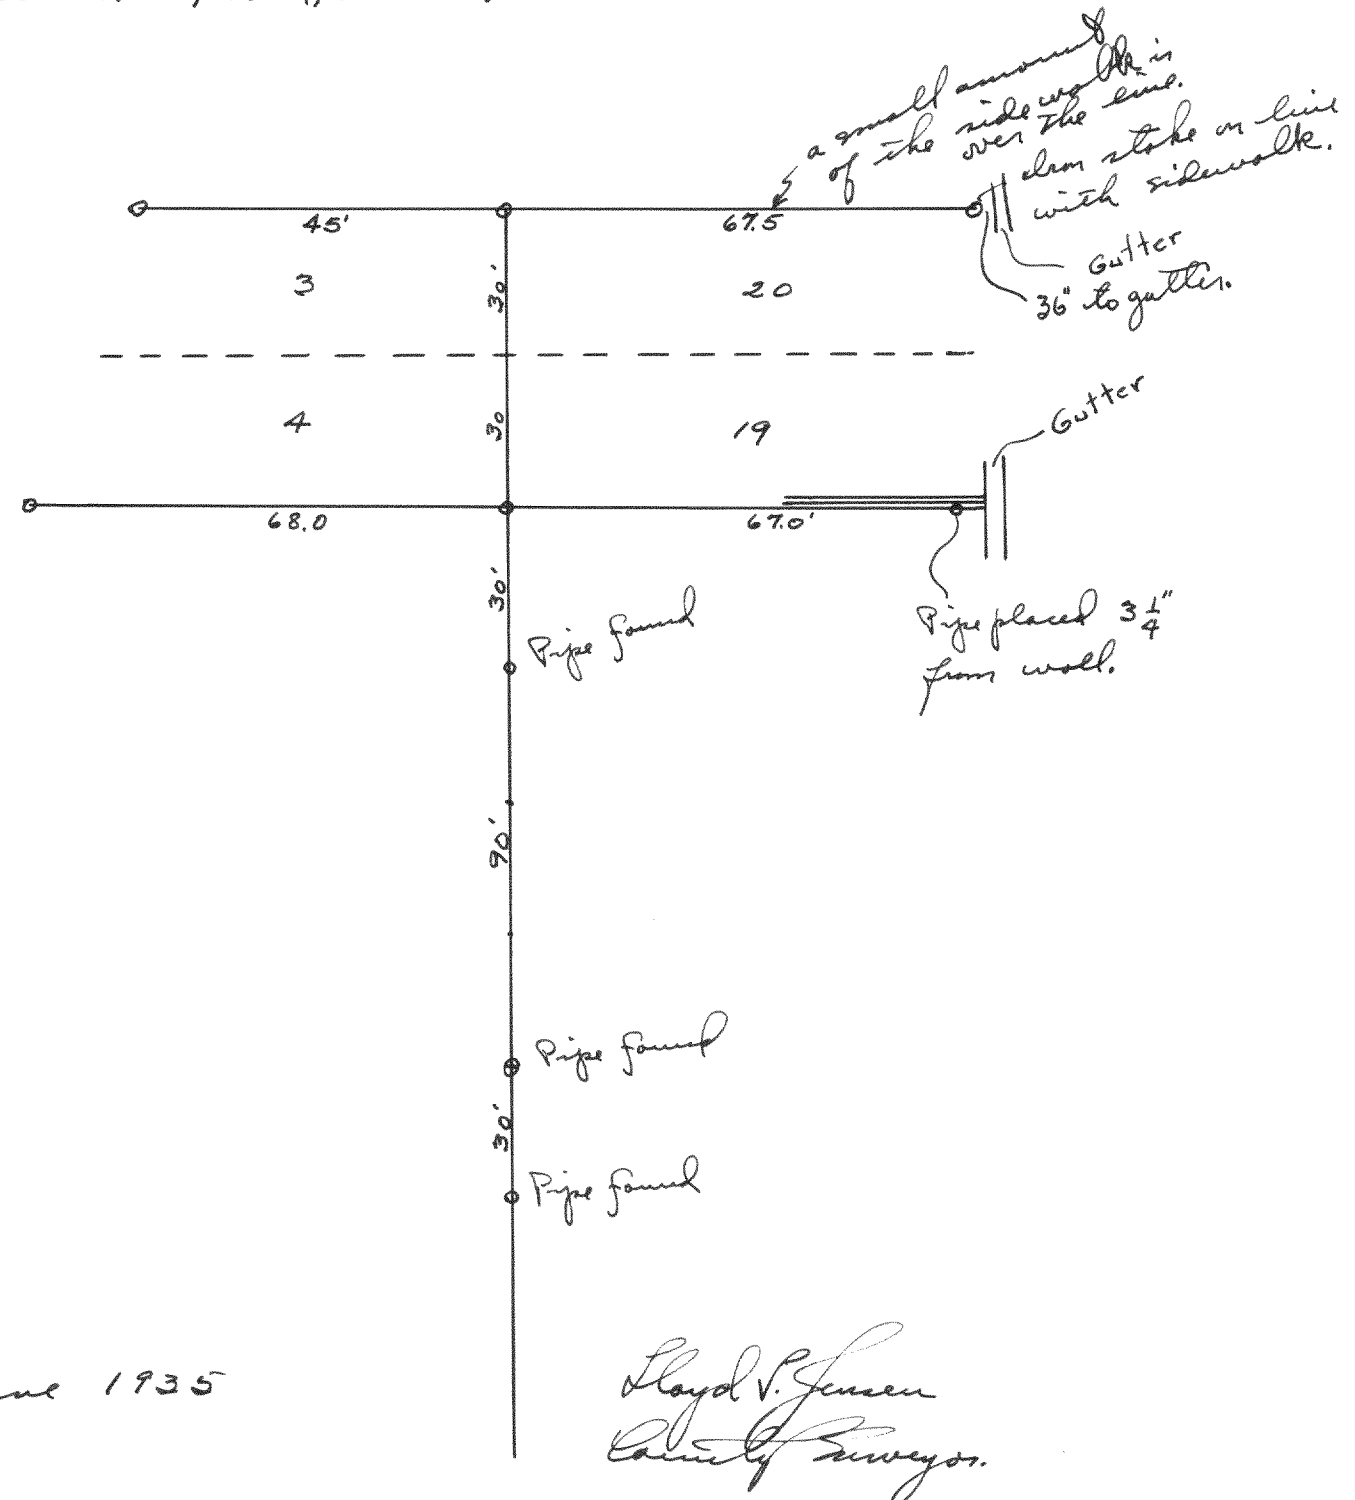


June 1935

Lloyd V. Jensen
County Surveyor

no. 693 Survey of lots
1, 2, 3 of Block (E)
and lots 15 & 16 of Block
(A) of Cisco Beach Subd.

(D)

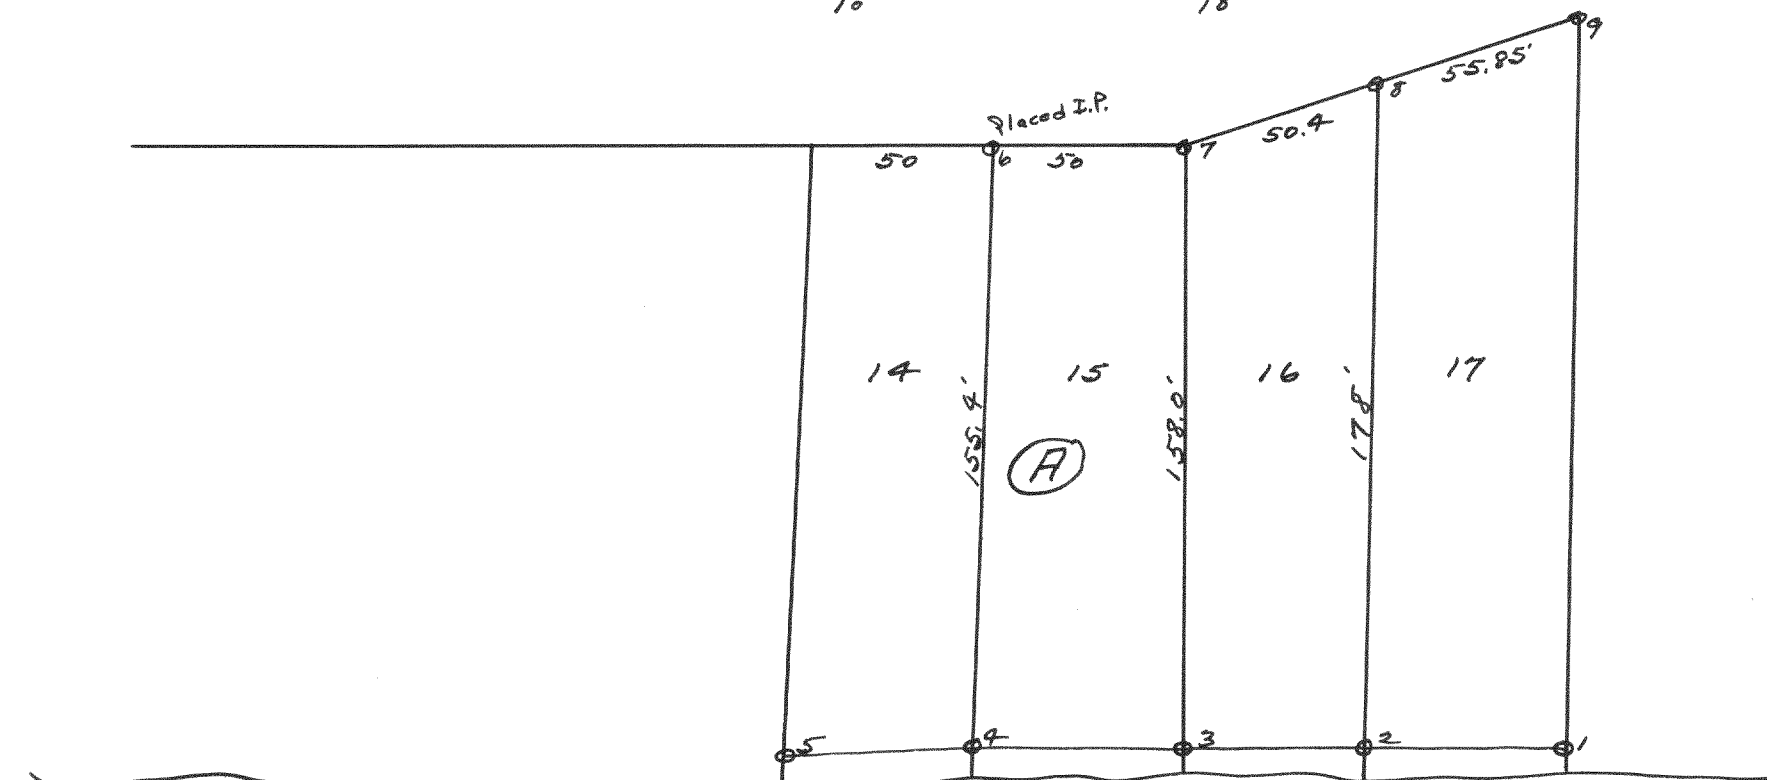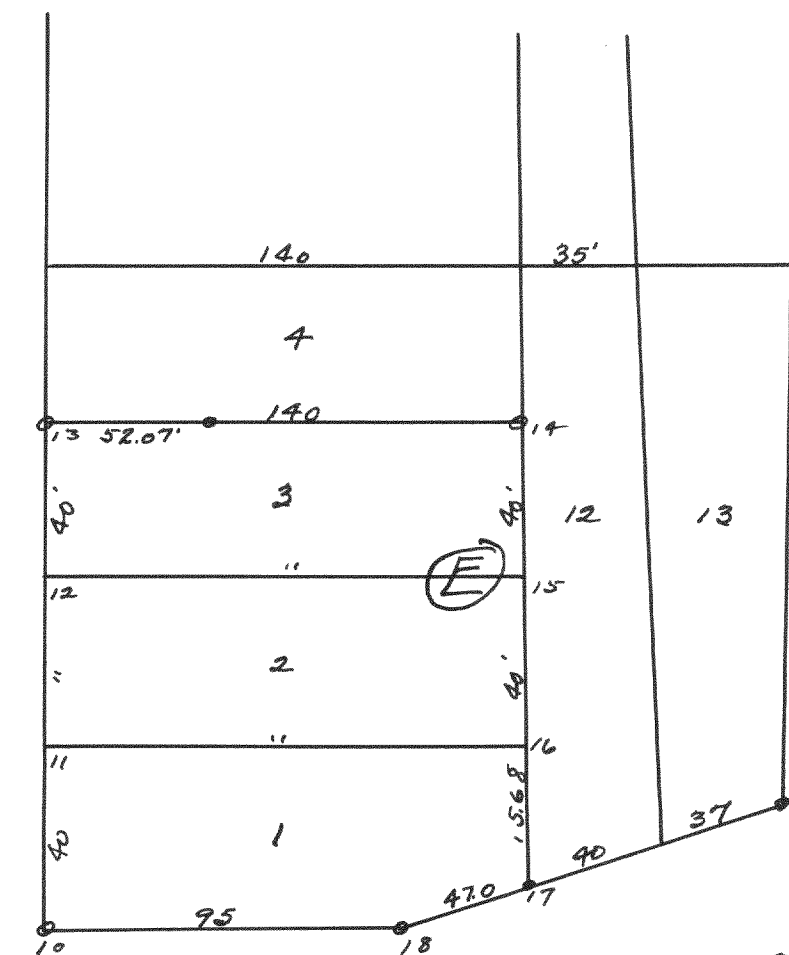

Found stakes at points marked 1, 3, 5, 7, 9, 11, 12, 13, 14, 15, 17 and 18. Placed iron pipes at points marked 2, 4, 6, 8, 10, 13, 14, 17 & 18, later these pipes were replaced with iron pipes, concrete monuments.

June 28, 1935

Lloyd V. Jensen
County Surveyor