


Record of Survey.

Township....., North of Range..... of 4 Principal Meridian  
as presented by the courses and distances on the following plat, and annexed field-notes of survey:  
Established the center of the section at the point of intersection of STRAIGHT quarter lines.  
Established all quarter-quarter corners upon the section boundary at proportional distances between known section and quarter section corners, according to the original field-notes of the Government survey.  
Established all lost corners at proportionate distances between known corners, according to the original field notes of the Government survey.

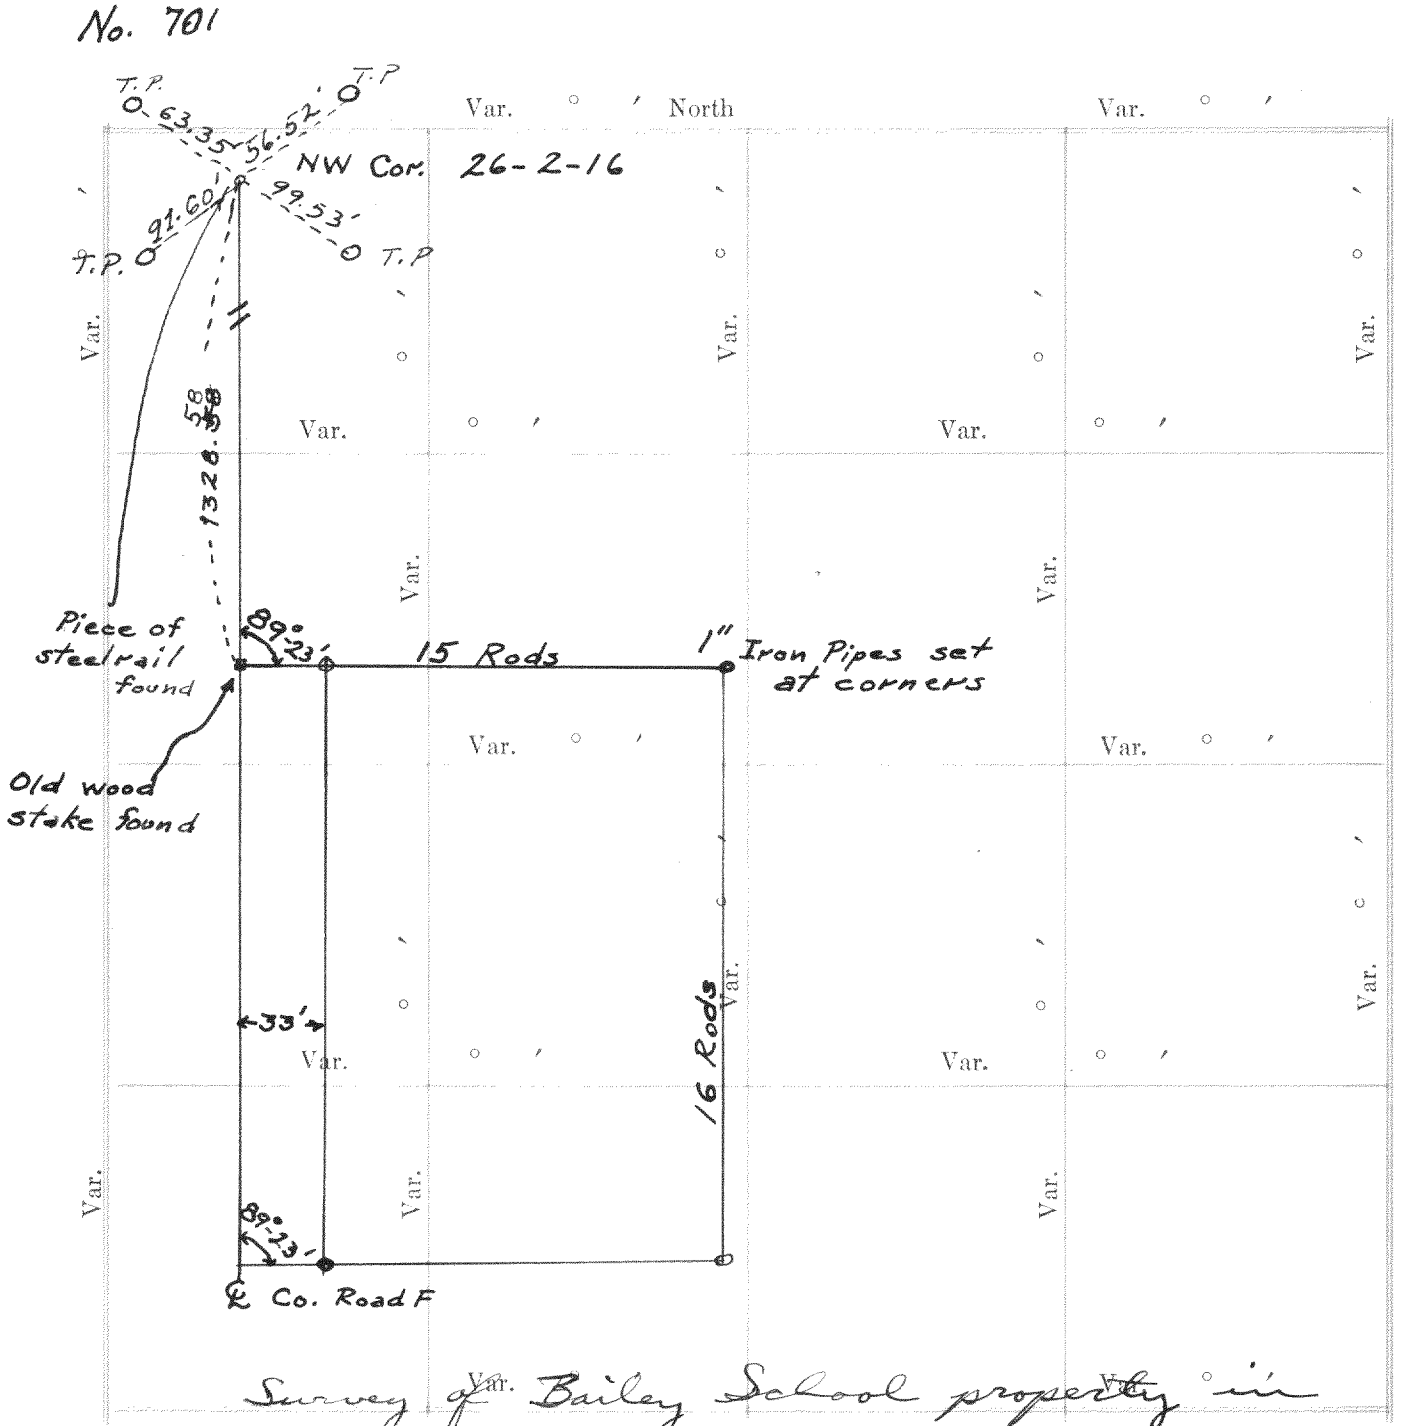

Survey of Bailey School property in Section 26, T2N, R16E.  
Plat of Section....., Township..... North, Range..... of 4 Principal Meridian Scale  
80 chains to 6 inches. The figures in red ink are the lengths of the lines as stated in the field-notes of the Government survey.  
Declination of the Magnetic Meridian from the True Meridian.....  
Surveyed and sub-divided..... A. D. 1....., in accordance  
with the State Laws and Instructions of the Commissioner of the General Land office, and recorded on pages  
..... of Register in the County Clerk's office.  
Witness my hand this..... day of..... A. D. 1.....  
..... SURVEYOR.

DESCRIPTION

OF SECTION, QUARTER SECTION AND QUARTER QUARTER SECTION CORNERS

H. C. MILLER CO. MFG. STATIONERS, MILWAUKEE WISCONSIN

GOVERNMENT CORNERS

Bearing  
Trees

In.  
Dia.

Courses  
they bear

Links  
Distant

Bearing  
Trees

In.  
Dia.

Courses  
they bear

Links  
Distant

Bearing  
Trees

In.  
Dia.

Courses  
they bear

Links  
Distant

Bearing  
Trees

In.  
Dia.

Courses  
they bear

Links  
Distant

No.

1. N. W. Sec. Cor. identified,

No. 702

2. N. E. Sec. Cor. identified,

3. S. E. Sec. Cor. identified,

4. S. W. Sec. Cor. identified,

5. N.  $\frac{1}{4}$  Sec. Cor. identified,

6. E.  $\frac{1}{4}$  Sec. Cor. identified,

7. S.  $\frac{1}{4}$  Sec. Cor. identified,

8. W.  $\frac{1}{4}$  Sec. Cor. identified,

Subdivision Corners

No.

1. Center  $\frac{1}{4}$  Sec. Cor.

2. North  $\frac{1}{4}$ - $\frac{1}{4}$ s N. W. qr.,

3. East  $\frac{1}{4}$ - $\frac{1}{4}$ s N. W. qr.,

4. South  $\frac{1}{4}$ - $\frac{1}{4}$ s N. W. qr.,

5. West  $\frac{1}{4}$ - $\frac{1}{4}$ s N. W. qr.,

6. Center  $\frac{1}{4}$ - $\frac{1}{4}$ s N. W. qr.,

7. North  $\frac{1}{4}$ - $\frac{1}{4}$ s N. E. qr.,

8. East  $\frac{1}{4}$ - $\frac{1}{4}$ s N. E. qr.,

9. South  $\frac{1}{4}$ - $\frac{1}{4}$ s N. E. qr.,

10. Center  $\frac{1}{4}$ - $\frac{1}{4}$ s N. E. qr.,

11. East  $\frac{1}{4}$ - $\frac{1}{4}$ s S. E. qr.,

12. South  $\frac{1}{4}$ - $\frac{1}{4}$ s S. E. qr.,

13. West  $\frac{1}{4}$ - $\frac{1}{4}$ s S. E. qr.,

14. Center  $\frac{1}{4}$ - $\frac{1}{4}$ s S. E. qr.,

15. South  $\frac{1}{4}$ - $\frac{1}{4}$ s S. W. qr.,

16. West  $\frac{1}{4}$ - $\frac{1}{4}$ s S. W. qr.,


17. Center  $\frac{1}{4}$ - $\frac{1}{4}$ s S. W. qr.

Survey of Amerpohl property for Everett Doyle  
which commences at the Northeast corner of  
Section 27, T2N, R16E, of Walworth County  
Wisconsin; thence S 0°-36' W along the East line  
of said Section 2196.63 feet to a point; thence  
N 89°-53' W 1854.0 feet to an iron pipe at the  
place of beginning; thence N 0°-07' E 1220.32 feet;  
thence S 89°-18' W 290.62 feet to a point in  
the center of Public road; thence S 49°-00' W  
50.0 feet along the center line of said road;  
thence N 89°-18' E 145.0 feet, thence due South  
127.10 feet; thence S 49°-00' W 1617.98 feet; thence  
N 89°-53' E 1402.87' to the place of beginning  
containing 20.02 acres of land.

September 1936


Lloyd L. Jensen  
Co. Surveyor  
Recorded by W. E. H.

No. 703

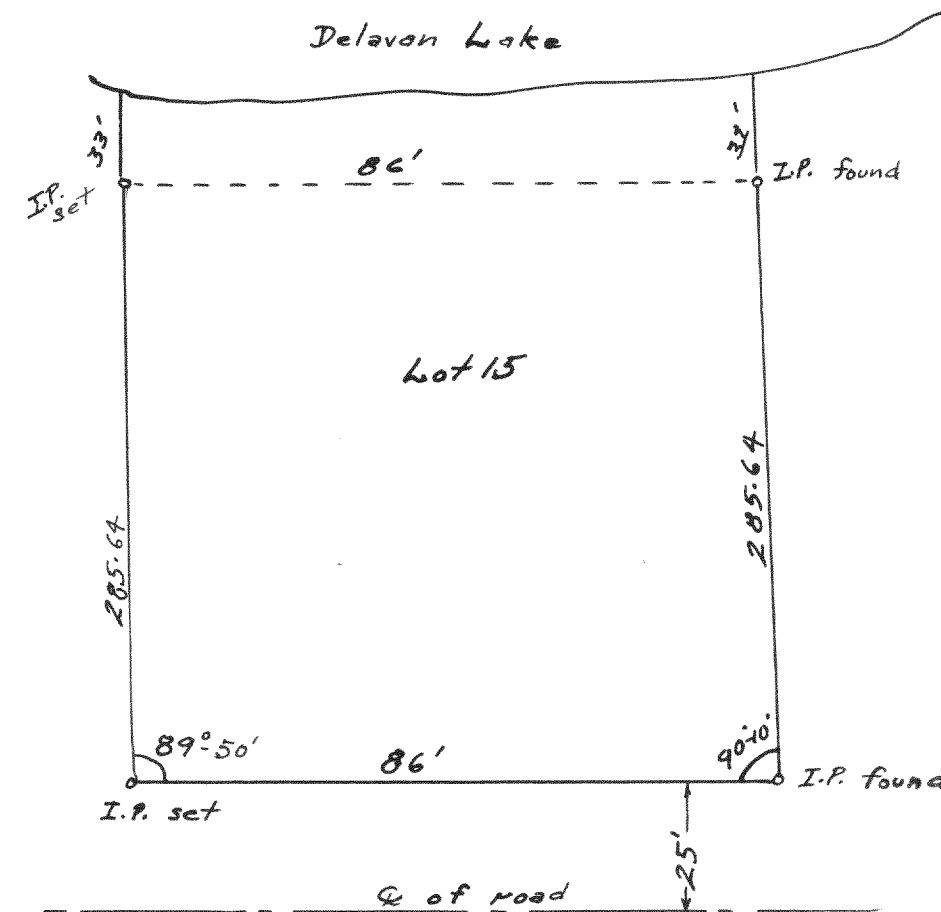

Survey of the southerly 86 feet  
of Lot 15 of Belrock Subdivision,  
for Belrock Sportsmen's Association  
September, 1936 Lloyd L. Jensen  
Co. Surveyor  
Recorded by W. E. H.

No. 703a

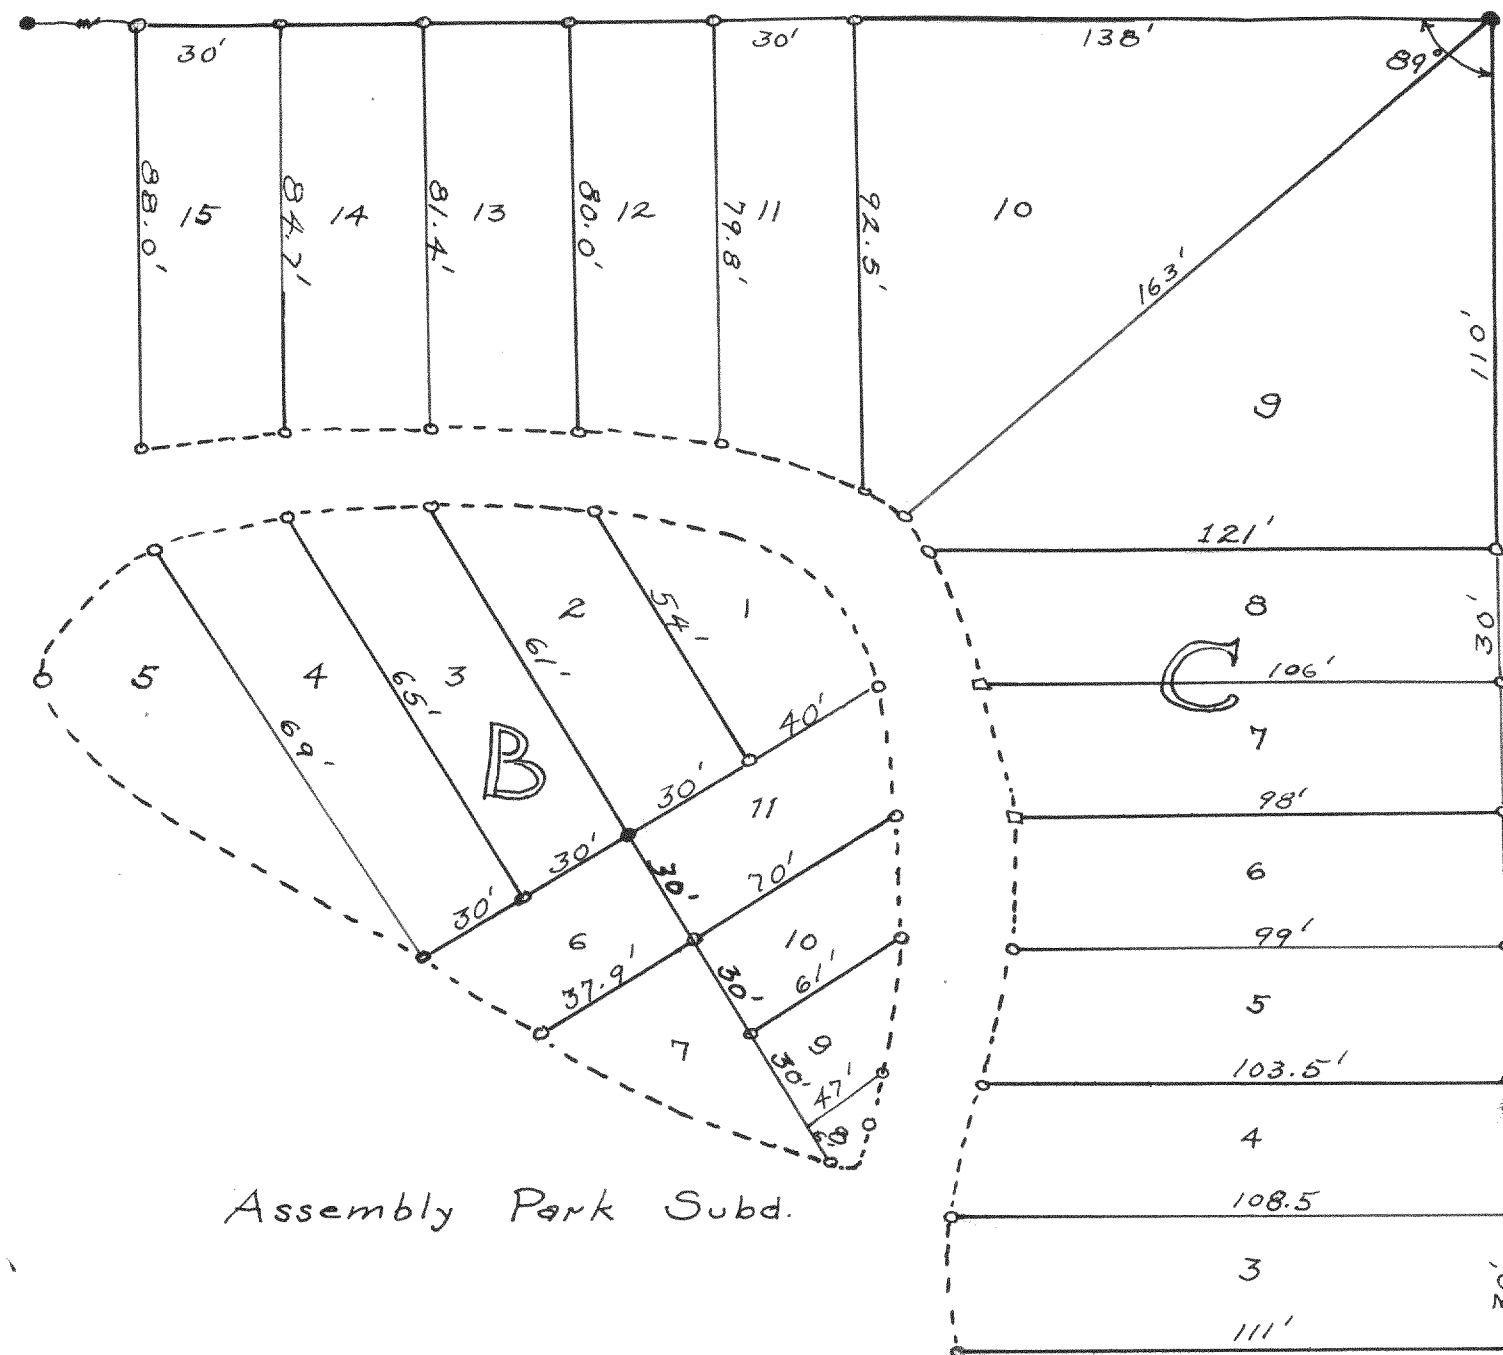

• Iron pipes found  
o " " set  
□ Wood stakes or  
mark found.

Assembly Park Subd.

Survey for Assembly Park Association.

Lots 3-15 inclusive in Block C were surveyed and Block B  
was laid out for park purposes as shown by taking 5' from  
all the lots thus making the road around Block B 20' wide.  
It was formerly 15' wide.

Sept. 1936

Lloyd L. Jensen  
Co. Surveyor  
Recorded by W. E. H.