

Record of Survey.


Township....., North of Range.....of 4 Principal Meridian
as presented by the courses and distances on the following plat, and annexed field-notes of survey:

Established the center of the section at the point of intersection of STRAIGHT quarter lines.

Established all quarter-quarter corners upon the section boundary at proportional distances between known section and quarter section corners, according to the original field-notes of the Government survey.

Established all lost corners at proportionate distances between known corners, according to the original field notes of the Government survey.

No. 704

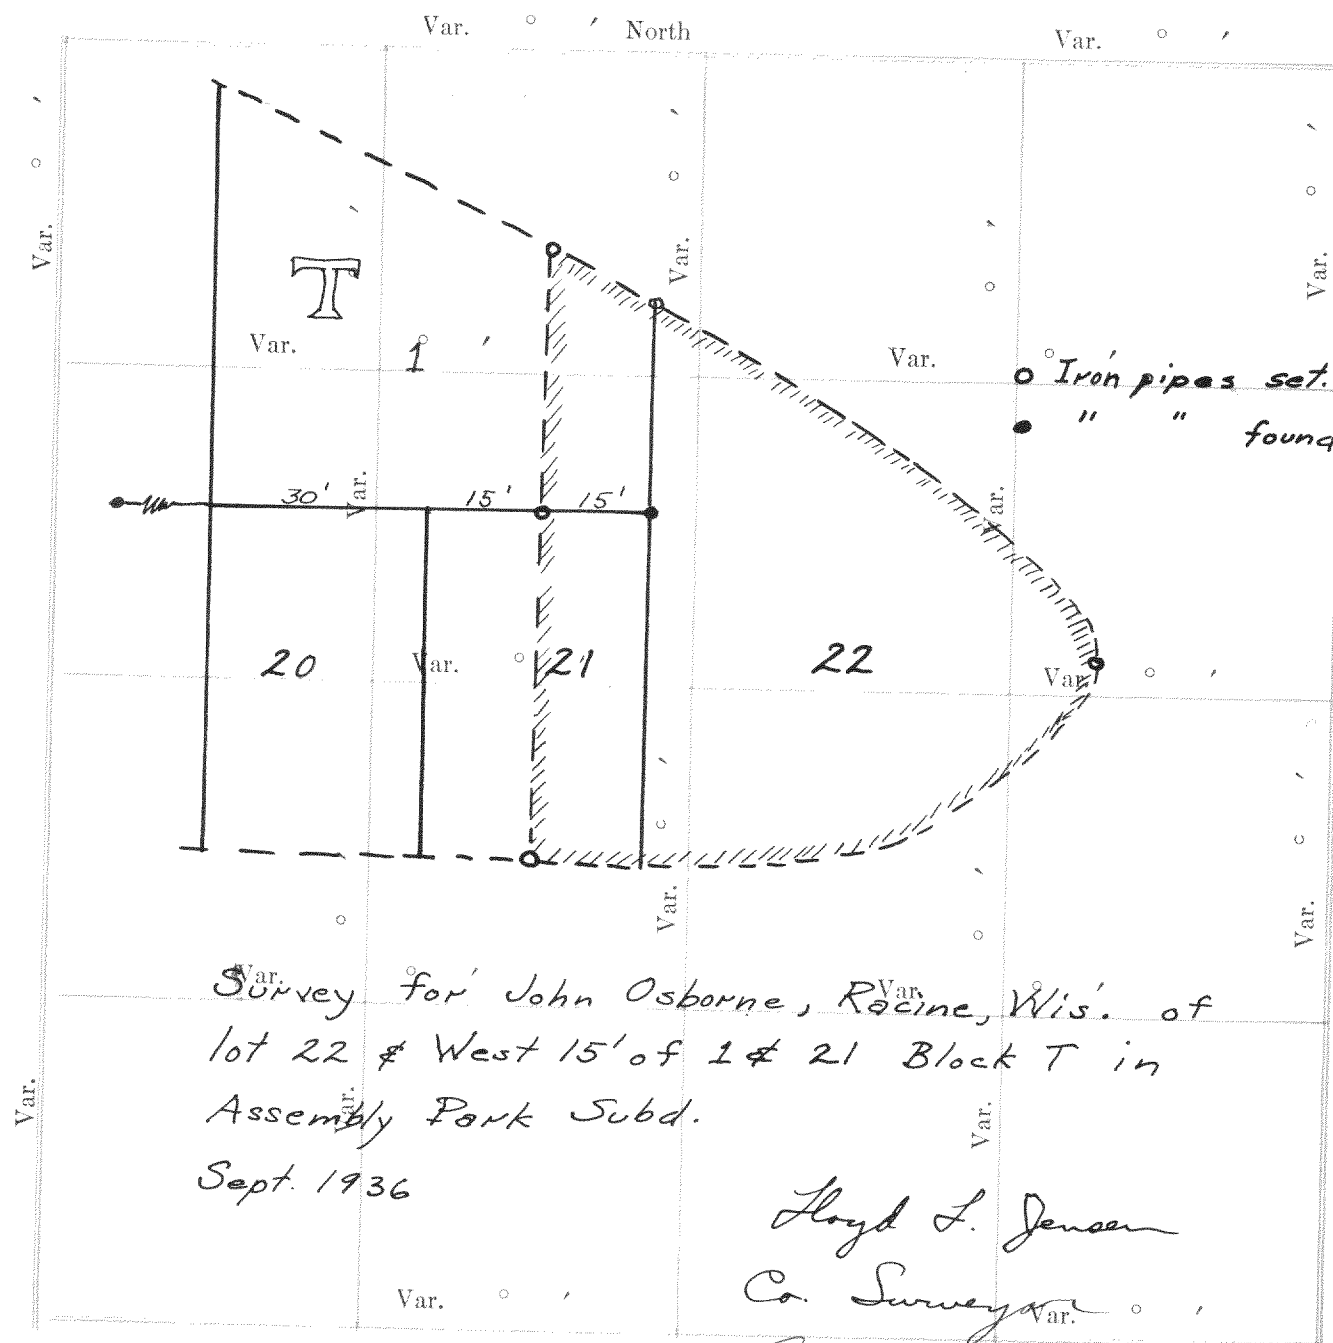

Plat of Section....., Township..... North, Range..... of 4 Principal Meridian Scale
80 chains to 6 inches. The figures in red ink are the lengths of the lines as stated in the field-notes of the
Government survey.

Declination of the Magnetic Meridian from the True Meridian.....

Surveyed and sub-divided.....A. D. 1 , in accordance
with the State Laws and Instructions of the Commissioner of the General Land office, and recorded on pages
.....of Register in the County Clerk's office.

Witness my hand this.....day of.....A. D. 1

...SURVEYOR.

DESCRIPTION

227

OF SECTION, QUARTER SECTION AND QUARTER QUARTER SECTION CORNERS

GOVERNMENT CORNERS

No.	Bearing	In. Dia.	Courses they bear	Links Distant	Bearing	In. Dia.	Courses they bear	Links Distant	Bearing	In. Dia.	Courses they bear	Links Distant
1.	N. W.	Sec. Cor.	identified,									
2.	N. E.	Sec. Cor.	identified,									
3.	S. E.	Sec. Cor.	identified,									
4.	S. W.	Sec. Cor.	identified,									
5.	N. $\frac{1}{4}$ Sec. Cor.	identified,										
6.	E. $\frac{1}{4}$ Sec. Cor.	identified,										
7.	S. $\frac{1}{4}$ Sec. Cor.	identified,										
8.	W. $\frac{1}{4}$ Sec. Cor.	identified,										

Subdivision Corners

No.	Center $\frac{1}{4}$ Sec. Cor.	North $\frac{1}{4}$ - $\frac{1}{4}$ s N. W. qr.,	East $\frac{1}{4}$ - $\frac{1}{4}$ s N. W. qr.,	South $\frac{1}{4}$ - $\frac{1}{4}$ s N. W. qr.,	West $\frac{1}{4}$ - $\frac{1}{4}$ s N. W. qr.,	Center $\frac{1}{4}$ - $\frac{1}{4}$ s N. W. qr.,	North $\frac{1}{4}$ - $\frac{1}{4}$ s N. E. qr.,	East $\frac{1}{4}$ - $\frac{1}{4}$ s N. E. qr.,	South $\frac{1}{4}$ - $\frac{1}{4}$ s N. E. qr.,	Center $\frac{1}{4}$ - $\frac{1}{4}$ s N. E. qr.,	East $\frac{1}{4}$ - $\frac{1}{4}$ s S. E. qr.,	South $\frac{1}{4}$ - $\frac{1}{4}$ s S. E. qr.,	West $\frac{1}{4}$ - $\frac{1}{4}$ s S. E. qr.,	Center $\frac{1}{4}$ - $\frac{1}{4}$ s S. E. qr.,	South $\frac{1}{4}$ - $\frac{1}{4}$ s S. W. qr.,	West $\frac{1}{4}$ - $\frac{1}{4}$ s S. W. qr.,	Center $\frac{1}{4}$ - $\frac{1}{4}$ s S. W. qr.
1.	Center $\frac{1}{4}$ Sec. Cor.																
2.	North $\frac{1}{4}$ - $\frac{1}{4}$ s N. W. qr.,																
3.	East $\frac{1}{4}$ - $\frac{1}{4}$ s N. W. qr.,																
4.	South $\frac{1}{4}$ - $\frac{1}{4}$ s N. W. qr.,																
5.	West $\frac{1}{4}$ - $\frac{1}{4}$ s N. W. qr.,																
6.	Center $\frac{1}{4}$ - $\frac{1}{4}$ s N. W. qr.,																
7.	North $\frac{1}{4}$ - $\frac{1}{4}$ s N. E. qr.,																
8.	East $\frac{1}{4}$ - $\frac{1}{4}$ s N. E. qr.,																
9.	South $\frac{1}{4}$ - $\frac{1}{4}$ s N. E. qr.,																
10.	Center $\frac{1}{4}$ - $\frac{1}{4}$ s N. E. qr.,																
11.	East $\frac{1}{4}$ - $\frac{1}{4}$ s S. E. qr.,																
12.	South $\frac{1}{4}$ - $\frac{1}{4}$ s S. E. qr.,																
13.	West $\frac{1}{4}$ - $\frac{1}{4}$ s S. E. qr.,																
14.	Center $\frac{1}{4}$ - $\frac{1}{4}$ s S. E. qr.,																
15.	South $\frac{1}{4}$ - $\frac{1}{4}$ s S. W. qr.,																
16.	West $\frac{1}{4}$ - $\frac{1}{4}$ s S. W. qr.,																
17.	Center $\frac{1}{4}$ - $\frac{1}{4}$ s S. W. qr.																


Survey of lot 55, Block C of
Cisco Beach Subd. for L. C. Schuster of
Chicago, Illinois.

Sept. 1936

Lloyd L. Jensen
C. Surveyor
Recorded by W. C. H.

0 Iron pipes se
• " pins found

Cisco Beach Subd.

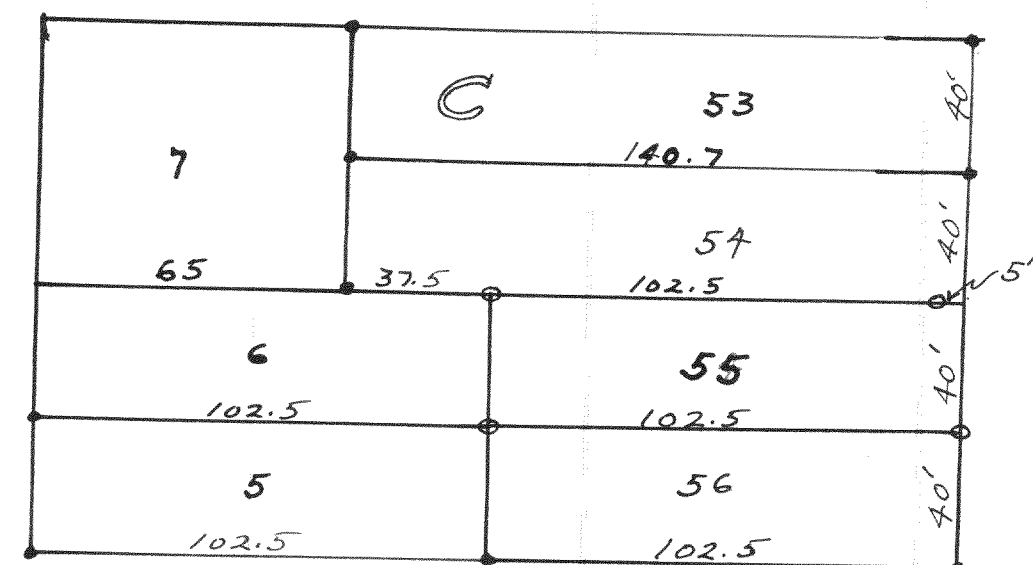

- o Iron pipes set
- " pins found

Survey of Lot 55, Block C of
Cisao Beach Subd. for L. C. Schuster of
Chicago, Illinois.

Sept. 1936

Lloyd L. Jensen
C. Surveyor
Recorded by W. E. H.


NAMES OF SWORN ASSISTANTS

CHAINMEN

FLAGMEN

AXMEN

No. 706

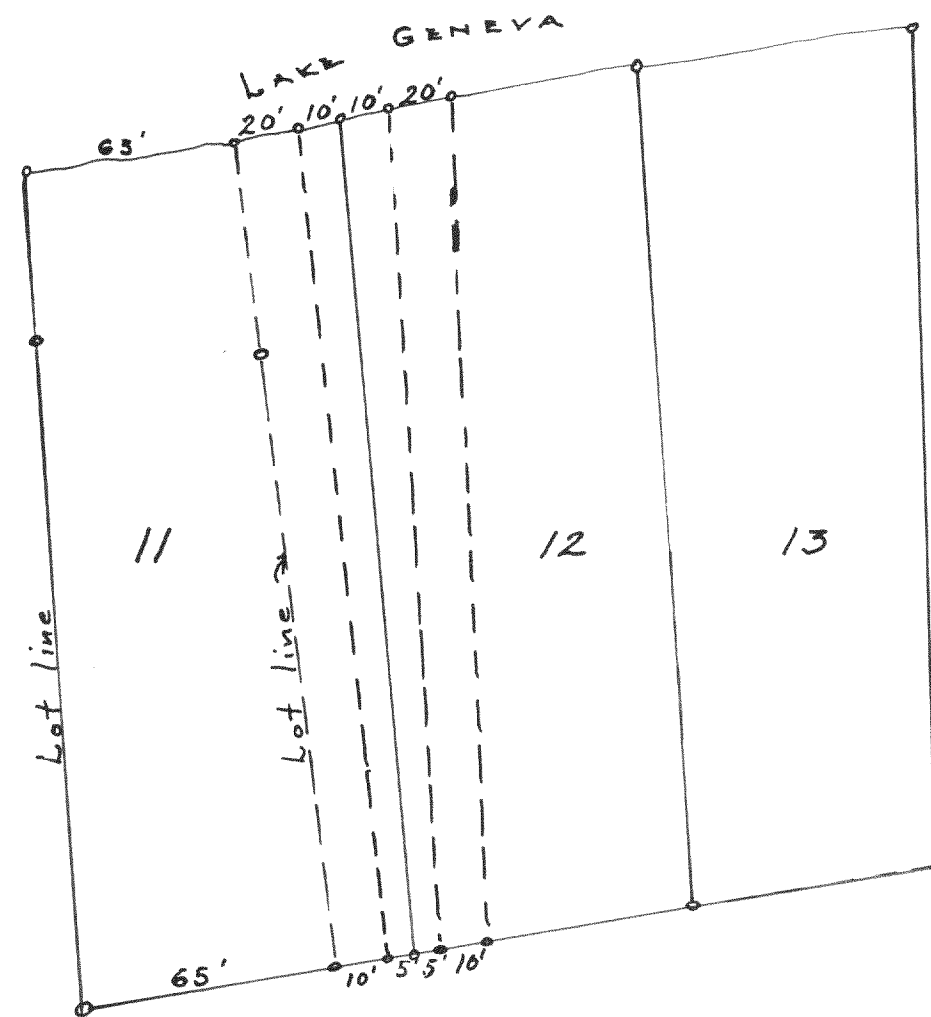

Woodale Add. Block 1

Survey of lot 11, Block 1 for
Arthur B. Jensen with right of ways
taken off lots 11 & 12 as shown
by dotted lines.

Sept. 29, 1936

Lloyd L. Jensen
Co. Surveyor
Recorded by W.E.H.

No. 706 a

Woodale Add - Lake Geneva



Survey of Lot 26, Block 3 for Arthur B. Jensen
Sept. 29, 1936

Lloyd L. Jensen
Co. Surveyor
Recorded by W.E.H.